


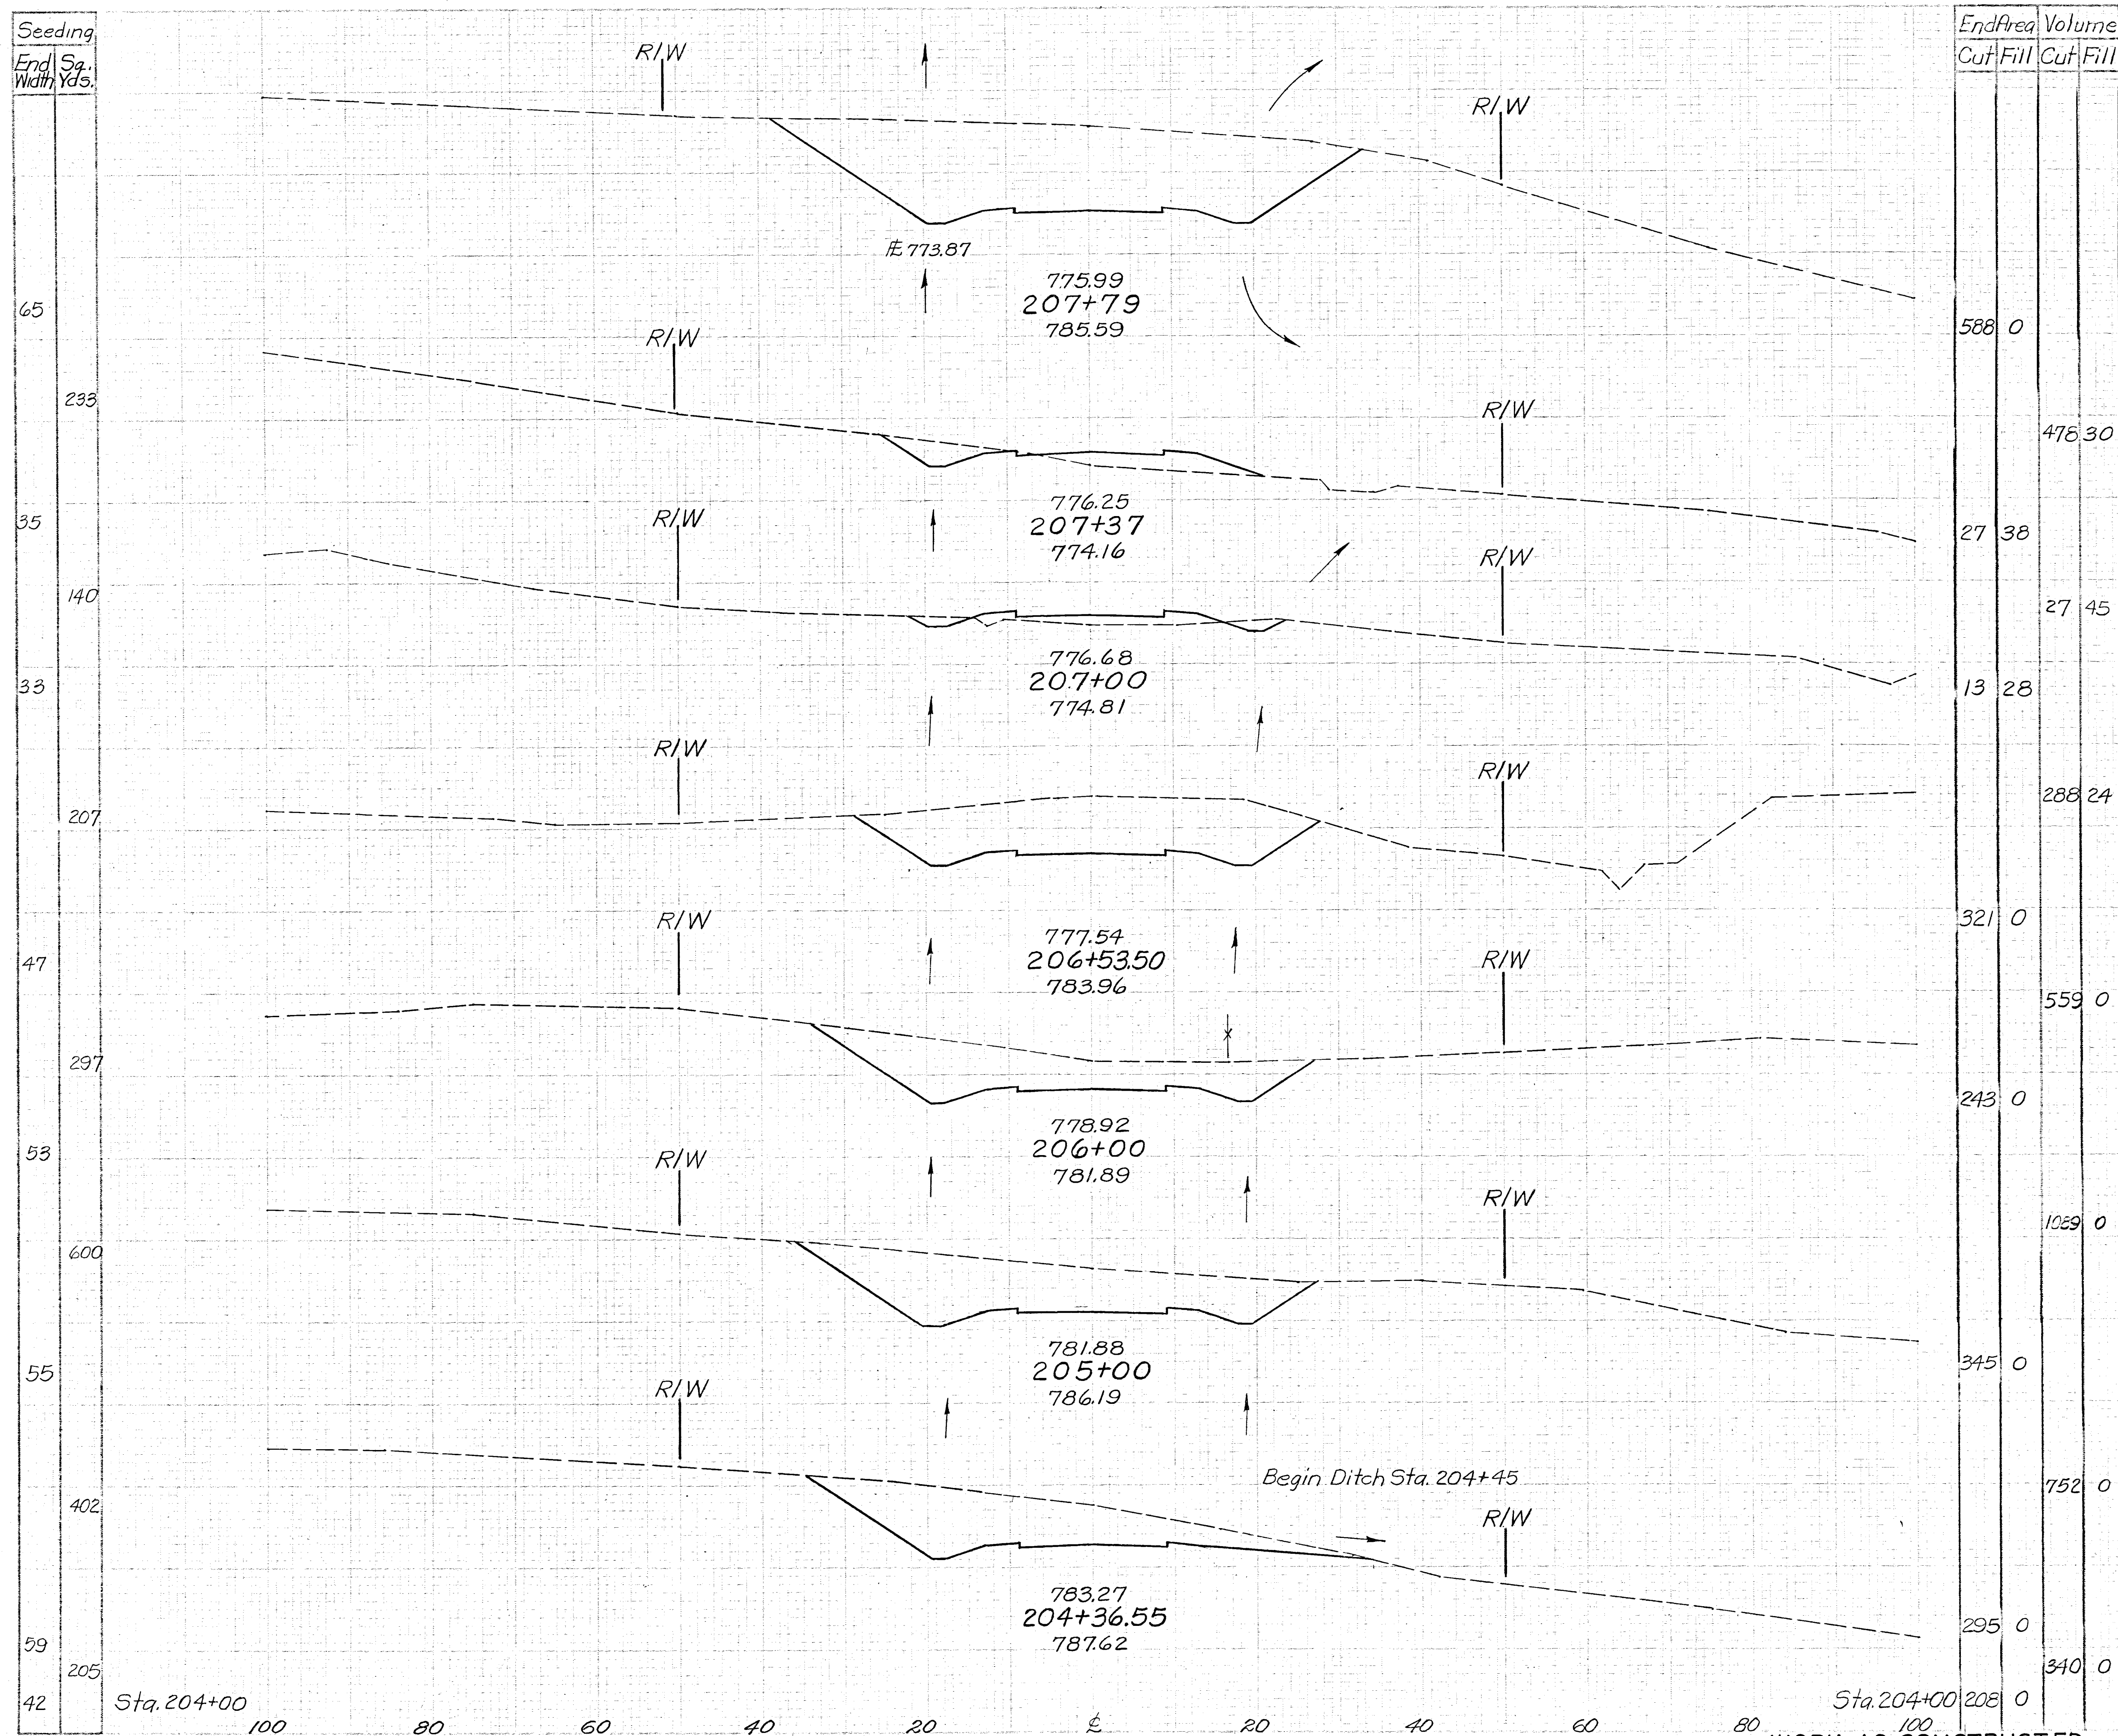

	3/23/62	AS CONSTRUCTED	H.F. K.
REVISION	DATE	DESCRIPTION	BY
U. S. ARMY ENGINEER DISTRICT, HUNTINGTON CORPS OF ENGINEERS HUNTINGTON, W. VA.			
DRAWN BY: <i>EER</i> TRACED BY: CHECKED BY: <i>F.H.L.</i> SUBMITTED BY: <i>Elmer S. Barrett</i> ELMER S. BARRETT ASSOCIATES RECOMMENDED: <i>James Barrett</i> CHIEF ENG. DIV.		LICKING RIVER DILLON RESERVOIR PROJECT RELOCATION OF MUSKINGUM COUNTY ROAD NO. 8 MC-8-4 & MT-408-1 MC-8-1 & MC-408-1 APPROVED: <i>Steven M. Malovich</i> DATE: NOVEMBER 1959 COL. C.E. DISTRICT ENGINEER	
ELMER S. BARRETT ASSOCIATES CONSULTING ENGINEERS CHILLICOTHE, OHIO		SCALE: 1"=10' DRAWING NUMBER 027f-UD 14-68/51 SHEET 51 OF 83	