


Seeding	End Sq. Width Yds
0	69
89	277
77	462
57	146
42	228
63	198
56	427
65	

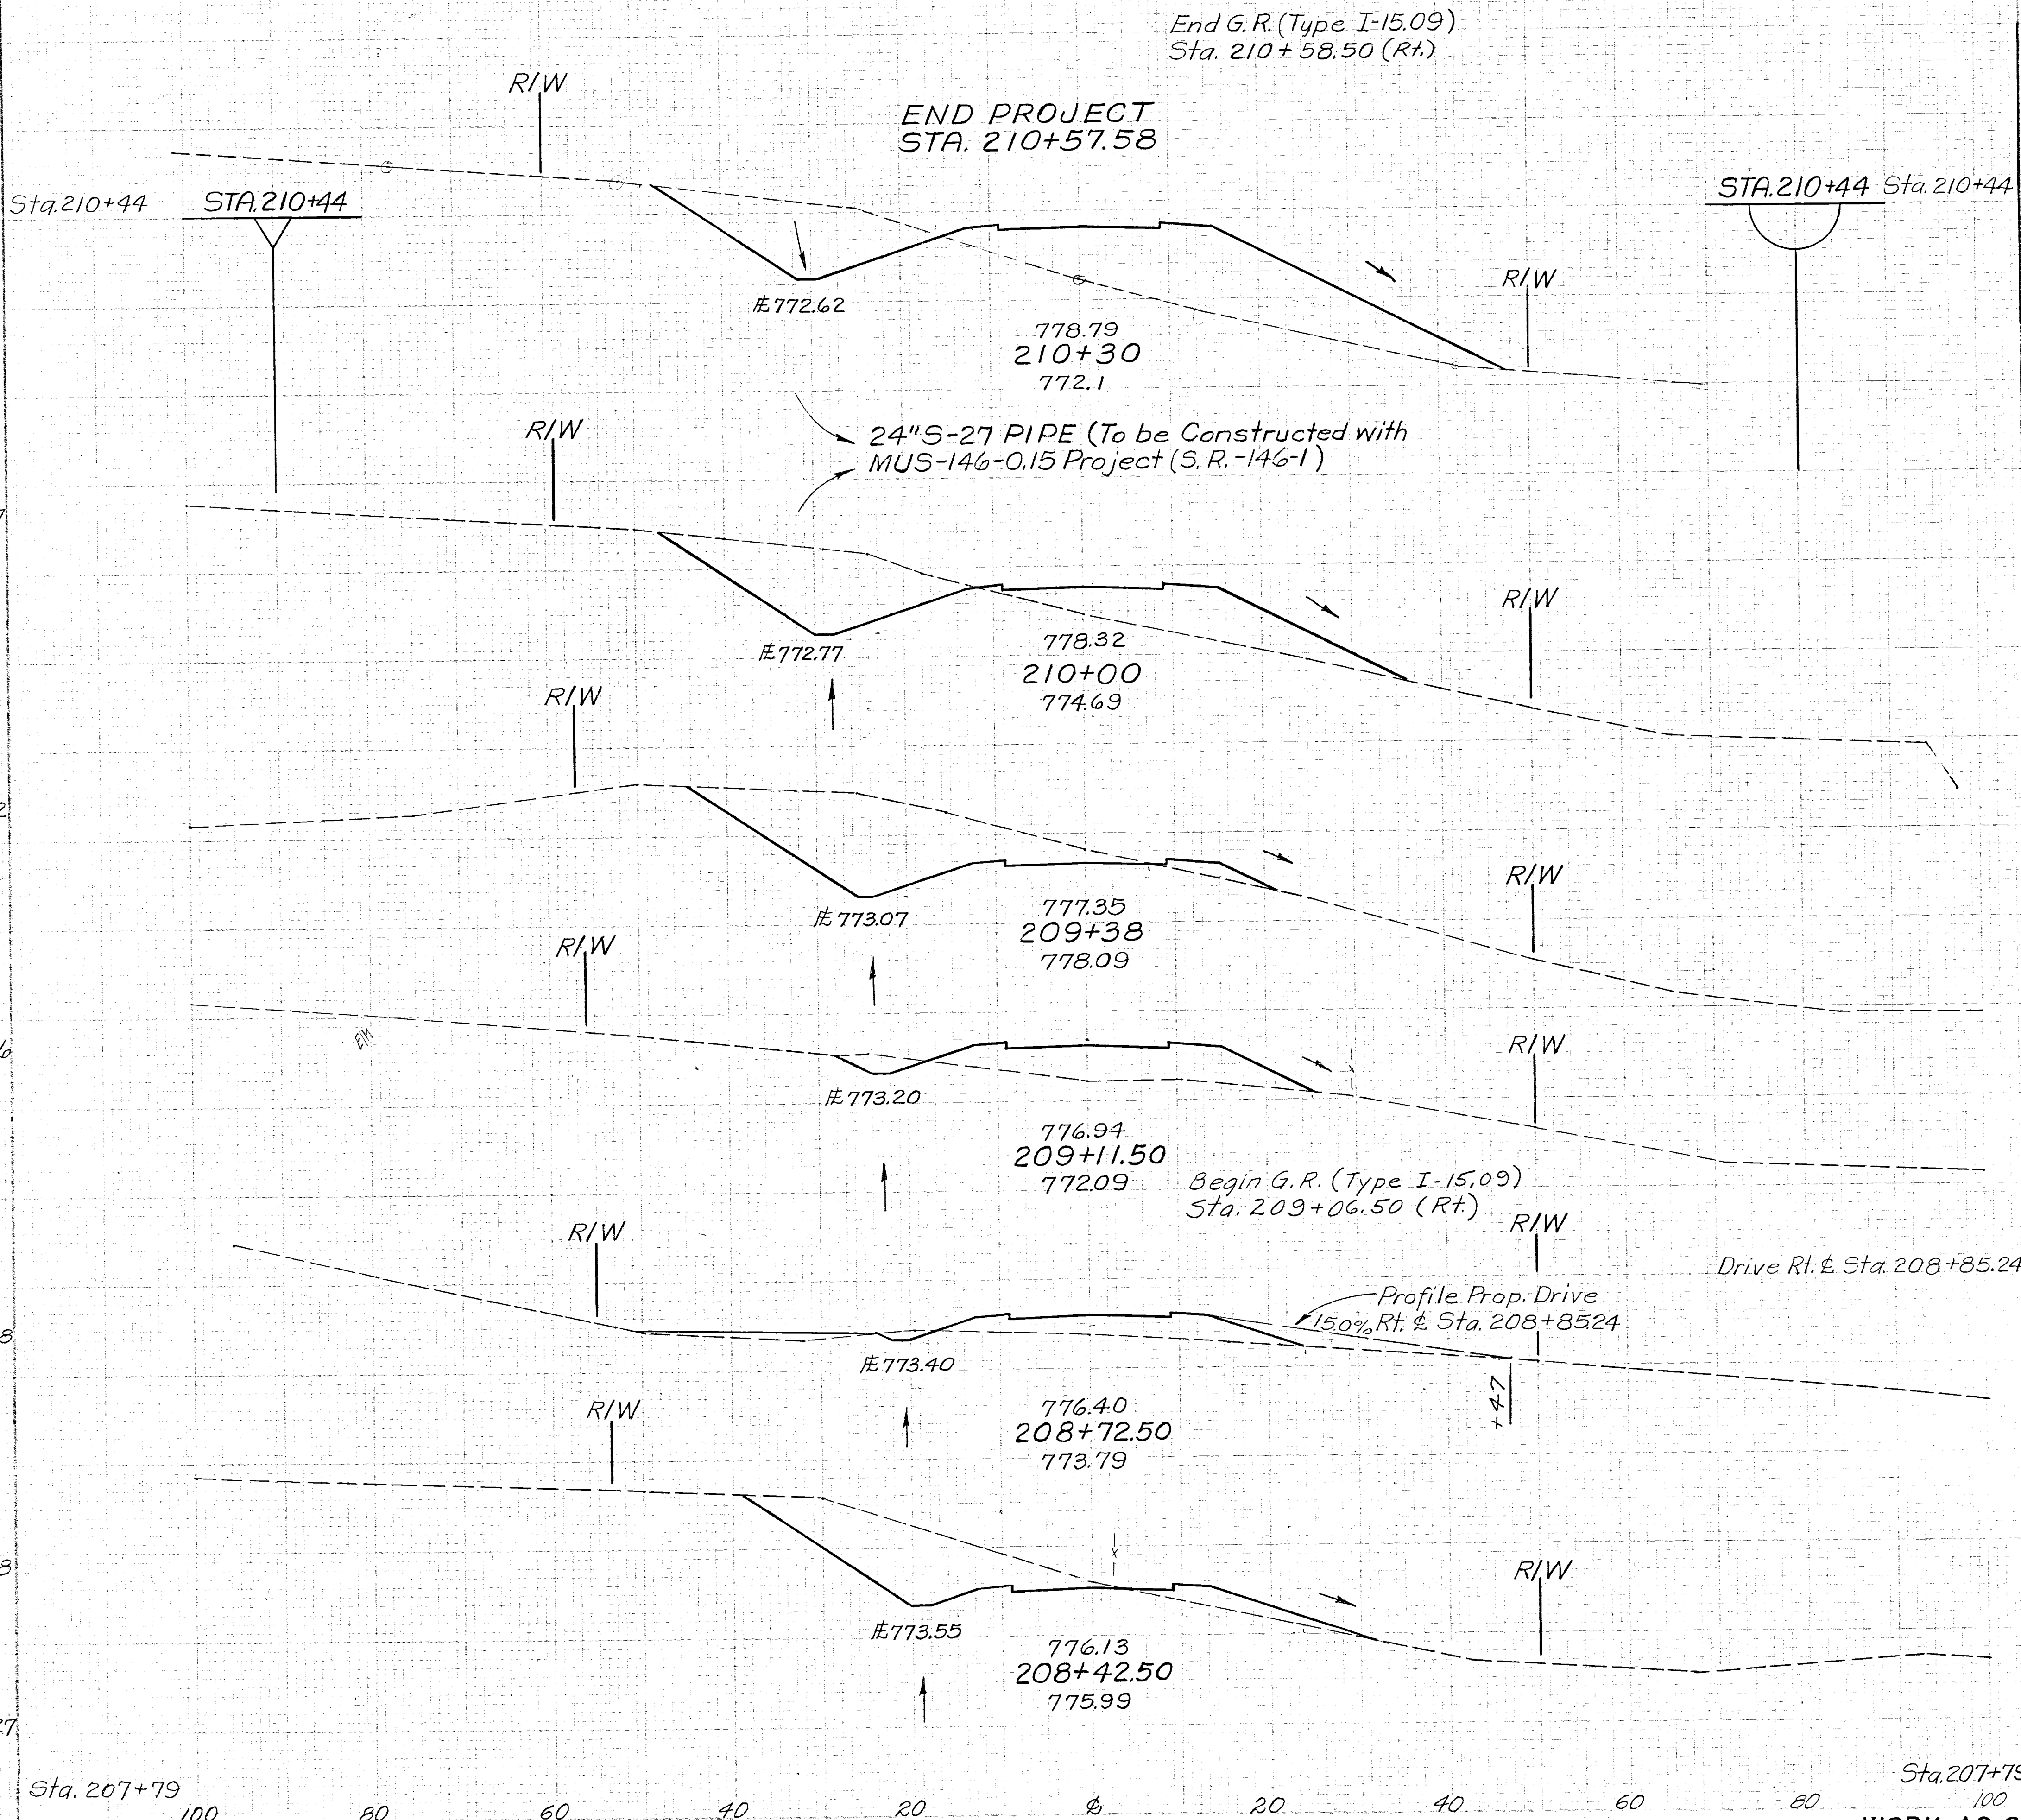

End Area	Volume
Cut	Fill
0	0
.79	166
154	325
191	265
189	152
603	223
263	15
136	71
15	129
14	14
14	162
5	95
109	68
192	27
927	32
596	0

MUSKINGUM COUNTY COUNTY ROAD NO. 8

52
83

REVISION	DATE	DESCRIPTION	BY
3/23/62	AS CONSTRUCTED		H.F.K.
U. S. ARMY ENGINEER DISTRICT, HUNTINGTON CORPS OF ENGINEERS HUNTINGTON, W. VA.			
DRAWN BY: EER		LICKING RIVER DILLON RESERVOIR PROJECT	
CHECKED BY: JHL		RELOCATION OF MUSKINGUM COUNTY ROAD NO. 8	
SUBMITTED BY: Elmer S. Barrett Associates		MC-8-4 & MT-408-1	
RECOMMENDED BY: Elmer S. Barrett Associates		MC-8-1 & MC-408-1	
APPROVED: Steven Malovich		DATE: NOVEMBER 1959	
ELMER S. BARRETT ASSOCIATES CONSULTING ENGINEERS CHILLICOTHE, OHIO		SCALE: 1"=10' DRAWING NUMBER 0 271-UD 14-68/52 SHEET 52 of 83	

WORK AS CONSTRUCTED STA. 208+42.50 To STA. 210+57.58