


Seeding	
End Width	Sq. Yds.
29	
81	
29	
164	
30	
0	
0	
0	
9	
22	
278	
78	
109	
0	

Item L-9 Seeding & Protecting 1135 Sq. Yds
Carried to Sheet No. 25

STA. 2+24.96

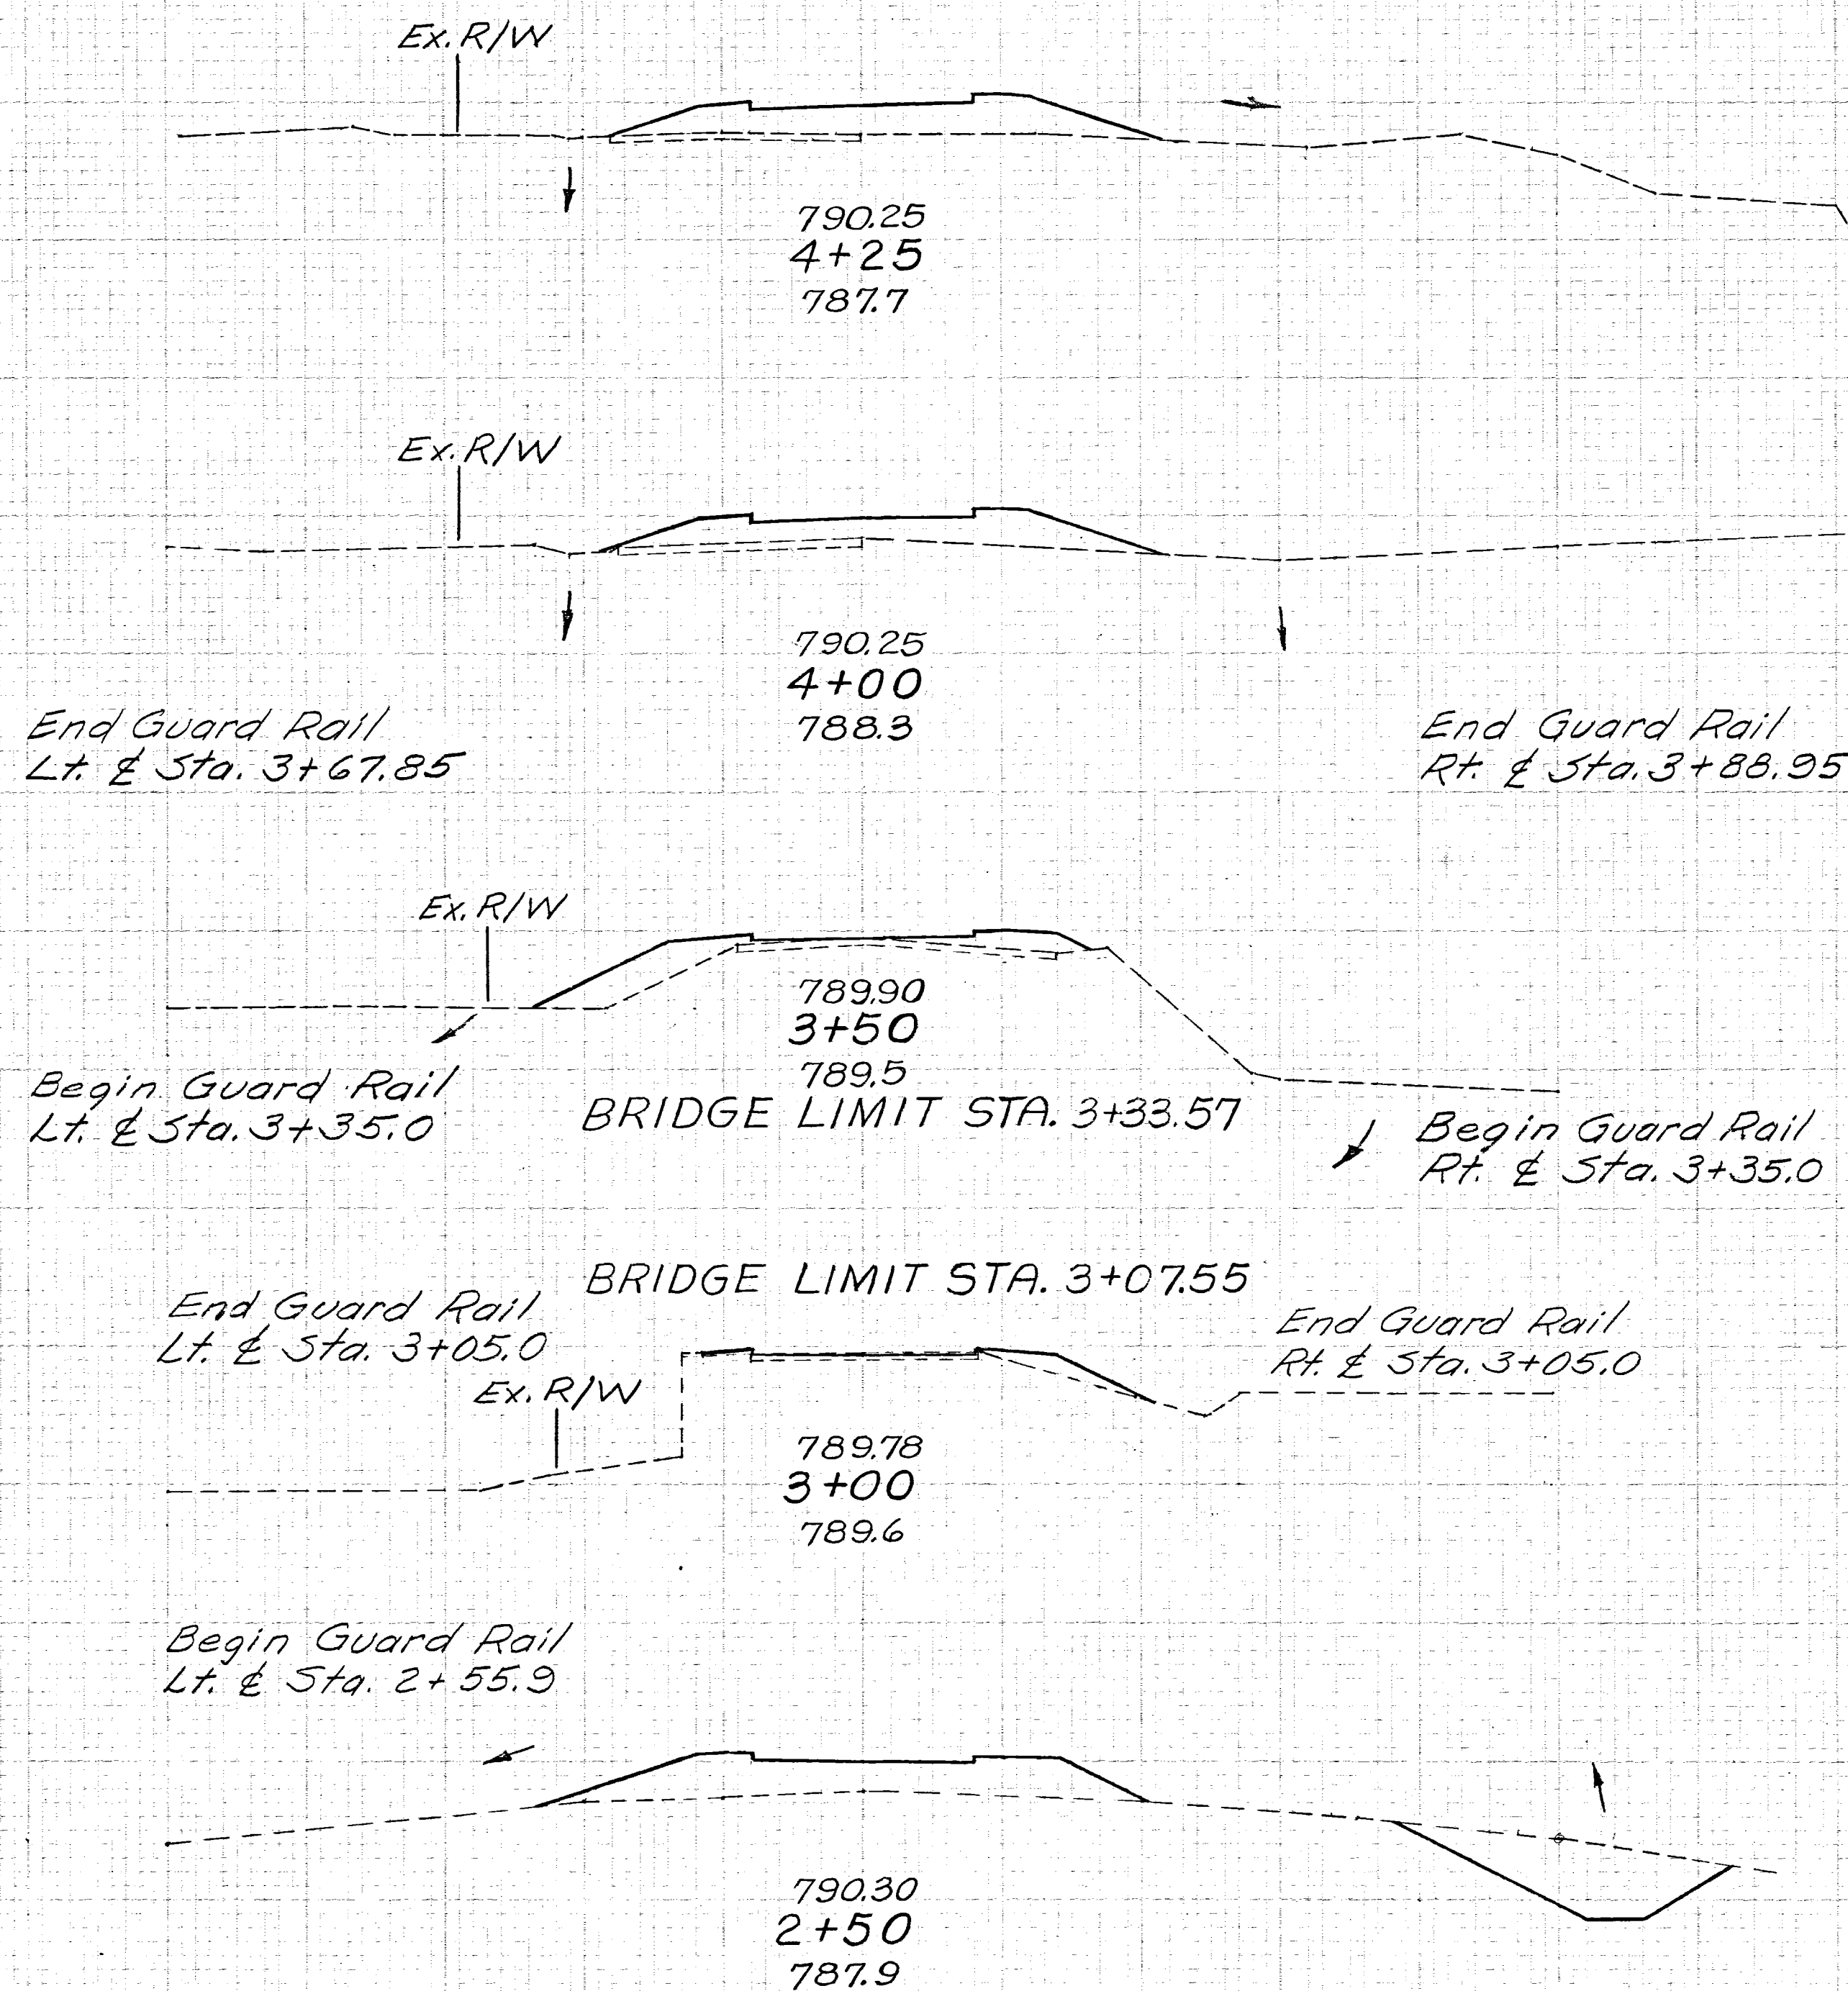

Excavation
Embankment
Carried to Sheet No. 25

STA. 2+24.96

End Area		Volume	
Cut	Fill	Cut	Fill
0	77		
		0	68
0	70		
		0	105
0	43	0	13
0	0		
0	0		
		1	2
3	12		
		77	97
80	93		
		37	43
0	0		

**MUSKINGUM COUNTY
COUNTY ROAD NO. 8**

54
83

REVISION	DATE	DESCRIPTION	BY
	3/23/62	AS CONSTRUCTED	H.F.K.
U. S. ARMY ENGINEER DISTRICT, HUNTINGTON CORPS OF ENGINEERS HUNTINGTON, W. VA.			
DRAWN BY: D.C.		LICKING RIVER DILLON RESERVOIR PROJECT	
CHECKED BY: F.H.S.		RELOCATION OF MUSKINGUM COUNTY ROAD NO. 8	
SUBMITTED BY: Elmer S. Barrett		MC-8-4 & MT-408-1	
ELMER S. BARRETT ASSOCIATES		MC-8-1 & MC-408-1	
RECOMMENDED BY: Elmer S. Barrett		APPROVED BY: Steven Malenchuk	
CHIEF ENG. DIV.		COL. C.E. DISTRICT ENGINEER	
ELMER S. BARRETT ASSOCIATES CONSULTING ENGINEERS CHILLICOTHE, OHIO		DATE: NOVEMBER 1959	
SCALE: 1"=10'		SPEC. NO.	
DRAWING NUMBER		0 2 7 f-UD 14-68/	
SHEET 54 of 83			

WORK AS CONSTRUCTED (APPROACH RT. & STA. 54+27.60) STA. 2+24.96 TO STA. 4+25