



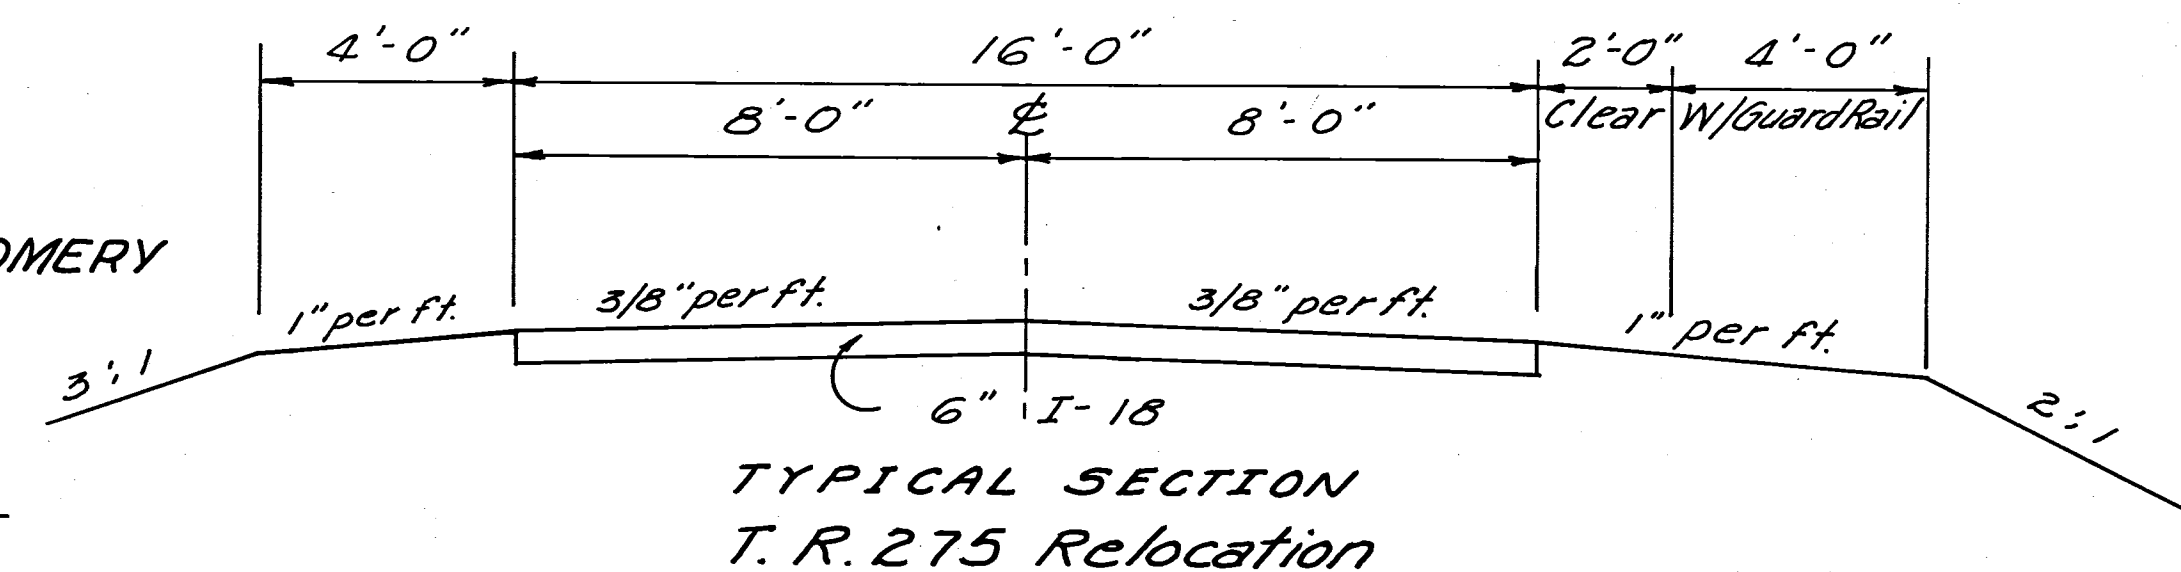

QUANTITIES						
Reference Number	Station to Station	Side	I-15 Wave Wire Type (Clapnet Wire Cable Type (Cable) Guard Rail)	I-18 Stabilized Crushed Aggregate for Sur-Face and Approaches 6"		
			Lin. Ft.	Cu. Yds.		
1-R	6 + 26 to 9 + 46	Rt.	320			
2-R	0 + 10.72 to 9 + 50	L		306.02		
③	See Sheet No. 70					
	TOTALS		320	306.02		

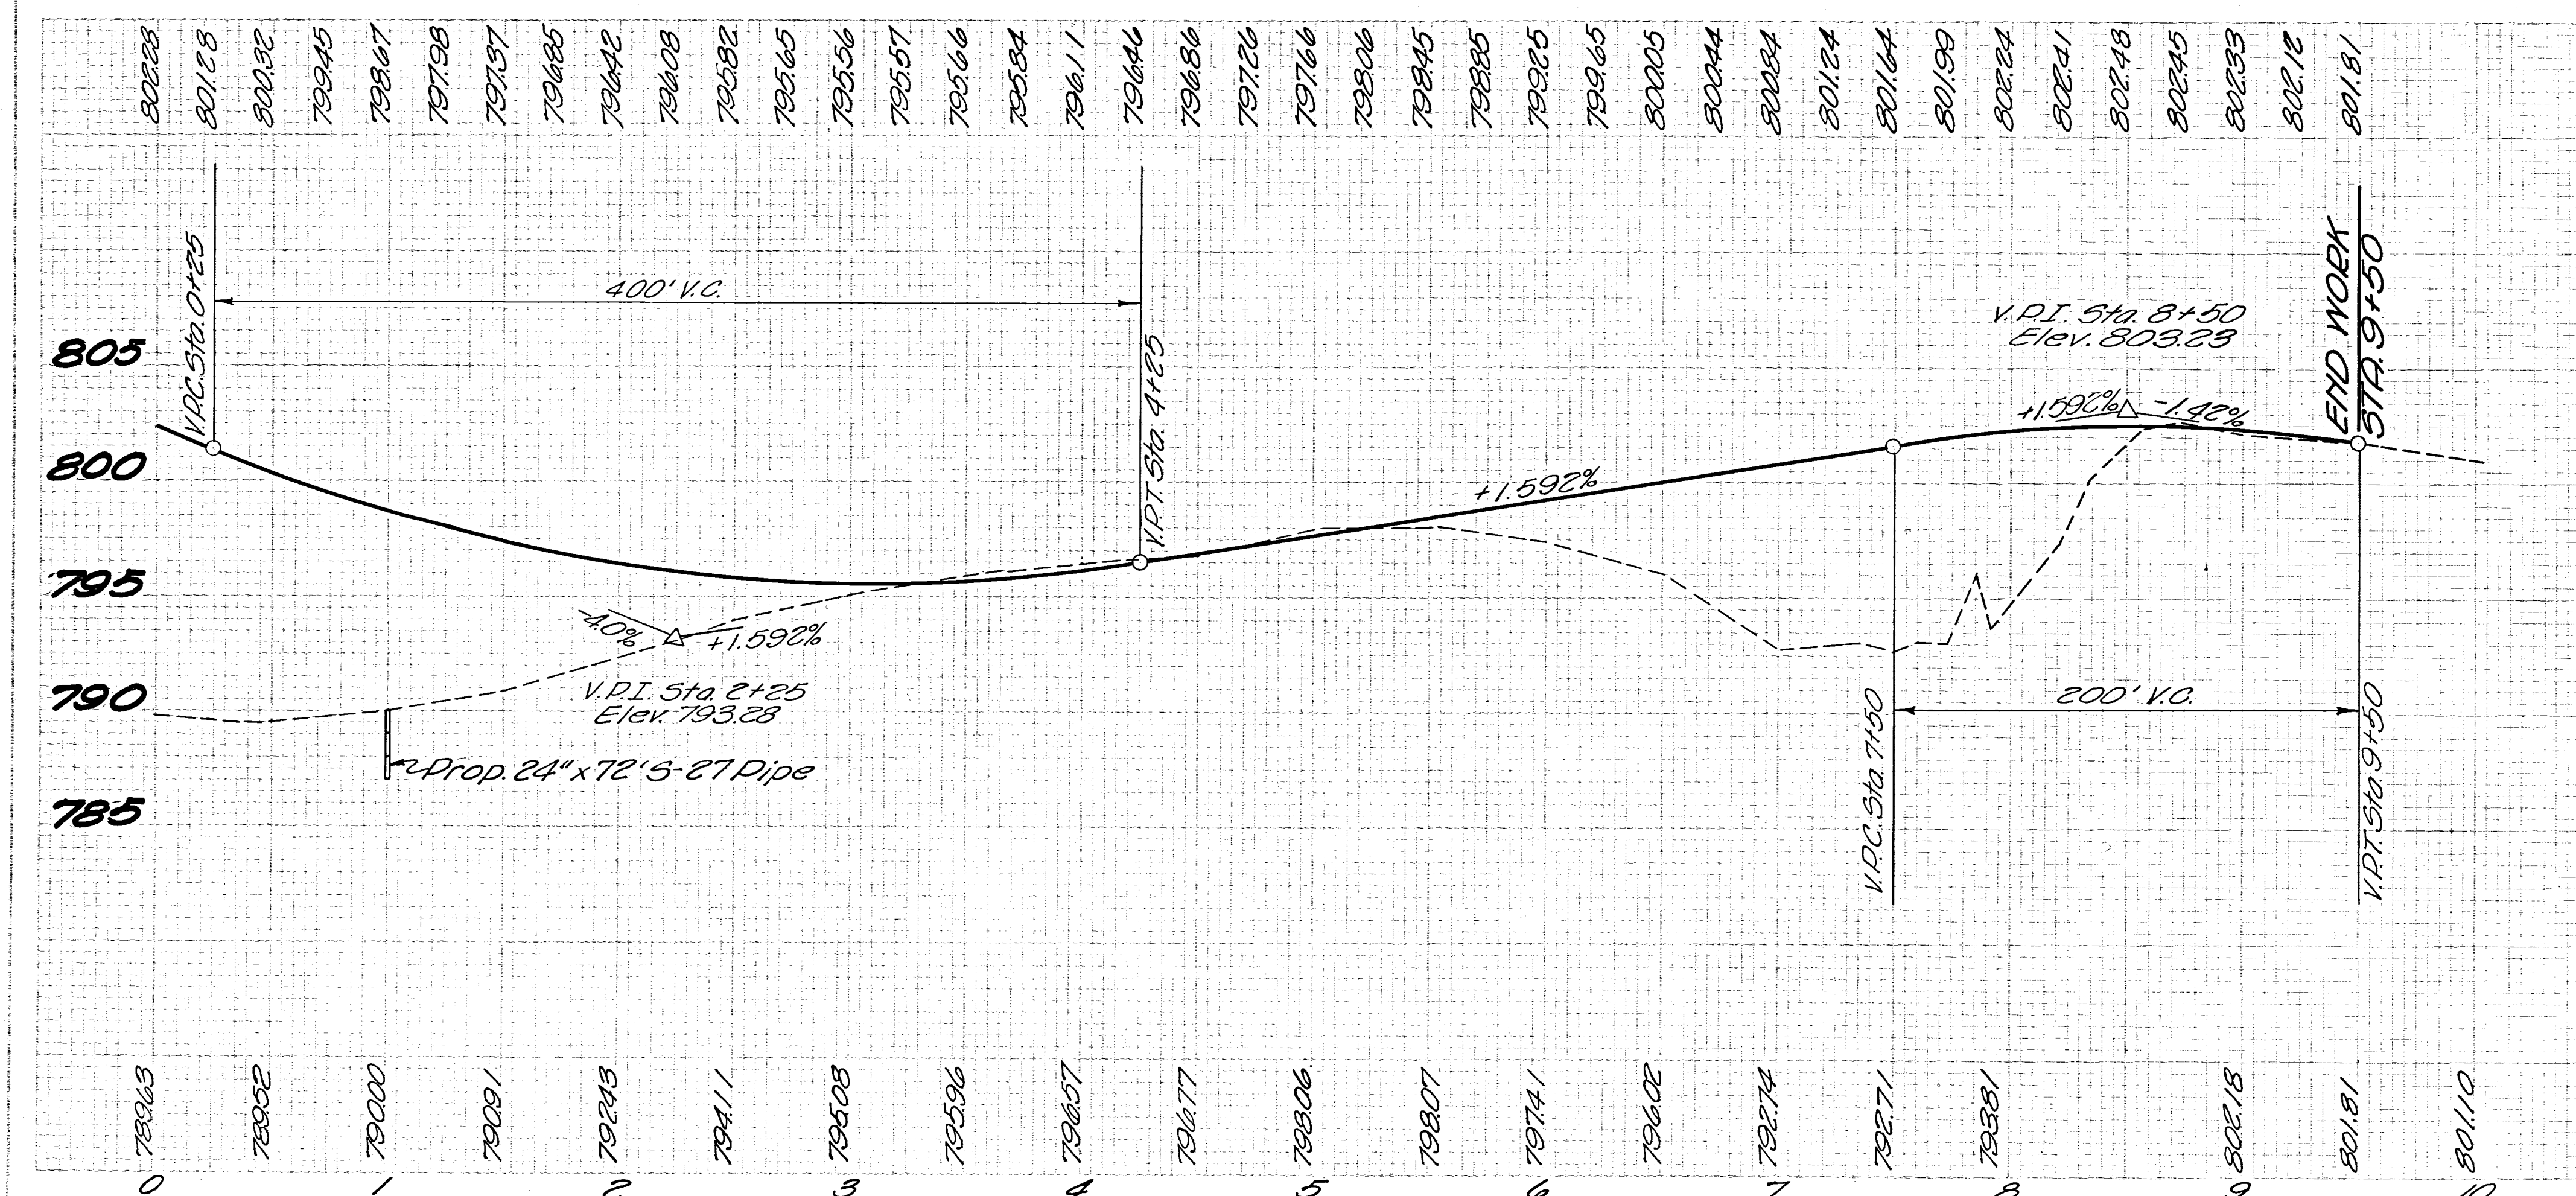

Relocation T. R. 275, STA. 0+00 TO STA. 10+00

				H.F.K.
	3/23/62	AS CONSTRUCTED		
REVISION	DATE	DESCRIPTION		BY
U. S. ARMY ENGINEER DISTRICT, HUNTINGTON CORPS OF ENGINEERS HUNTINGTON, W. VA.				
DRAWN BY: <i>WIC</i>				
TRACED BY:				
CHECKED BY: <i>F.H.S.</i>				
SUBMITTED BY: <i>Elmer S Barrett</i>				
ELMER S. BARRETT ASSOCIATES				
RECOMMENDED: <i>Jesse L. Smith</i>				
CHIEF ENG. DIV.	APPROVED <i>Steven Malovich</i>	DATE: NOVEMBER 1959		
ELMER S. BARRETT ASSOCIATES CONSULTING ENGINEERS CHILLICOTHE, OHIO		SCALE: VERT. 1"=50' HORIZ. 1"=5'		
		SHEET 57 OF 83		