


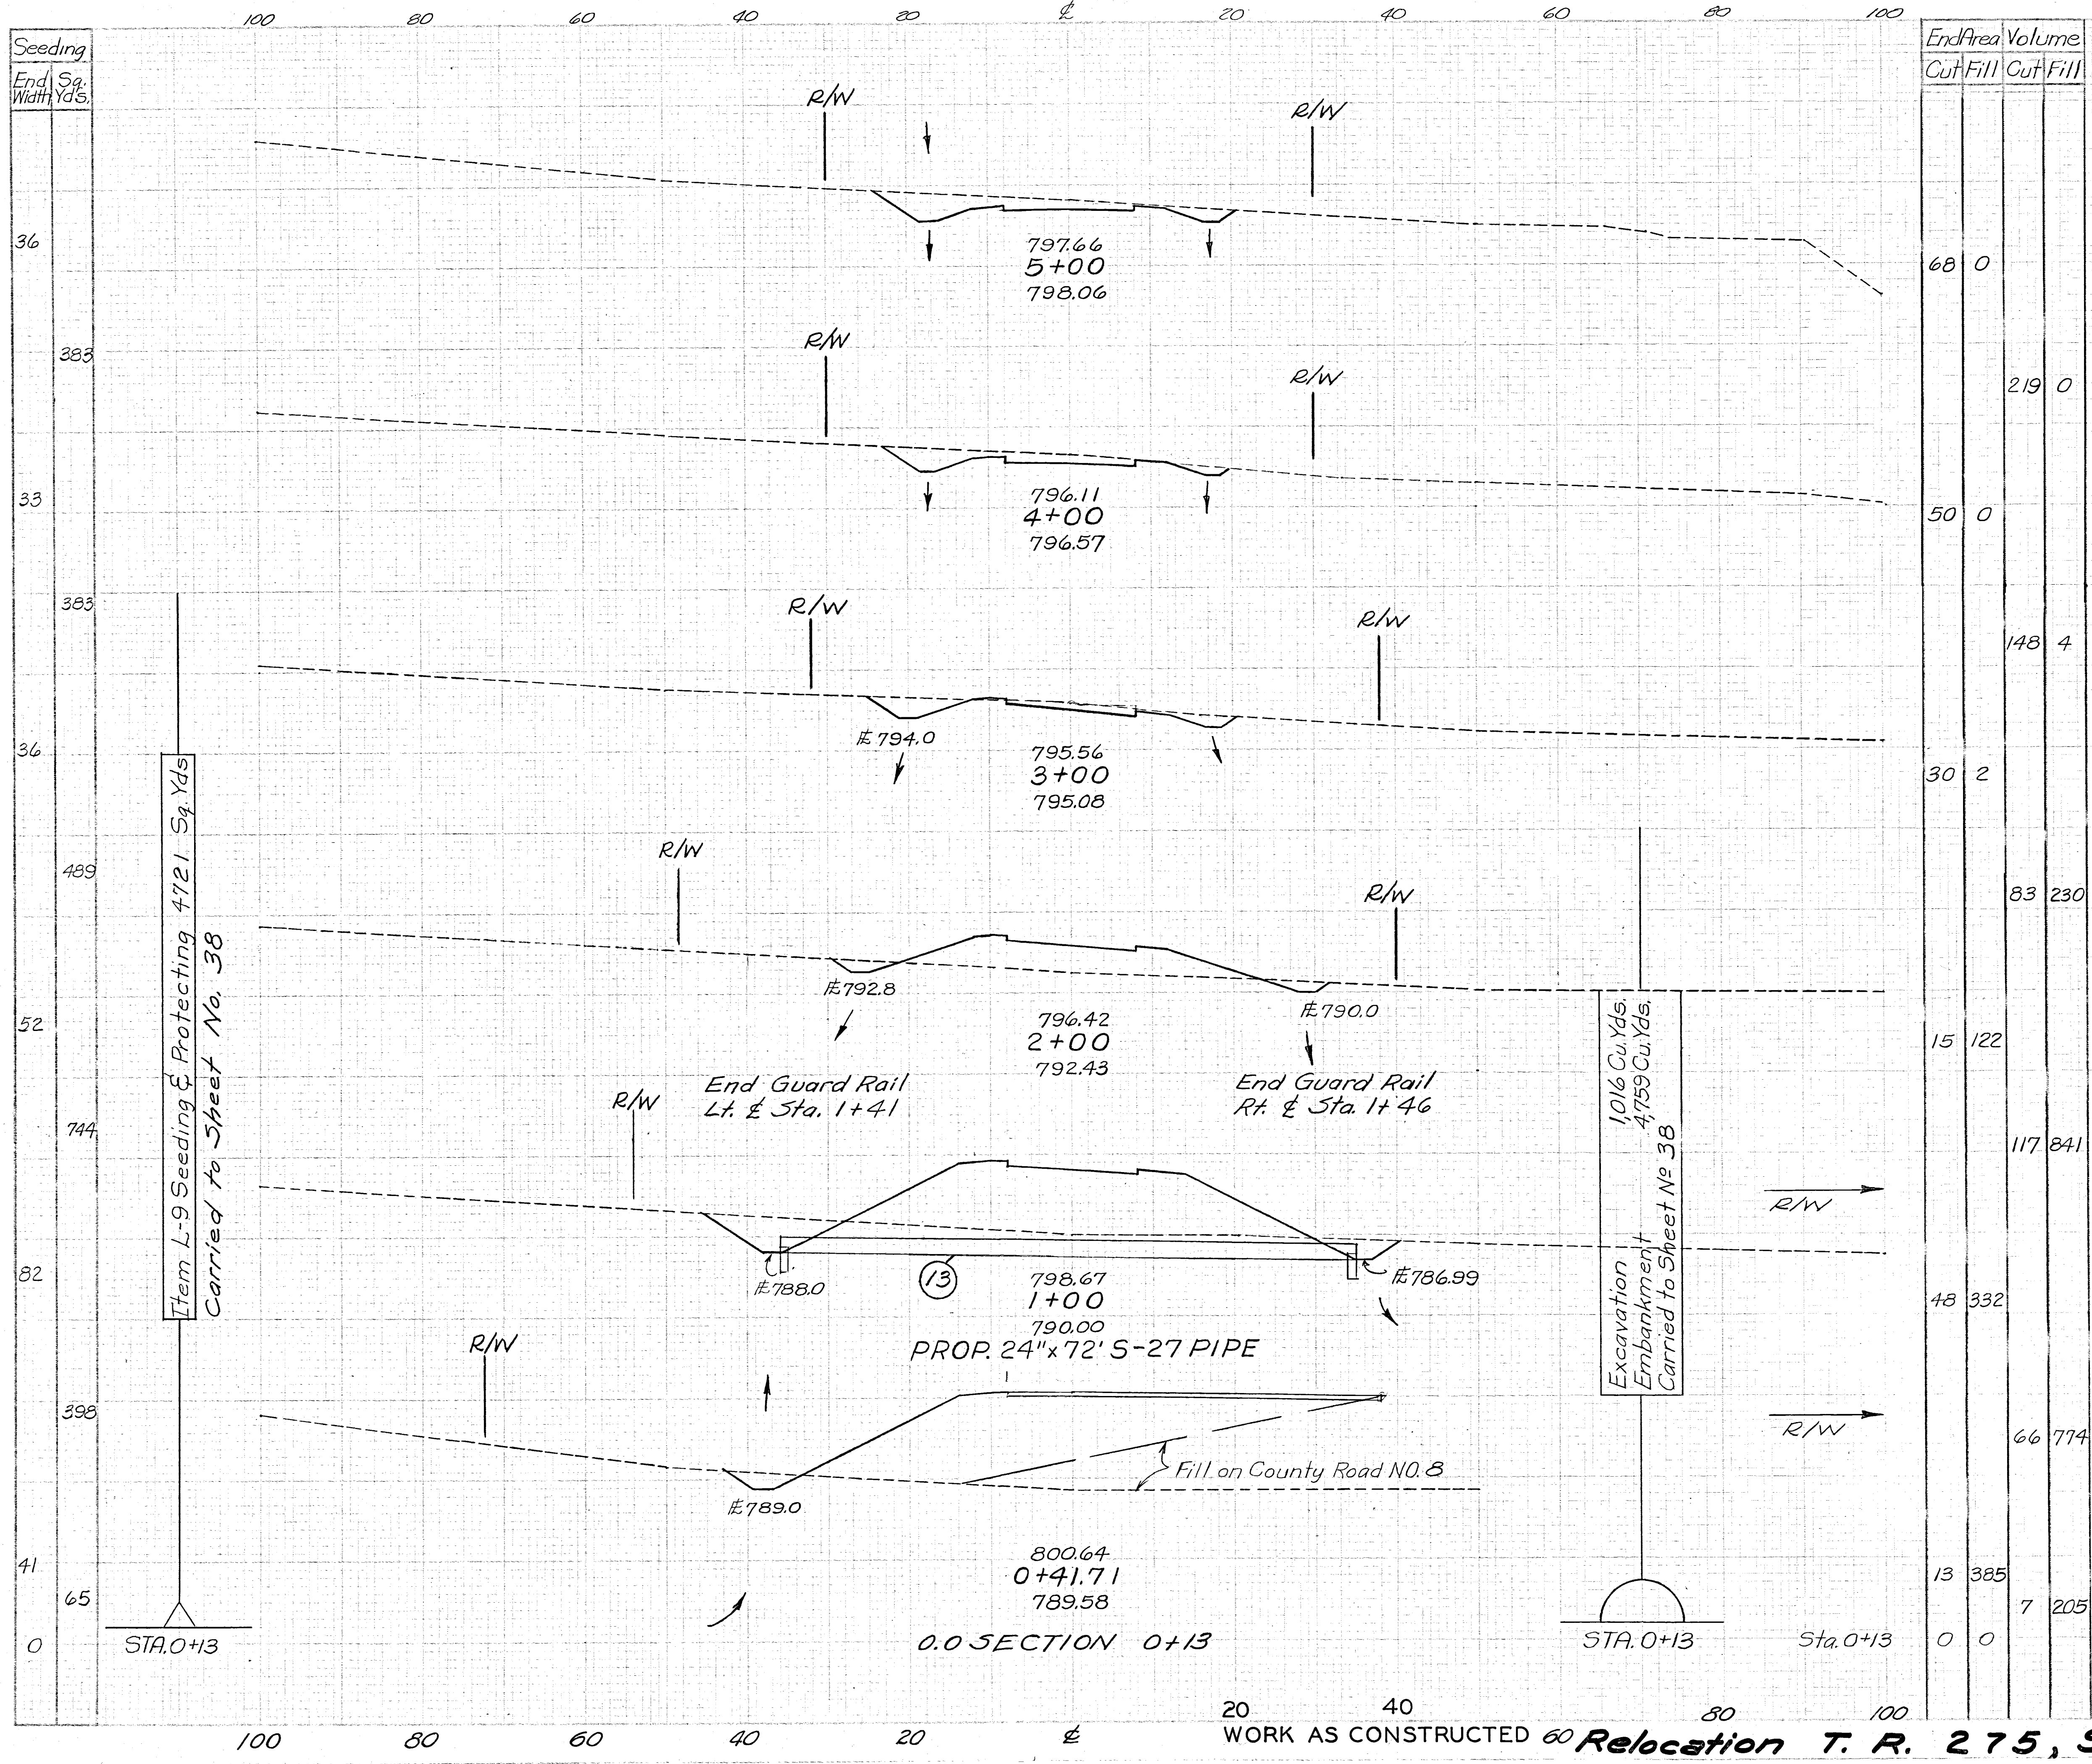

MUSKINGUM COUNTY
COUNTY ROAD NO. 8

58
83

REVISION	DATE	DESCRIPTION	BY
3/23/62	AS CONSTRUCTED		H.F.K.
U. S. ARMY ENGINEER DISTRICT, HUNTINGTON CORPS OF ENGINEERS HUNTINGTON, W. VA.			
DRAWN BY: WIC		LICKING RIVER DILLON RESERVOIR PROJECT	
CHECKED BY: F.H.S.		RELOCATION OF MUSKINGUM COUNTY ROAD NO. 8	
SUBMITTED BY: Elmer S. Barrett Associates		MC-8-4 & MT-408-1	
RECOMMENDED BY: Jimmy Garner		MC-8-1 & MC-408-1	
APPROVED: Steven Malevich		DATE: NOVEMBER 1959	
ELMER S. BARRETT ASSOCIATES CONSULTING ENGINEERS CHILLICOTHE, OHIO		SCALE: 1" = 10' DRAWING NUMBER 027f-UD 14-68/58 SHEET 58 OF 83	

Relocation T. R. 275, STA. 0+41.71 to STA. 5+00