


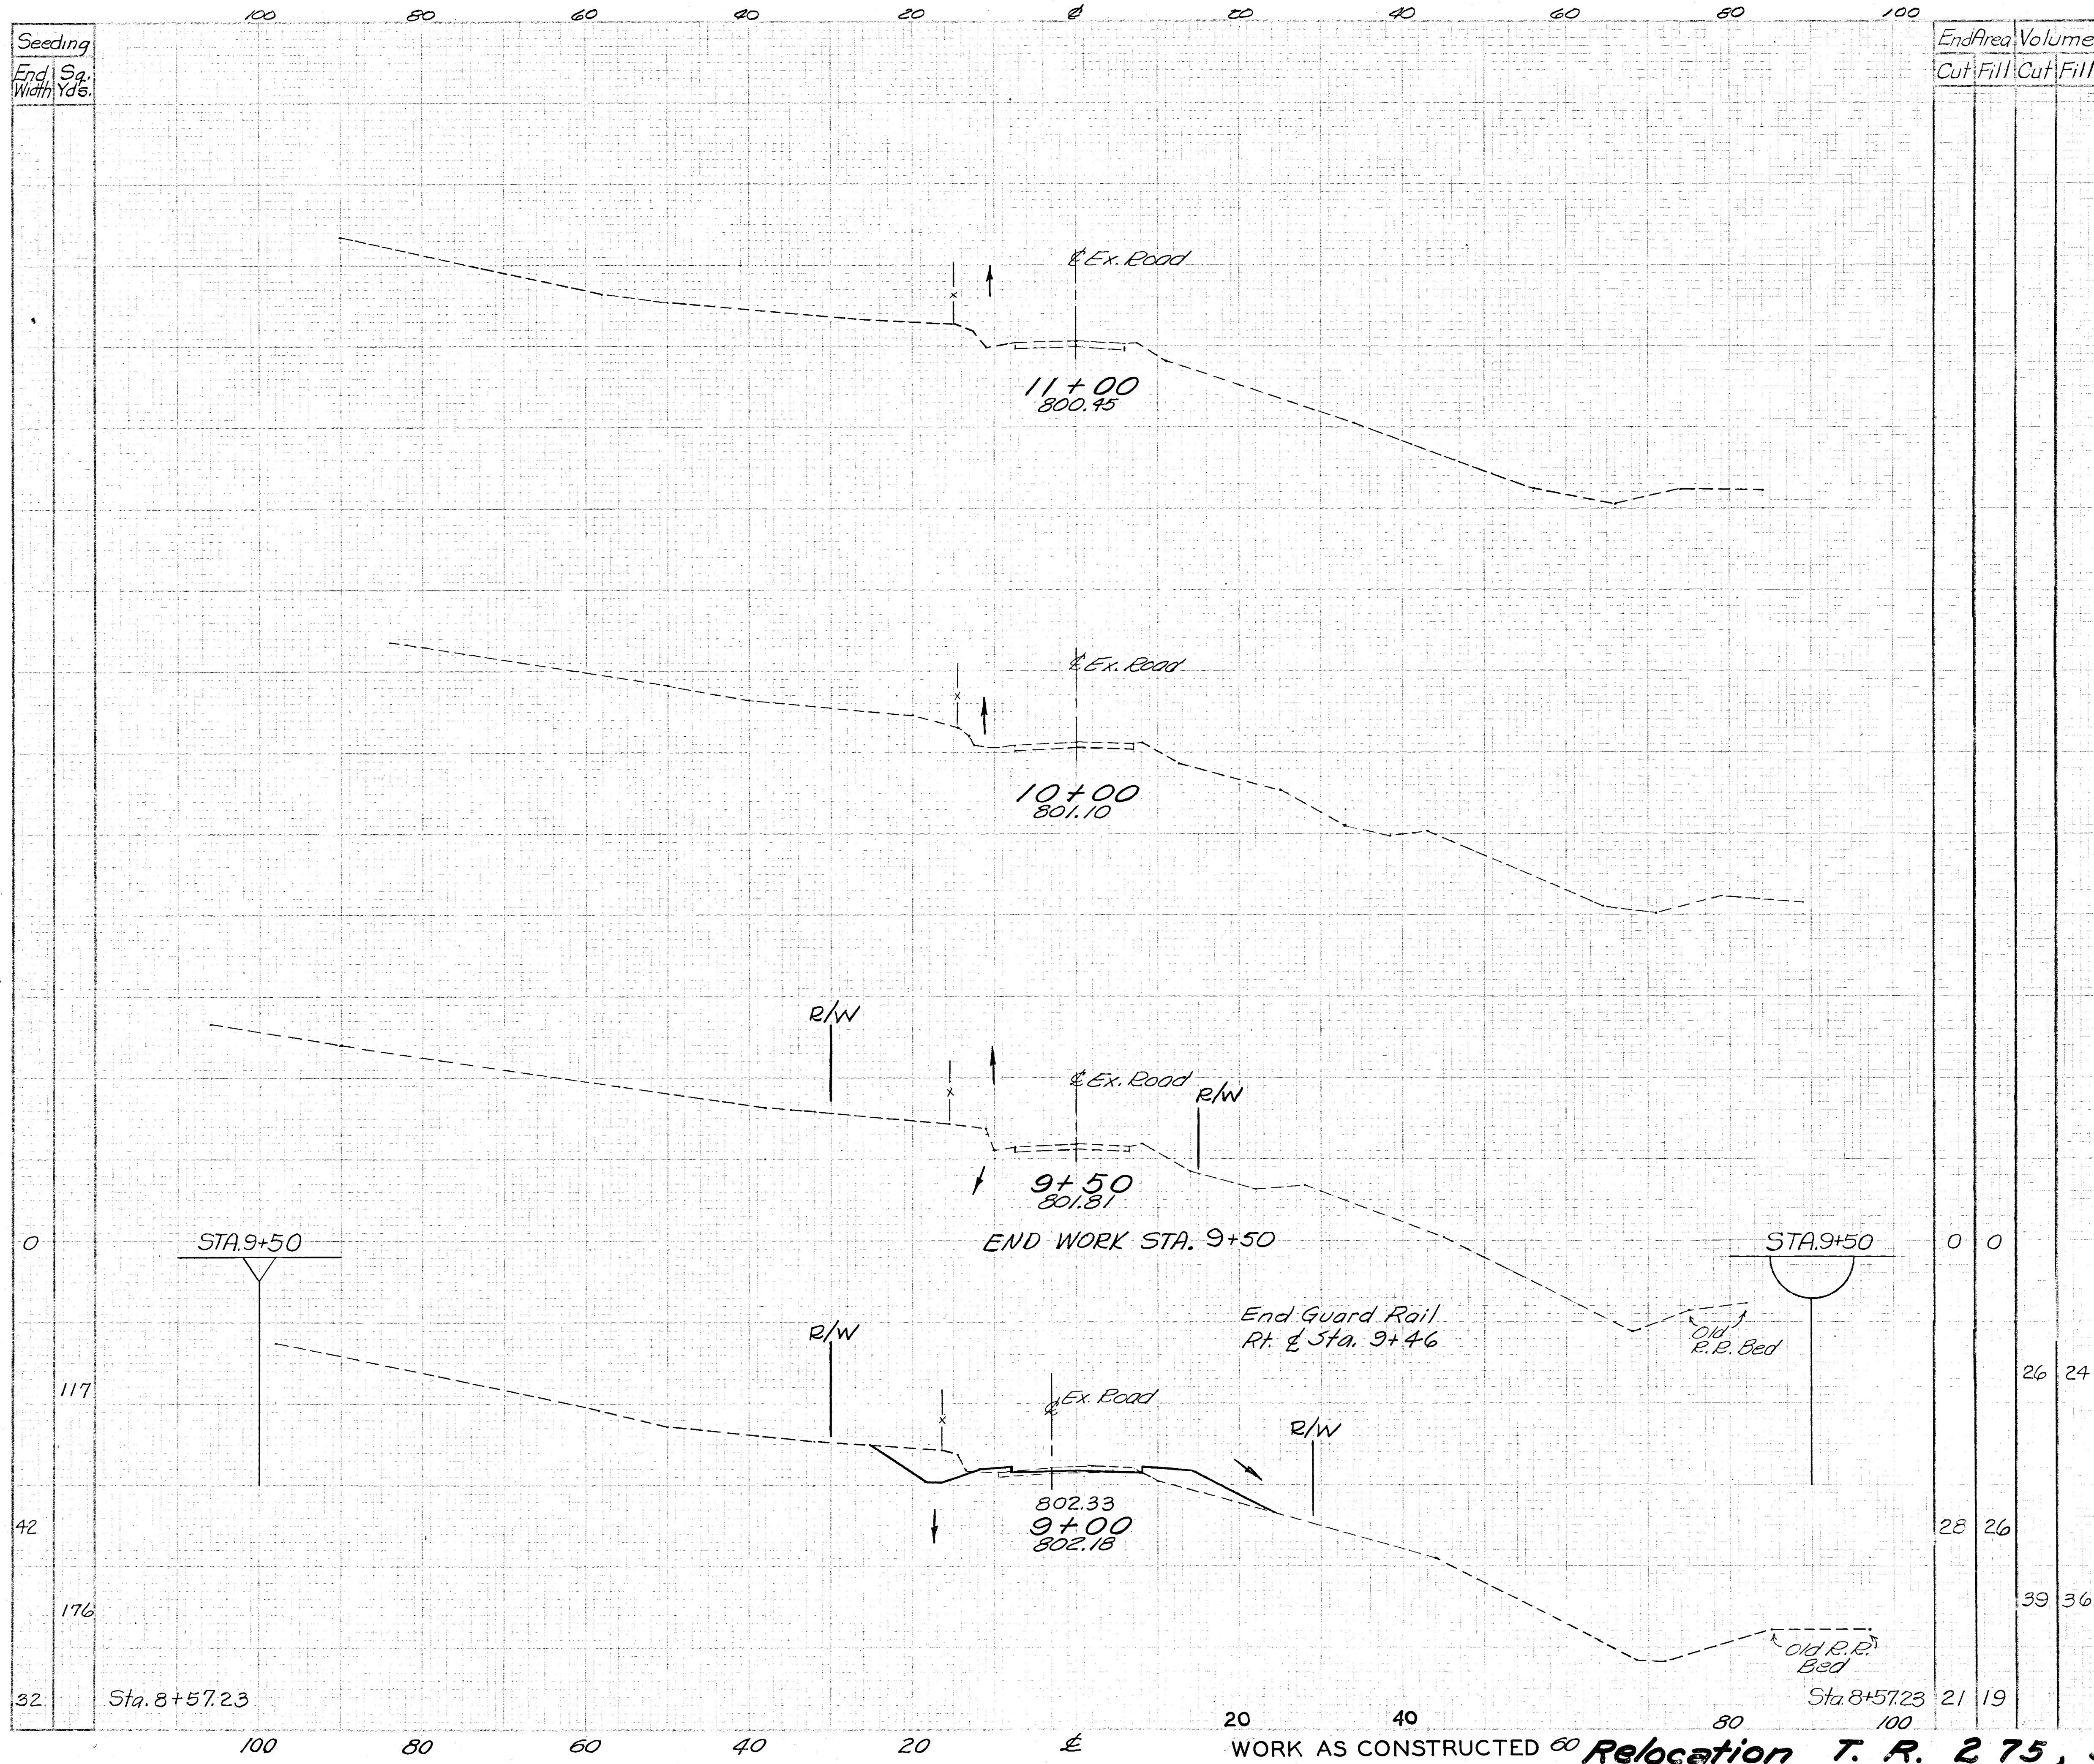

2 OHIO

MUSKINGUM COUNTY
COUNTY ROAD NO. 8

60
83

REVISION	DATE	DESCRIPTION	BY
	3/23/62	AS CONSTRUCTED	H.F.K.
U. S. ARMY ENGINEER DISTRICT, HUNTINGTON CORPS OF ENGINEERS HUNTINGTON, W. VA.			
DRAWN BY: WIC		LICKING RIVER DILLON RESERVOIR PROJECT	
CHECKED BY: F.H.S.		RELOCATION OF MUSKINGUM COUNTY ROAD NO. 8	
SUBMITTED BY: Elmer S. Barrett Associates		MC-8-4 & MT-408-1	
RECOMMENDED BY: James S. Barrett		MC-8-1 & MC-408-1	
APPROVED: Steven Malovich		DATE: NOVEMBER 1959	
ELMER S. BARRETT ASSOCIATES CONSULTING ENGINEERS CHILLICOTHE, OHIO		SCALE: 1" = 10' DRAWING NUMBER 0271-UD 14-68/60 SHEET 60 of 83	