



FED. RD. DIVISION	STATE	PROJECT
2	OHIO	

63
83

MUSKINGUM COUNTY
COUNTY ROAD NO. 8

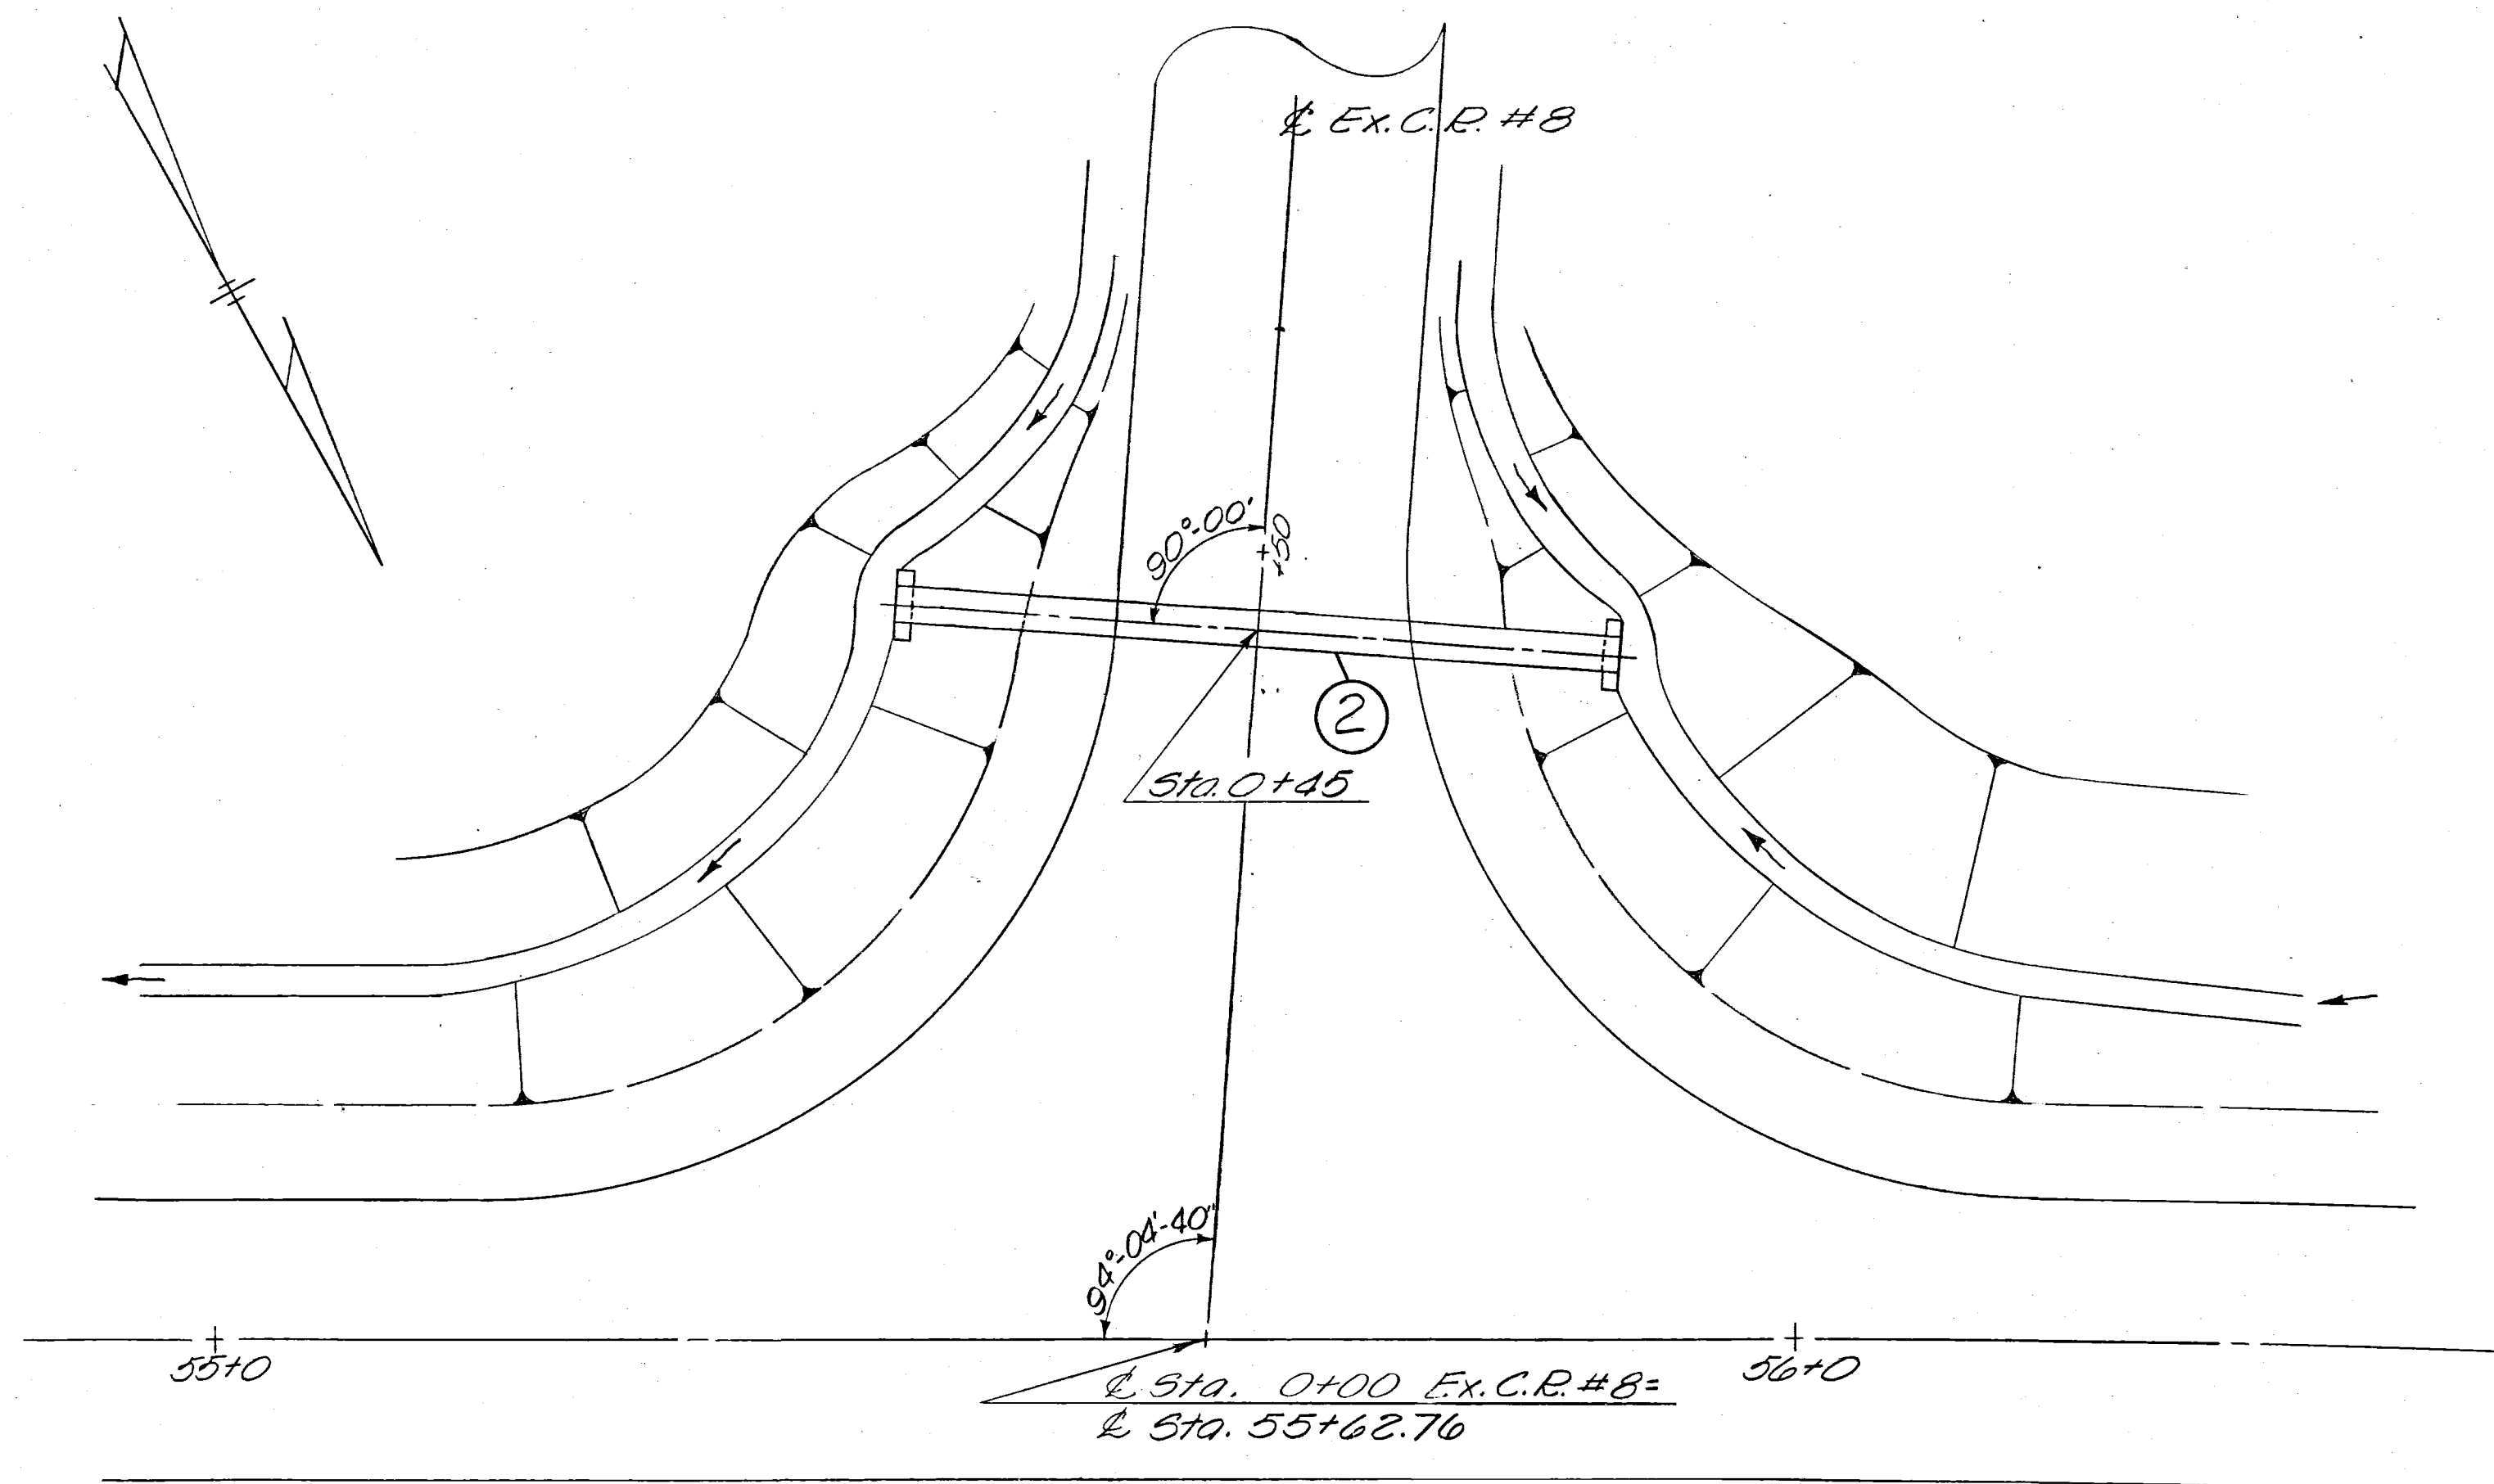


PLAN

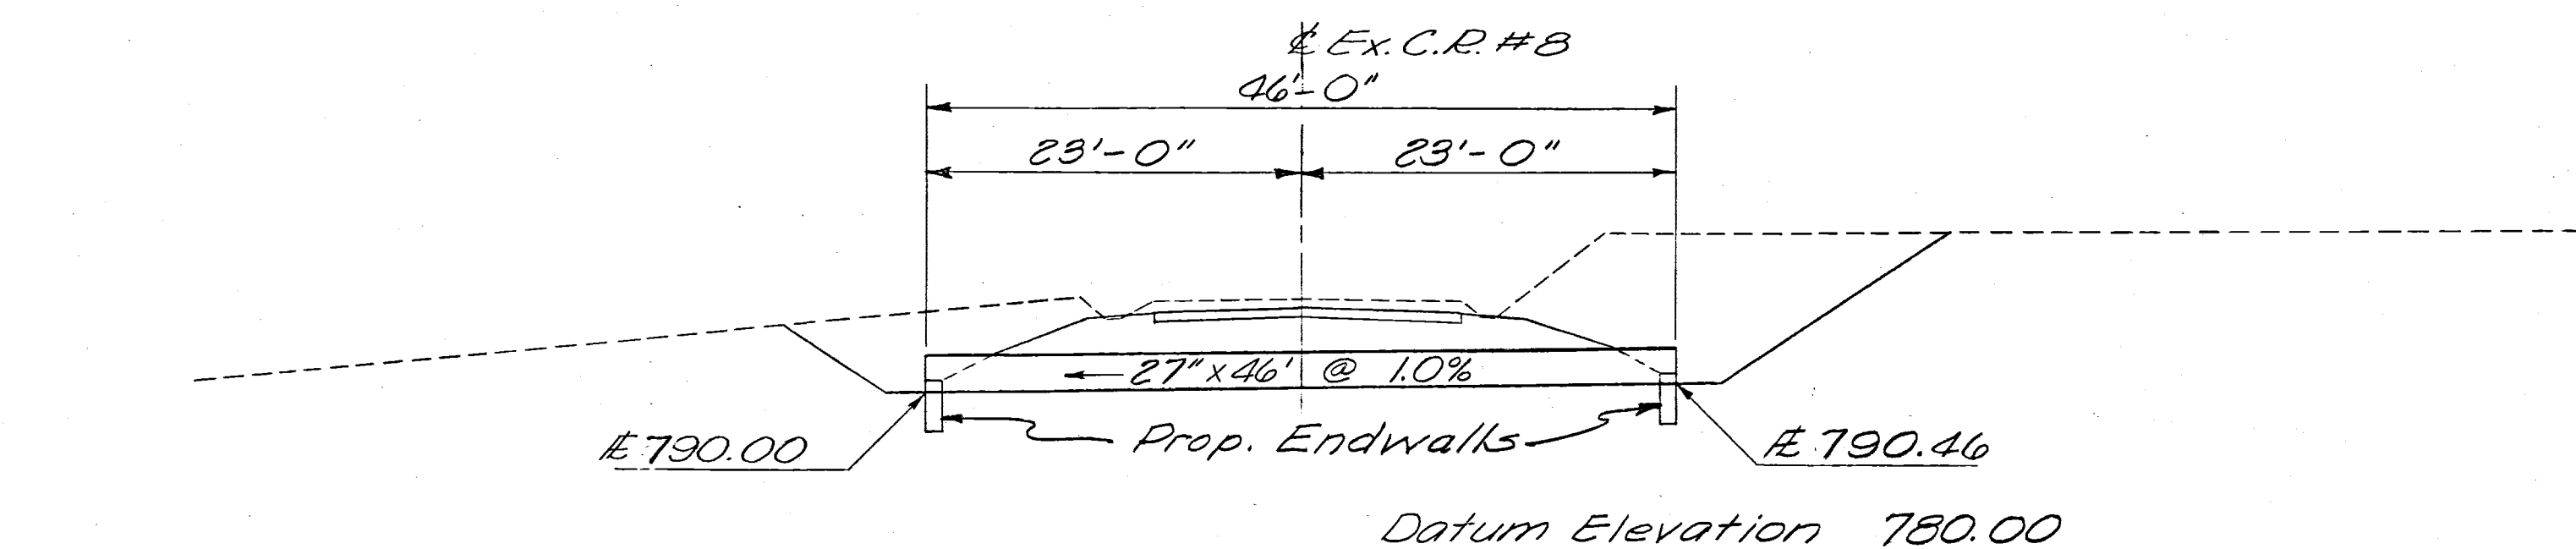


SECTION

ESTIMATED QUANTITIES


E-2 Excavation for Structures, Unclassified 40 Cu. Yd.
 3-1 Concrete for Structures, Class E 0.94 Cu. Yd.
 3-27 27" Pipe for Roadway Culverts 46 Lin. Ft.
 Sec. M-6.6(b), M-6.8(b) or M-6.4(d) 14 Gage

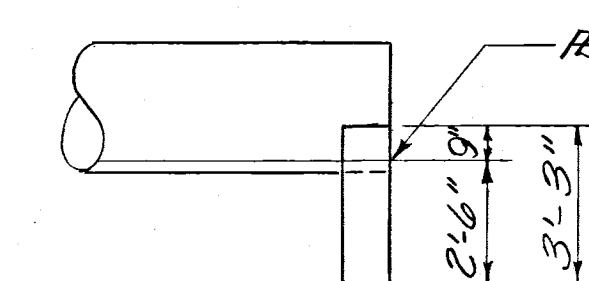

ELEVATION

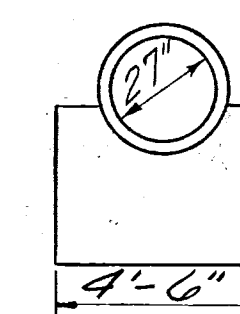

SIDE

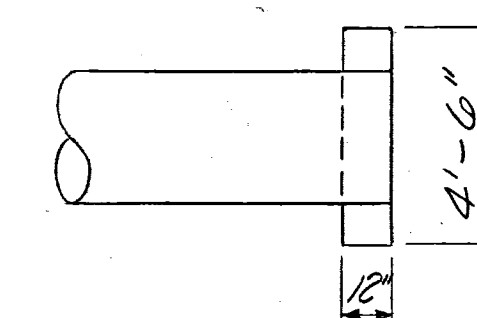

PLAN

ENDWALL DETAILS

Drainage Area = 12.4 Ac.
 $Q_{10} = 21$ cfs

REVISION	DATE	DESCRIPTION	BY
3/23/62	AS CONSTRUCTED		H.F.K.
U. S. ARMY ENGINEER DISTRICT, HUNTINGTON CORPS OF ENGINEERS HUNTINGTON, W. VA.			
DRAWN BY: D.M.C.		LICKING RIVER DILLON RESERVOIR PROJECT	
TRACED BY: idk		RELOCATION OF MUSKINGUM COUNTY ROAD NO. 8	
CHECKED BY: F.H.S.		MC-8- 4 & MT- 408-1	
SUBMITTED BY: Elmer S. Barrett Associates		MC-8- 1 & MC- 408-1	
RECOMMENDED: ELMER S. BARRETT ASSOCIATES		APPROVED: Steven Malench DATE: NOVEMBER 1959	
CHIEF ENG. DIV.		COL. C.E. DISTRICT ENGINEER	
ELMER S. BARRETT ASSOCIATES CONSULTING ENGINEERS CHILLICOTHE, OHIO		SCALE: 1"=10' DRAWING NUMBER 0271-UD 14-68/63 SHEET 63 OF 83	

WORK AS CONSTRUCTED

CULVERT DETAIL

(2)