


SUMMARY OF R/W REQUIRED									
PARCEL NO.	SUBDIVISION OR LOT	OWNER OF RECORD	VOL	PAGE	SH.	NO.	PRO.	AREA	OTHER
B-242	QR TP 3 T.2N. R.9W.	HENRY FRIZZELL ET AL.	231	214	9	288	1.231 Ac.	1.231 Ac.	Work Agreement required to construct drive left of Sta. 50+10 & to clean ditch left of Sta. 53+65.
B-243		CHARLES IRA JENKINS ET UX.	241	204	9	278	.094 Ac.		
B-241		L.G. & R.G. MILLER	429	102	9	1081	1.891 Ac.	1.891 Ac.	W.A.s required to dress slopes rt. of Sta. 6+10 & Sta. 6+10 to construct drives rt. of Sta. 69+26 & lt. of Sta. 71+48 *
B-209		RALPH R. CROSS	294	112	11	843	.990 Ac.		Work Agreements required to construct drives right of Sta. 78+27 & left of Sta. 79+46.
B-210		ISOLA F. STEEN	249	543	12	746	.895 Ac.		Also vol. 283, page 93. Work Agreements required to clean ditches right of Sta. 86+16 & Sta. 93+50. *
B-240		ROSS VARNER	405	202	13	1559	1.690 Ac.		Work Agreements required to construct drives right of Sta. 97+90 & left of Sta. 101+59 & Sta. 109+91. *
B-239		SARAH E. BRAILER ET AL.	228	543	14	1562	1.922 Ac.		Also vol. 343, page 239. W.A.s required to construct drives lt. of Sta. 109+91 & rt. of Sta. 116+82 & Sta. 122+20. *
B-226-1		JOHN L. JR. & GERALDINE ESHELMAN	437	470	16	1883	2.055 Ac.		W.A.s required to construct drive right of Sta. 130+22 & left Sta. 135+24. *
B-213-5		FRANK O. PERRY	311	156	158	18	.027 Ac.		Also vol. 246, page 68.
B-213-SL-1							.042 Ac.		
B-213-SL-2							.052 Ac.		
B-213-SL-3							.038 Ac.		
B-213-SL-4							.050 Ac.		
B-213-1	QR TP 3 T.2N. R.9W.	FRANK O. PERRY				18	.073 Ac.		Work Agreement required to place Dumped Rock right of Station 142+10.
B-213-2	QR TP 3 & 2 T.2N. R.9W.	FRANK O. PERRY	311	156	158	18	.299 Ac.		Also vol. 246, page 68.
B-226-2	QR TP 3 T.2N. R.9W.	JOHN L. JR. & GERALDINE ESHELMAN	437	470	18	57	1.004 Ac.		
B-213-3	QR TP 4 T.2N. R.10W.	FRANK O. PERRY	311	156	158	18	7.106 Ac.		Also vol. 246, page 68.
B-214-1	QR TP 4 T.2N. R.10W.	EMILY S. MONTGOMERY				57	2.66 Ac.		
B-214-2	QR TP 2 T.2N. R.9W.	EMILY S. MONTGOMERY				20	3.426 Ac.		
J-1036		S.G. & IVA M. RAMSEY	431	277	21	22	2.930 Ac.		
J-1035		STATE OF OHIO	See Note			22	.586 Ac.		Note: See Ohio Law 102. Work Agreement required to cut slope right of Sta. 186+0.
J-1037		S.G. & IVA M. RAMSEY	431	277	22	24	6.656 Ac.		This parcel has one existing building.
J-1038	QR TP 2 T.2N. R.9W.	HELEN F. HANBY	275	228	24	103	.938 Ac.		Also vol. 282, page 456 & vol. 304, page 389.
X-1	QR TP 4 T.2N. R.10W.	B. & O. RAILROAD				18	.386 Ac.		
X-2	QR TP 3 T.2N. R.9W.	B. & O. RAILROAD				57	.011 Ac.		
X-3	QR TP 4 T.2N. R.10W.	B. & O. RAILROAD				57	.015 Ac.		

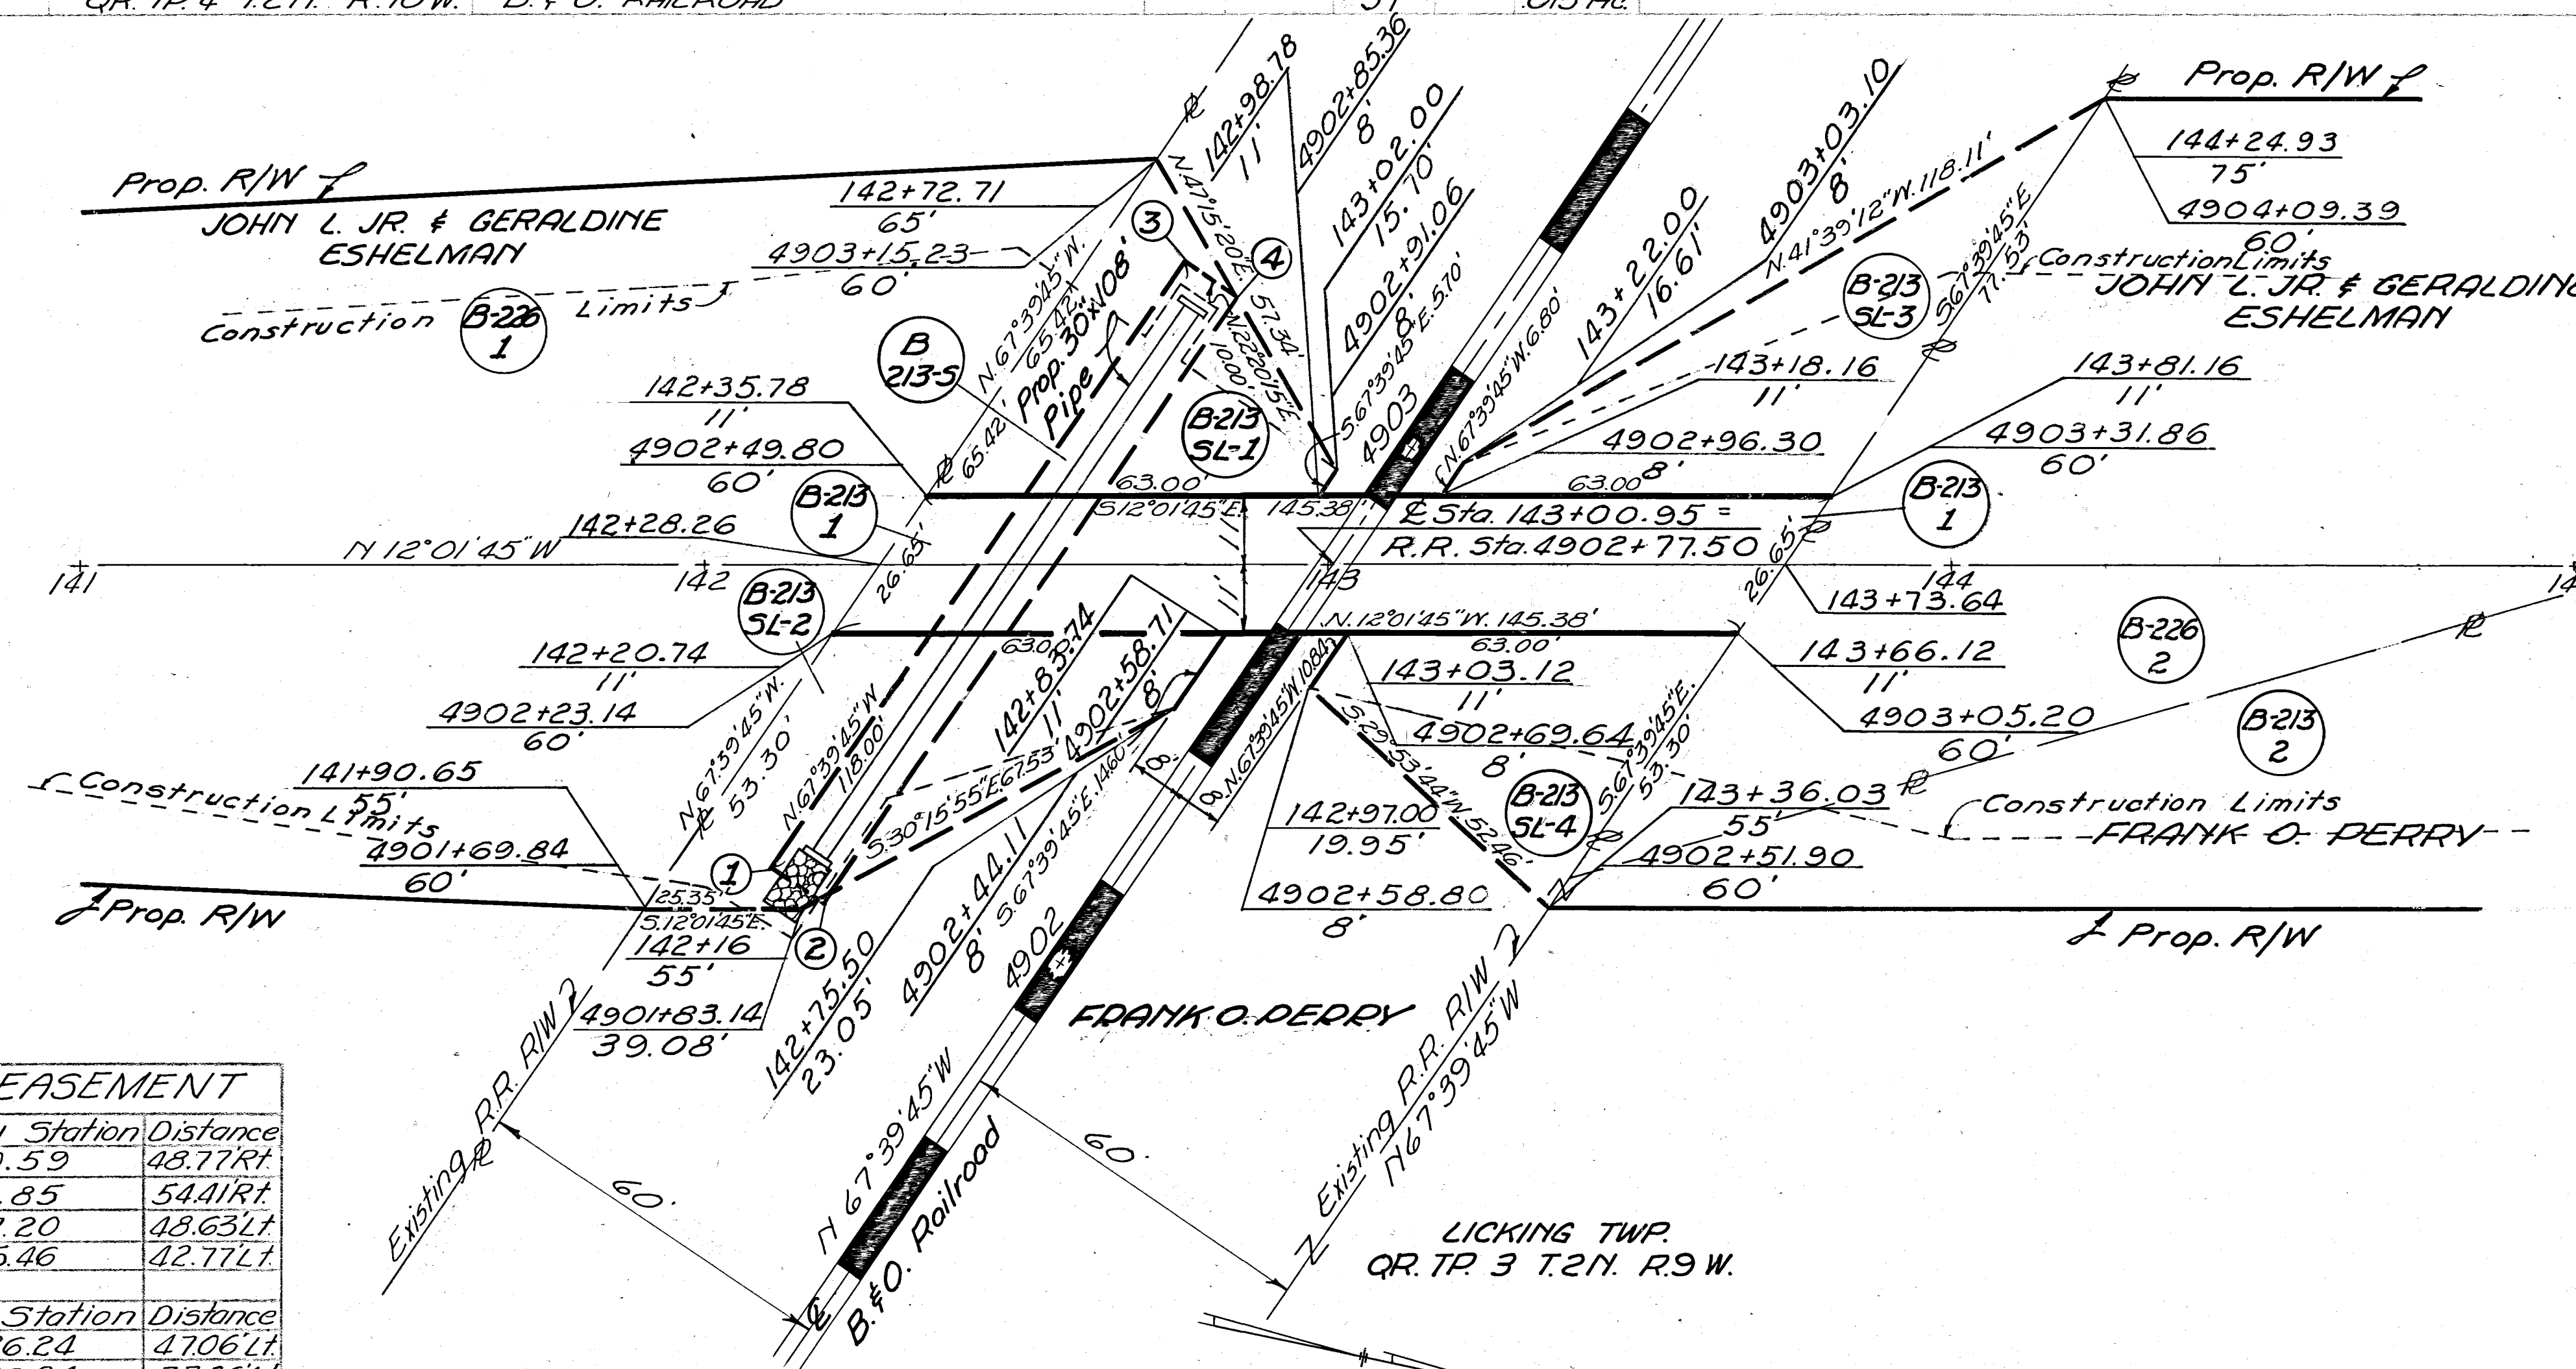

*Note: Parcel No. B-241, Work Agreement required to place Dumped Rock right of Station 72+11.
Parcel No. B-210, Work Agreement required to place Dumped Rock right of Station 86+18.8 & Sta. 93+50.
Parcel No. B-240, Work Agreement required to place Dumped Rock right of Station 106+45.
Parcel No. B-239, Work Agreement required to place Dumped Rock right of Station 118+53.5.
Parcel No. B-226-1, Work Agreements required to place Dumped Rock right of Station 128+55.3 & Station 133+63.5 & to clean ditch right of Sta. 133+65.

SEWER EASEMENT		
Corner	Highway Station	Distance
1	142+10.59	48.77 Rt.
2	142+18.85	54.41 Rt.
3	142+77.20	48.63 Lt.
4	142+85.46	42.77 Lt.
Corner	Railroad Station	Distance
1	4901+86.24	47.06 Lt.
2	4901+86.24	37.06 Lt.
3	4903+04.24	47.06 Lt.
4	4903+04.24	37.06 Lt.

**SUPPLEMENTAL PLAN
B. & O. RAILROAD**

3/23/62	AS CONSTRUCTED	H.F.K.
REVISION	DATE	DESCRIPTION
U. S. ARMY ENGINEER DISTRICT, HUNTINGTON CORPS OF ENGINEERS HUNTINGTON, W. VA.		
DRAWN BY: REJ	LICKING RIVER DILLON RESERVOIR PROJECT	
TRACED BY: L.F.	RELOCATION OF MUSKINGUM COUNTY ROAD NO. 8 MC-8-4 & MT-408-1 MC-8-1 & MC-408-1	
CHECKED BY: J.H.S.	ELMER S. BARRETT ASSOCIATES	
SUBMITTED BY: Elmer S. Barrett	APPROVED: Steven Malovich COL. C.E. DISTRICT ENGINEER	
RECOMMENDED: Elmer S. Barrett	DATE: NOVEMBER 1959	
ELMER S. BARRETT ASSOCIATES CONSULTING ENGINEERS CHILLICOTHE, OHIO		SCALE: 1"=20' DRAWING NUMBER 0271- UD 14- 68/ 83 SHEET 83 OF 83