

TOWNSHIP ROAD NO. 409

MUSKINGUM COUNTY

FALLS TOWNSHIP

We, the Commissioners of Muskingum County in formal session hereby approve these plans.

BOARD OF COMMISSIONERS

Date August 17, 1959

The standard specifications of the State of Ohio, Department of Highways, including changes and supplemental specifications listed in the proposal shall govern this improvement.

Muskingum County, Ohio shall furnish such rights of way as are currently available on the existing highways. The United States of America shall provide all necessary new or additional rights of way.

I hereby approve these plans and declare that the making of this improvement will not require the closing to traffic of the highway.

Approved *Hyton J. Barnes*
Date August 17, 1959 County Engineer

CONVENTIONAL SIGNS


State Line	-----
County Line	-----
Township Line	-----
Section Line	-----
Center Line	-----
Corporation Line	-----
Fence Line	-----
Guard Rail (existing)	-----
Guard Rail (proposed)	-----
Steam Railroad	-----
Power Poles	-----
Telephone Poles	-----
Trees (existing)	-----
Trees (to be removed)	-----

INDEX OF SHEETS

Title Sheet	1
Schematic Plan	2
Typical Sections	3
Typical Details	4 - 7
Notes	8
Summary of Quantities	9
General Summary	9
Superelevation Tables	10
Plan and Profile	11 - 14
Cross Sections	15 - 24
Structures 20' Span & Under (Pipe Culverts)	25 - 26
Location Plan	27
R/W Plan	11 - 14

LINE DATA

Begin Project	Sta. 50+00
End Project	Sta. 74+00
Net Length of Project	2,400 Lin. Ft. or 0.454 Miles

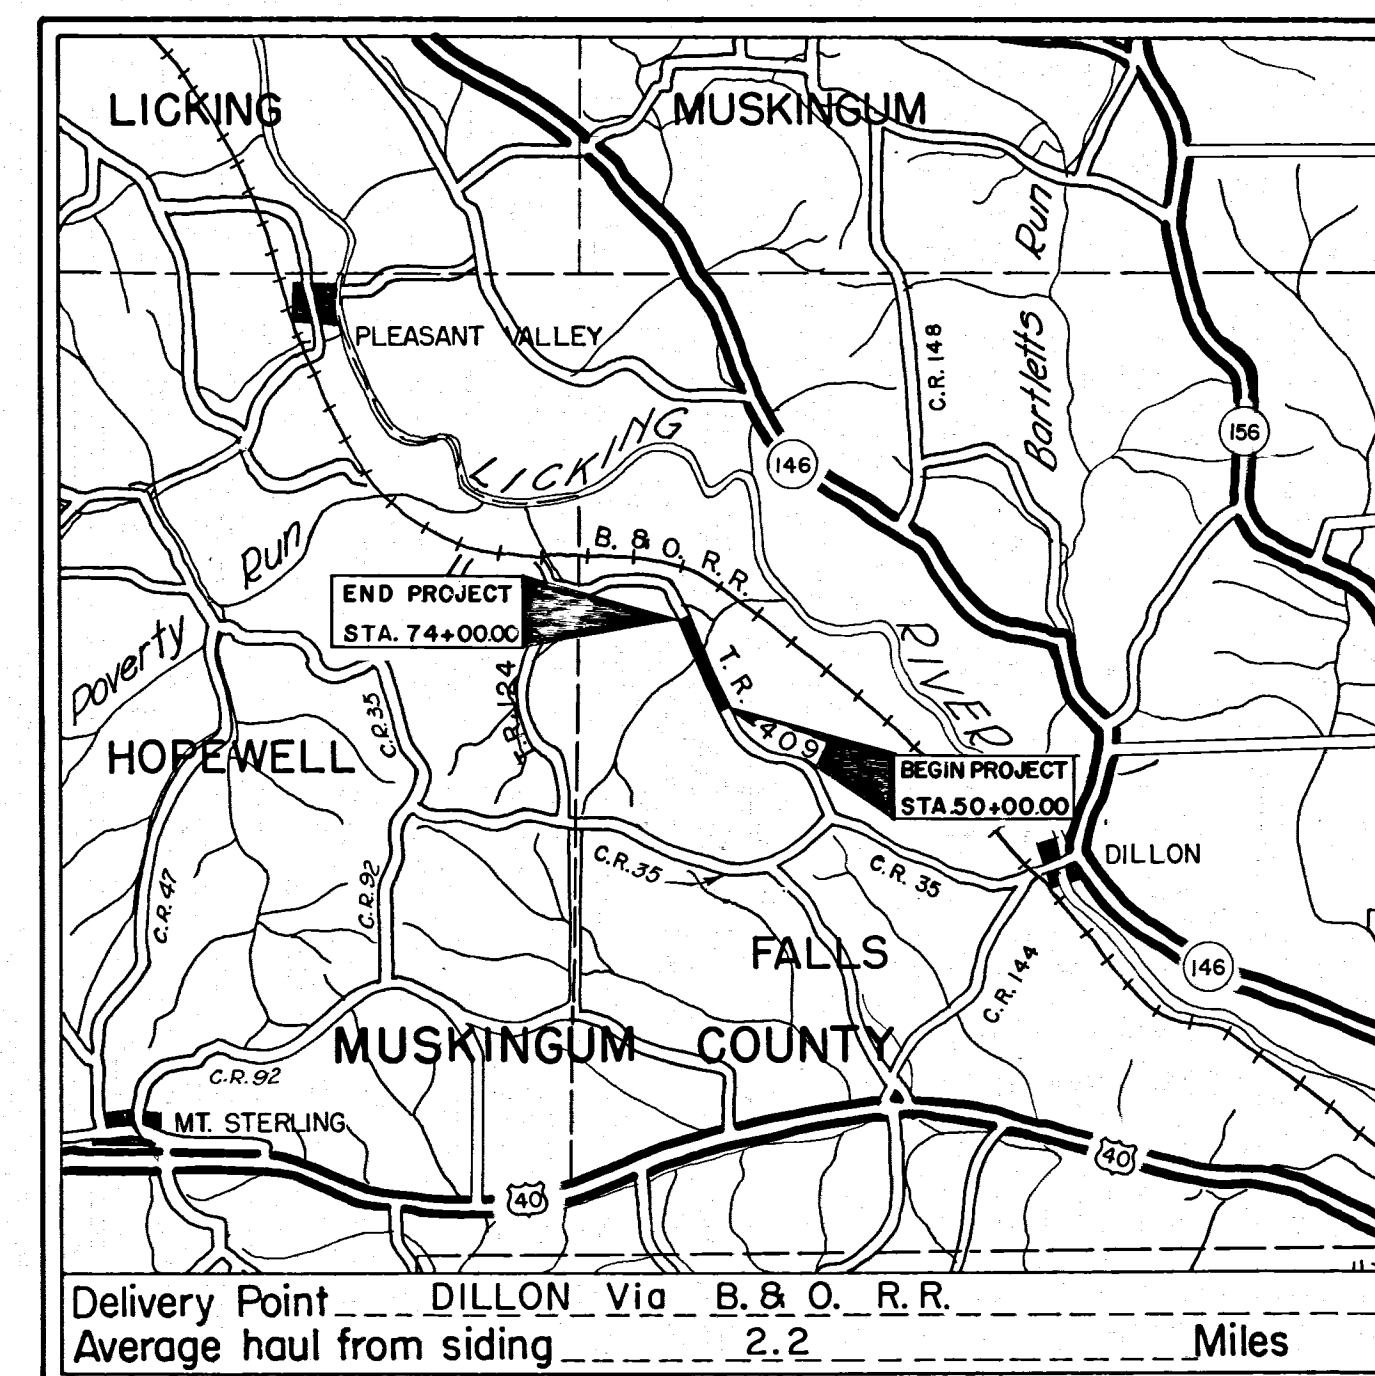

LOCATION MAP

SCALE OF MILES



Portion to be improved
State Roads
Other Roads

SCALE

Plan	1" = 50'
Profile: Horizontal	1" = 50'
Profile: Vertical	1" = 10'
Cross Sections	1" = 10'

Supplemental Prints of Standard Construction Drawings

Supplemental Specifications

File No.	Date of Letting	195
	Contract No.	

3/20/62	AS CONSTRUCTED	H.F.K.
REVISED	DATE	DESCRIPTION
U. S. ARMY ENGINEER DISTRICT, HUNTINGTON CORPS OF ENGINEERS HUNTINGTON, W. VA.		
DRAWN BY: <i>edk</i>		
TRACED BY: <i>edk</i>		
CHECKED BY: <i>SW</i>		
SUBMITTED BY: <i>Elmer S. Barrett</i>		
RECOMMENDED: <i>James J. Barnes</i>		
APPROVED: <i>James J. Barnes</i>		
DATE: AUGUST 1959		
ELMER S. BARRETT ASSOCIATES CONSULTING ENGINEERS CHILLICOTHE, OHIO		
SCALE: 1" = 50'		
SPEC. NO. 027f-UD15-68/1		
SHEET 1 OF 27		

WORK AS CONSTRUCTED T. 409 60-170