


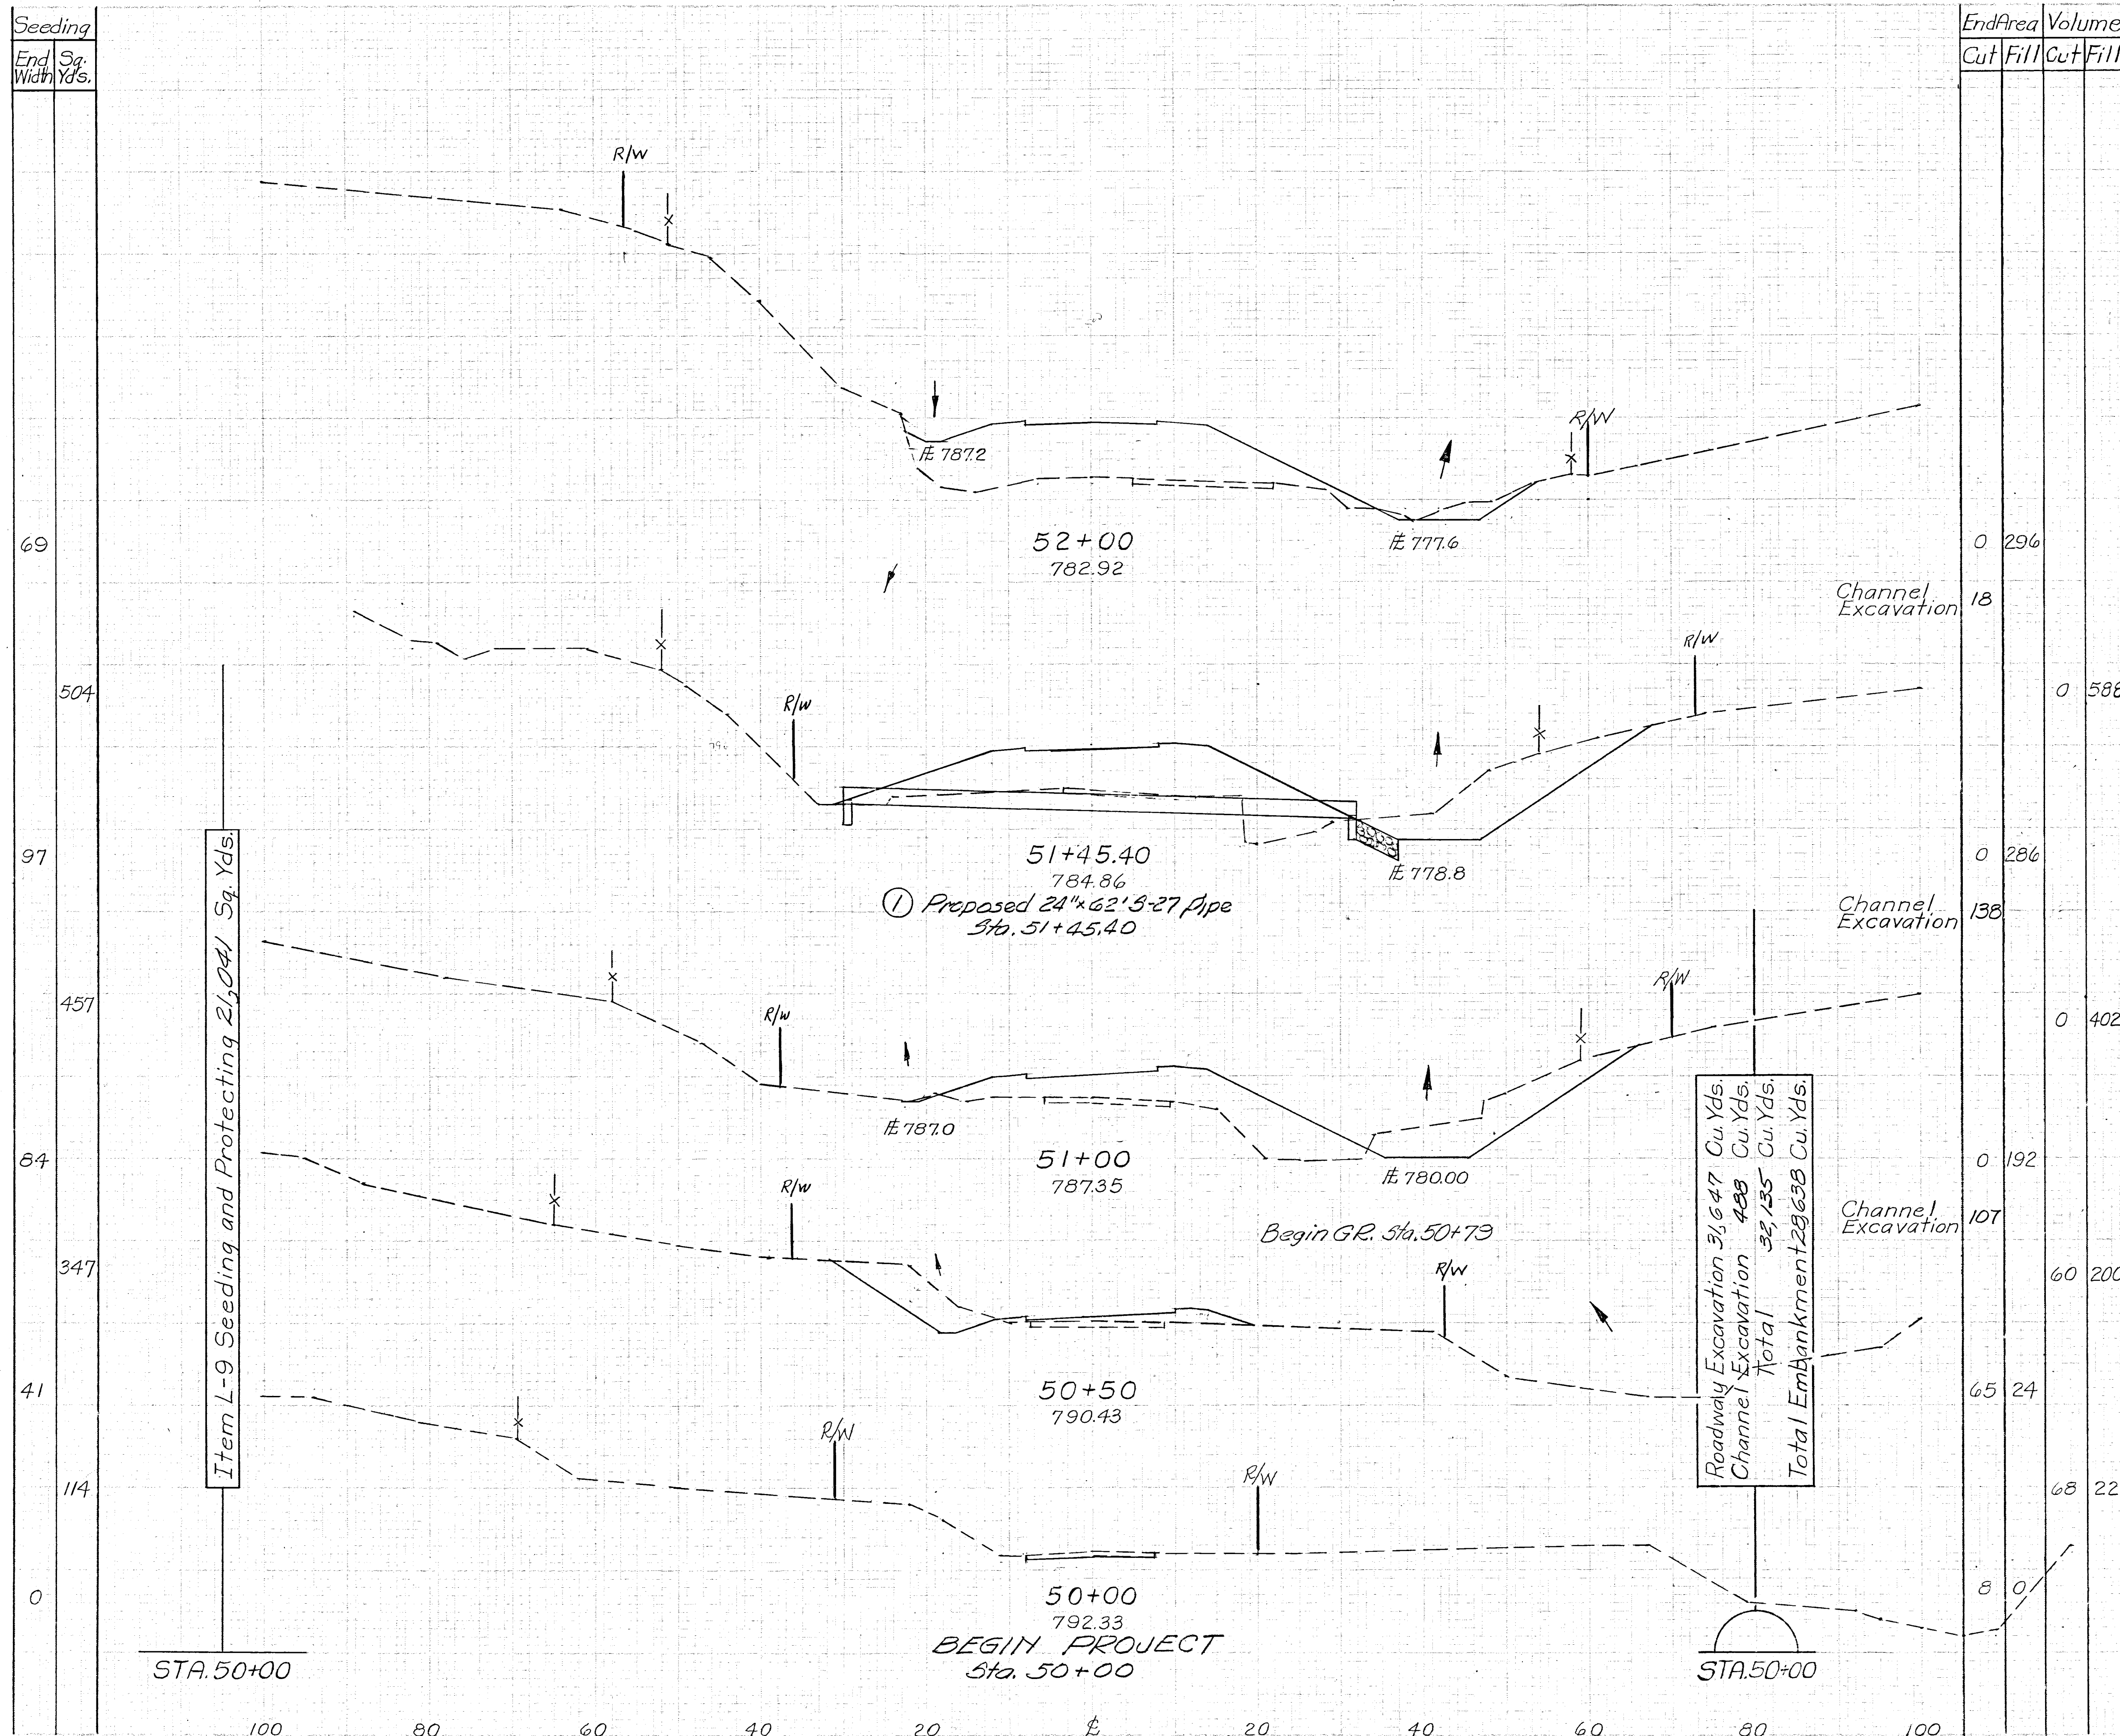

End Area		Volume	
Cut	Fill	Cut	Fill
0	296	0	296
0	586	0	586
0	286	0	286
0	402	0	402
0	192	0	192
0	107	0	107
60	200	60	200
65	24	65	24
68	22	68	22
8	0	8	0

Channel Excavation	
End Area	Volume
52+75.58	0
	25
	13
	153
	133
	206
	107
50+50	0

Roadway Excavation 31,647 Cu. Yds.
Channel Excavation 433 Cu. Yds.
Total 32,080 Cu. Yds.
Total Embankment 129,638 Cu. Yds.

REVISION	DATE	DESCRIPTION	BY
	3/20/62	AS CONSTRUCTED	H.F.K.
U. S. ARMY ENGINEER DISTRICT, HUNTINGTON CORPS OF ENGINEERS HUNTINGTON, W. VA.			
DRAWN BY:		LICKING RIVER DILLON RESERVOIR PROJECT	
TRACED BY:		RELOCATION OF TOWNSHIP ROAD NO. 409 (MT-409-2)	
CHECKED BY: <i>SEW</i>		DATE: AUGUST 1959	
SUBMITTED BY: <i>SEW</i>		APPROVED: <i>[Signature]</i>	
RECOMMENDED: <i>[Signature]</i>		ELMER S. BARRETT ASSOCIATES CONSULTING ENGINEERS CHILLICOTHE, OHIO	
SCALE: 1" = 10'		SHEET 15 OF 27	

WORK AS CONSTRUCTED CROSS SECTIONS STA. 50+00 TO STA. 52+00