


Seeding	End Width	Sq. Yds.
	60	
	318	
	74	
	560	
	102	
	489	
	74	
	386	
	65	
	361	
	65	

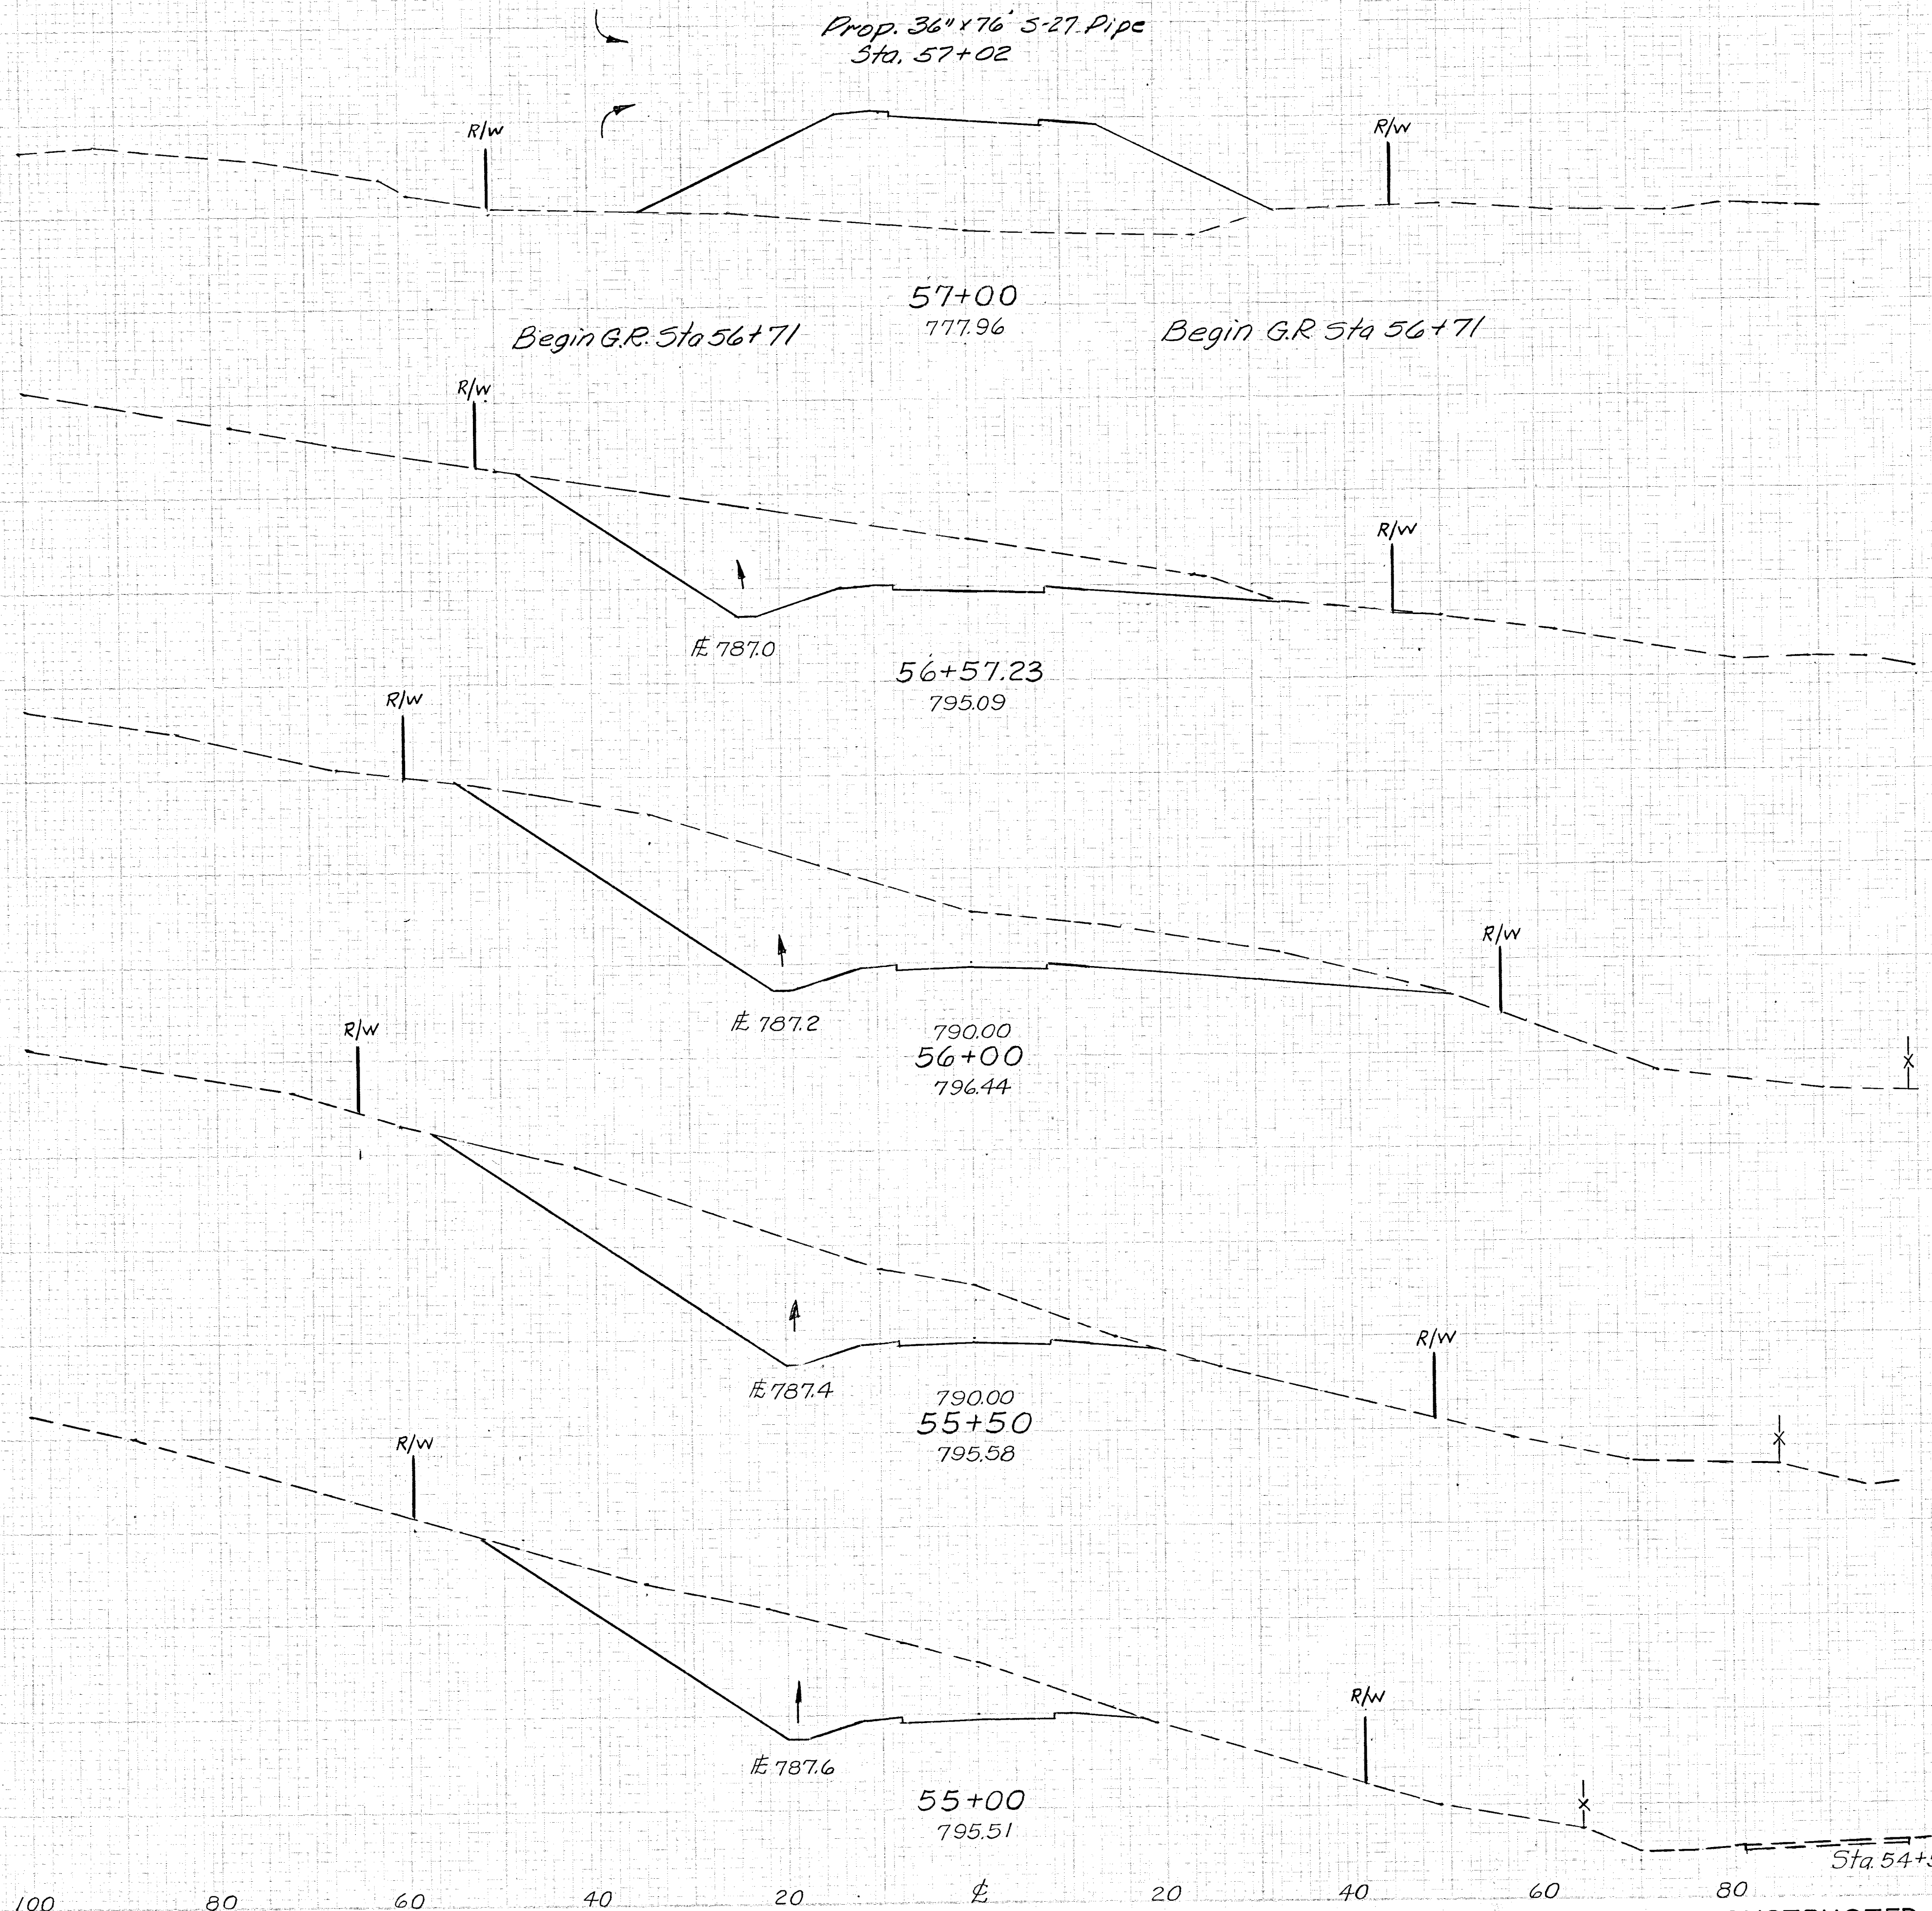

End Area	Volume
Cut	Fill
0	579
339	459
428	0
1149	0
656	0
1094	0
525	0
907	0
455	0
418	0
808	0

3/20/62		AS CONSTRUCTED		H.F.K.
REVISION	DATE	DESCRIPTION		BY
U. S. ARMY ENGINEER DISTRICT, HUNTINGTON CORPS OF ENGINEERS HUNTINGTON, W. VA.				
DRAWN BY:		LICKING RIVER DILLON RESERVOIR PROJECT RELOCATION OF TOWNSHIP ROAD NO. 409 (MT-409-2)		
TRACED BY:				
CHECKED BY: <i>SEW</i>				
SUBMITTED BY: <i>Elmer S. Barrett</i>				
ELMER S. BARRETT ASSOCIATES		APPROVED: <i>[Signature]</i> COL. C.E. DISTRICT ENGINEER		
RECOMMENDED: <i>[Signature]</i> CHIEF ENG. DIV.		DATE: AUGUST 1959		
ELMER S. BARRETT ASSOCIATES CONSULTING ENGINEERS CHILLICOTHE, OHIO		SCALE: 1" = 10' SPEC. NO. DRAWING NUMBER 027f-UD15-68/17 SHEET 17 OF 27		

WORK AS CONSTRUCTED CROSS SECTIONS STA. 55+00 TO STA. 57+00