


Seeding
End Sq.
Width Yds.

End Area
Cut Fill Cut Fill

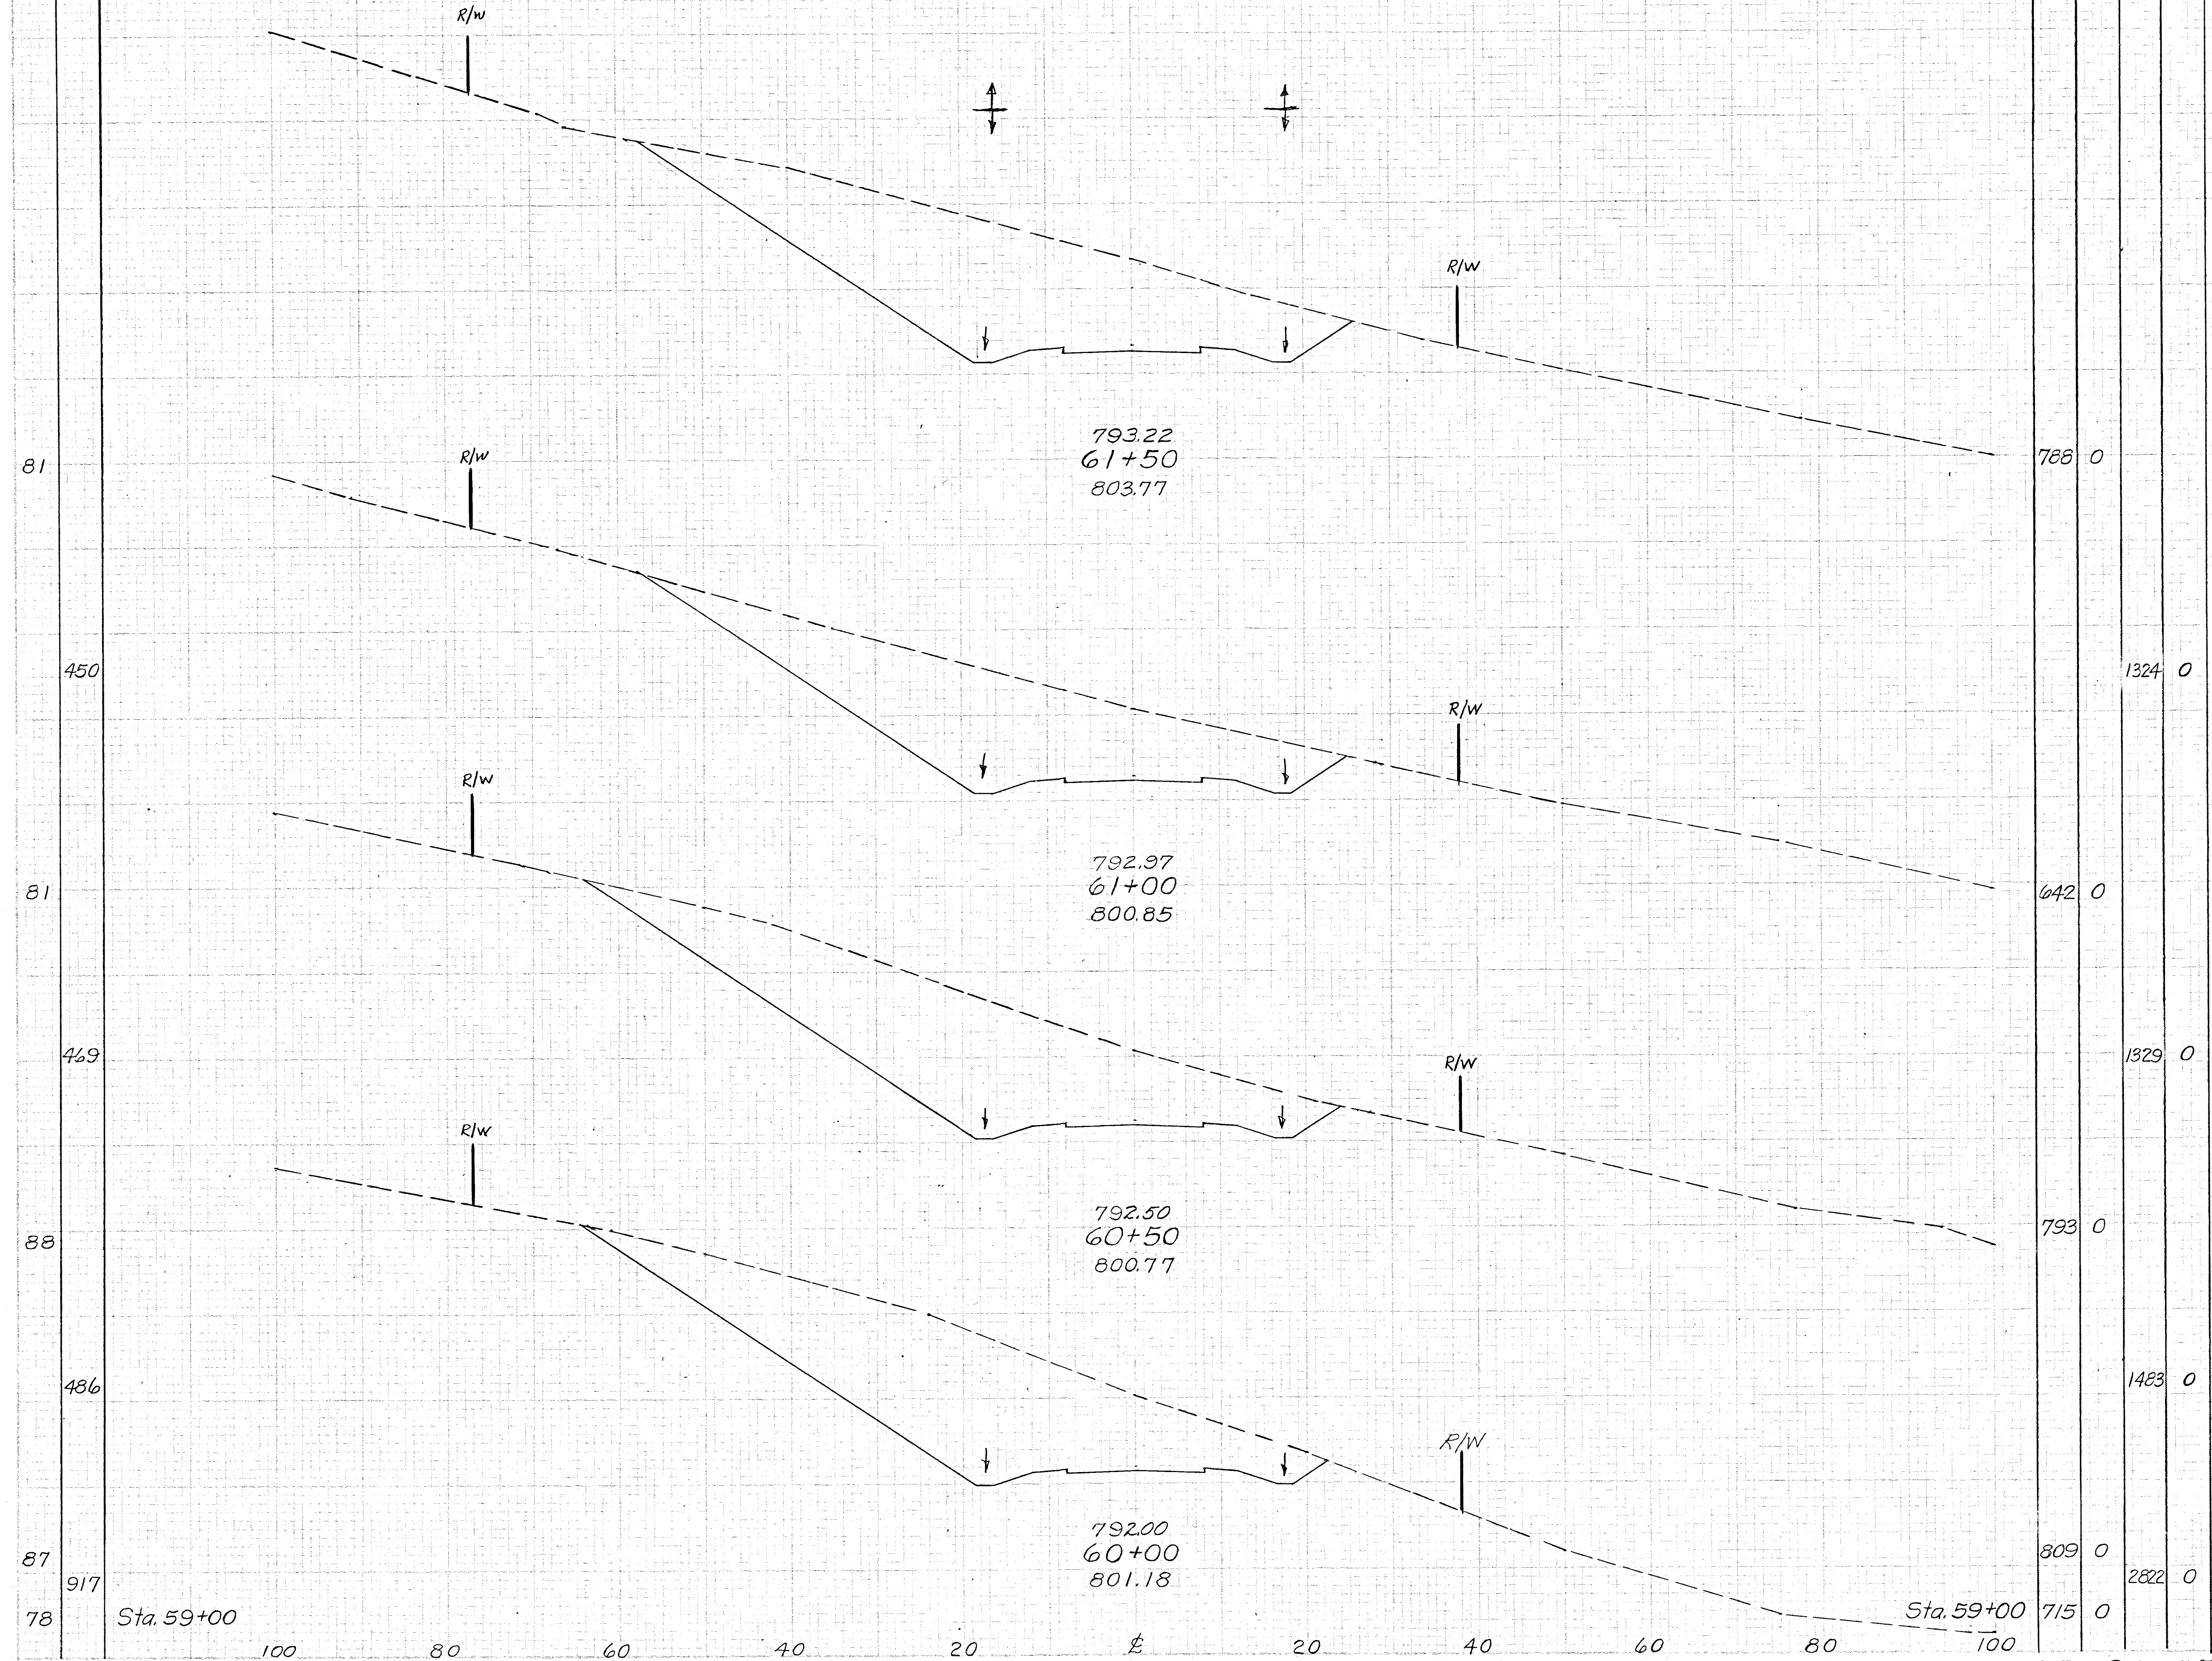

REVISION	DATE	DESCRIPTION	BY
	3/20/62	AS CONSTRUCTED	H.F.K.
U. S. ARMY ENGINEER DISTRICT, HUNTINGTON CORPS OF ENGINEERS HUNTINGTON, W. VA.			
DRAWN BY:		LICKING RIVER DILLON RESERVOIR PROJECT	
TRACED BY:		RELOCATION OF TOWNSHIP ROAD NO. 409	
CHECKED BY: <i>SW</i>		(MT-409-2)	
SUBMITTED BY: <i>Elmer S. Barrett</i>		DATE: AUGUST 1959	
ELMER S. BARRETT ASSOCIATES		APPROVED: <i>A. J. [Signature]</i> CHIEF ENG. DIV.	
RECOMMENDED: <i>James H. [Signature]</i>		SPEC. NO.	
ELMER S. BARRETT ASSOCIATES CONSULTING ENGINEERS CHILLICOTHE, OHIO		DRAWING NUMBER 027f-UD15-68/19	
SCALE: 1" = 10'		SHEET 19 OF 27	

WORK AS CONSTRUCTED CROSS SECTIONS STA. 60+00 TO STA. 61+50