


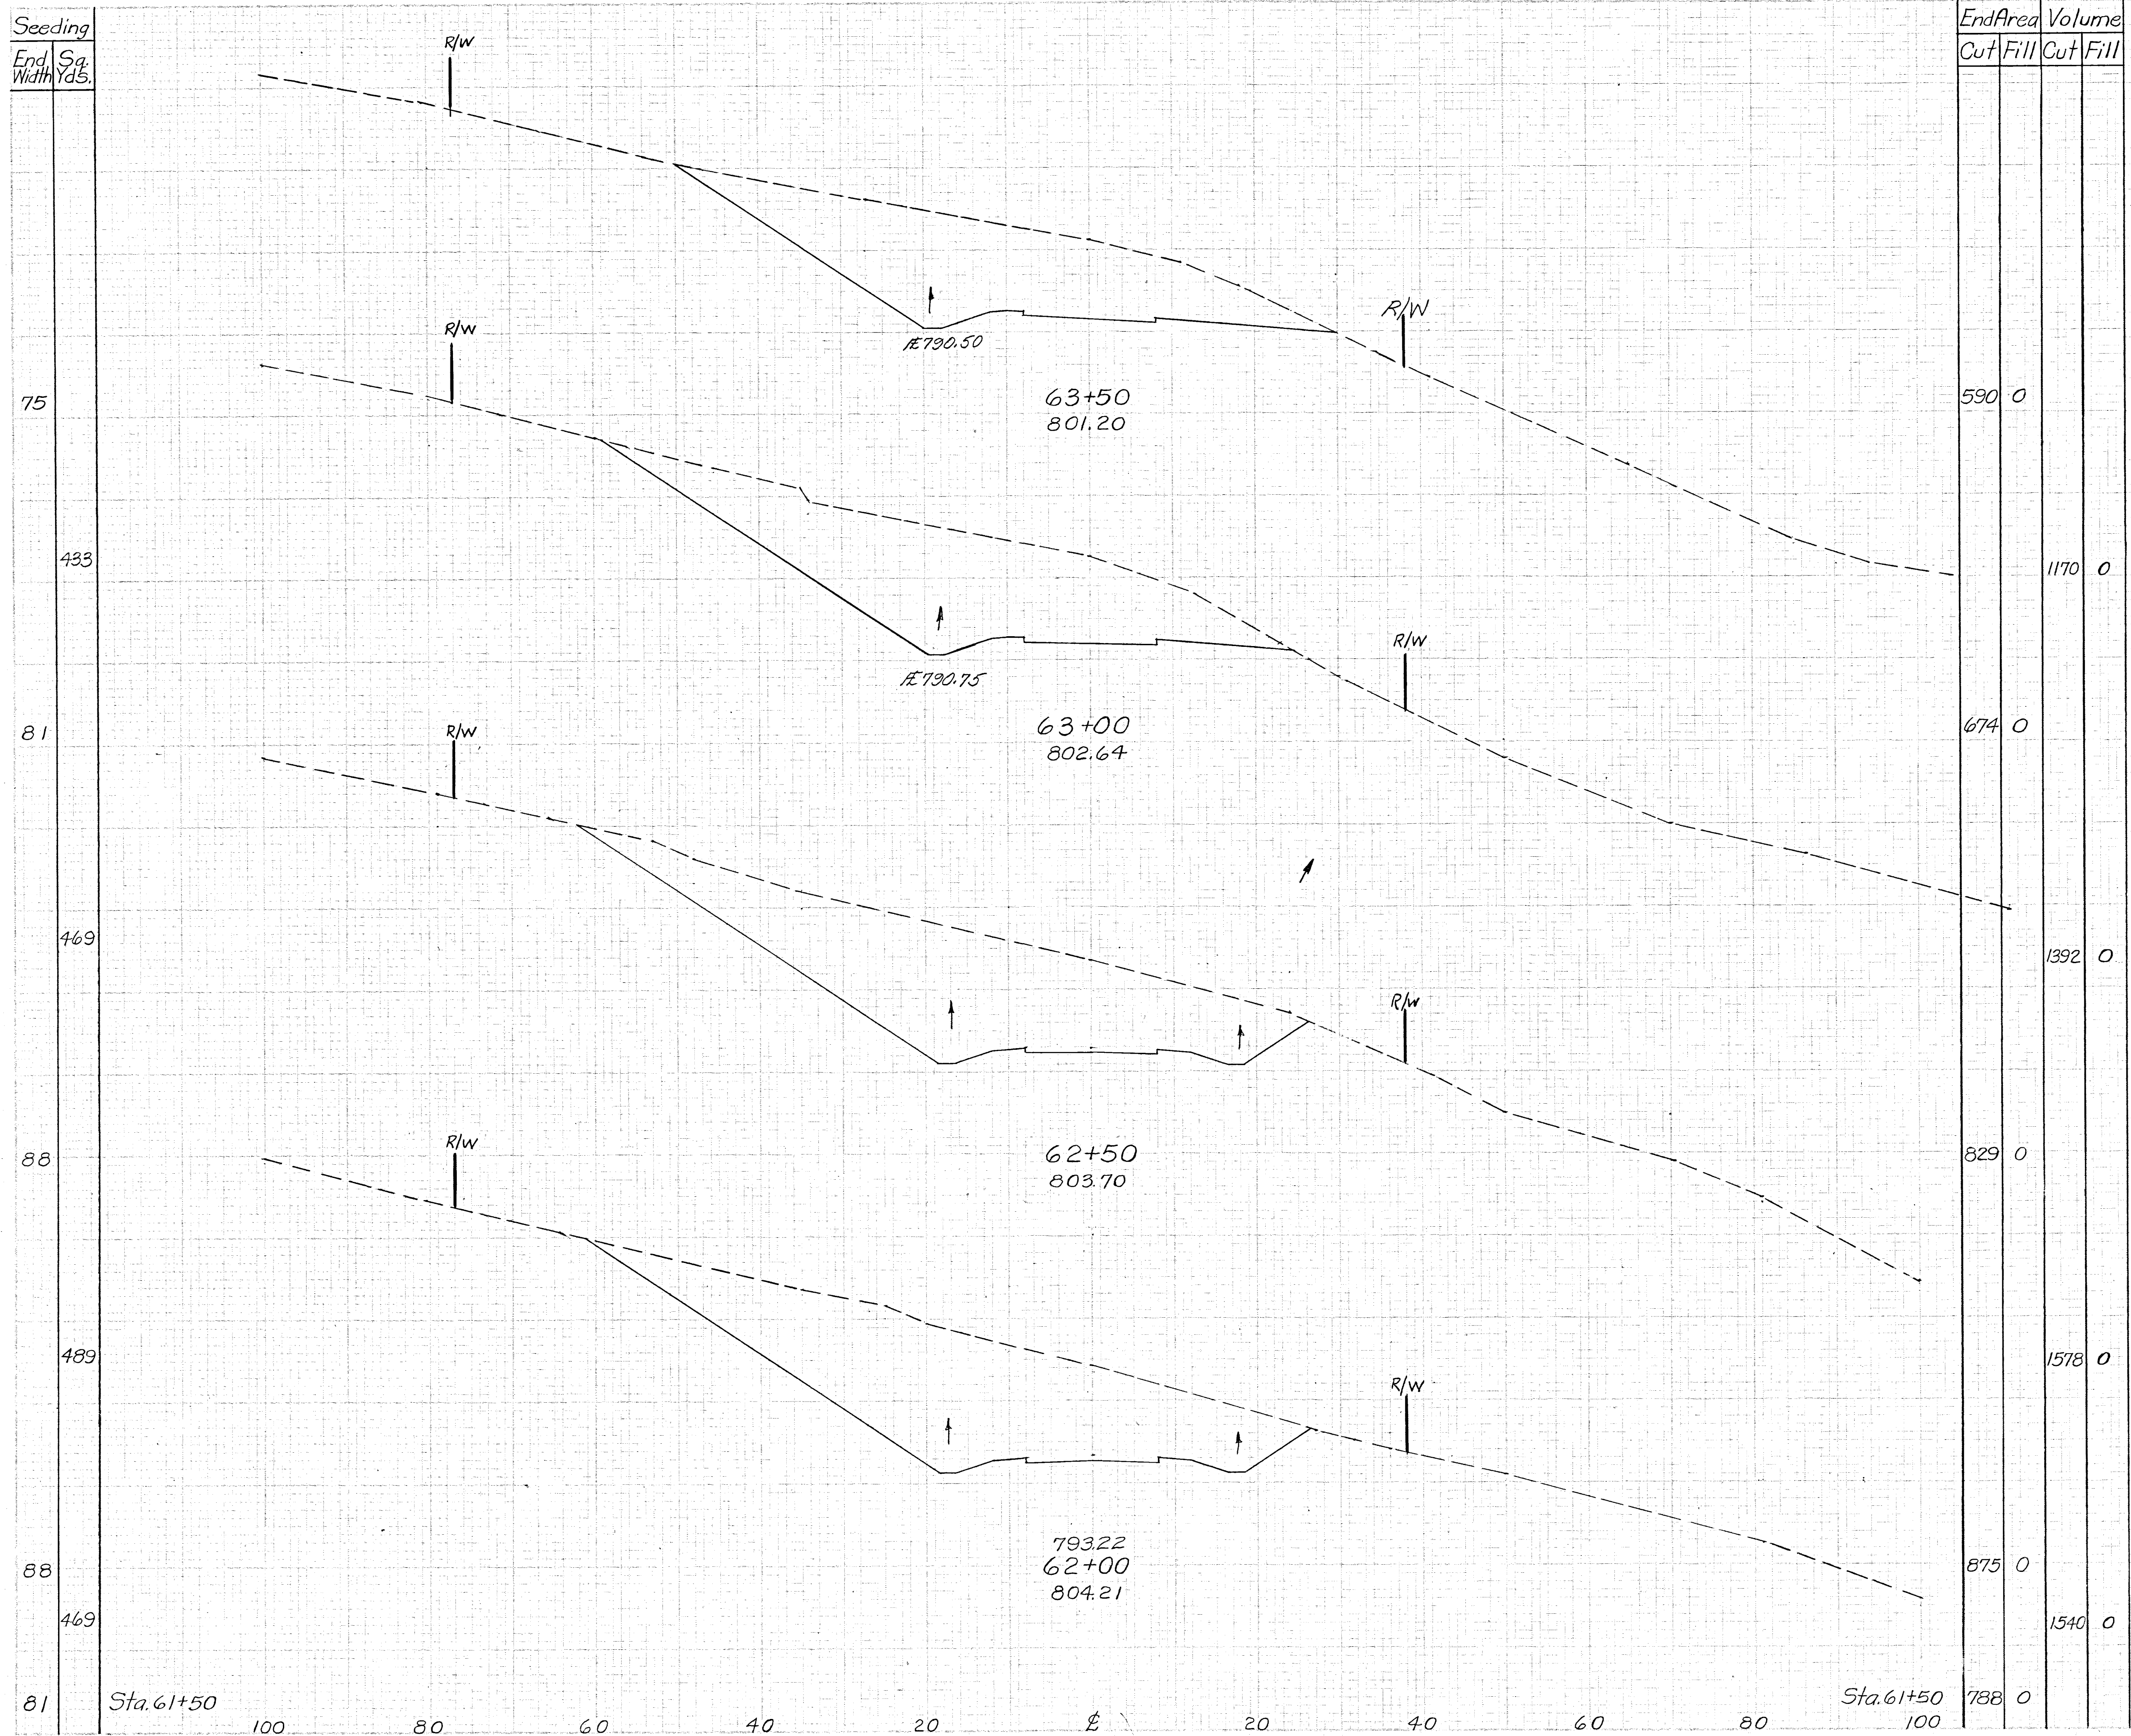

End Area		Volume	
Cut	Fill	Cut	Fill
788	0	1540	0
875	0	829	0
1392	0	674	0
1170	0	590	0

3/20/62		AS CONSTRUCTED		H.F.K.
REVISION	DATE	DESCRIPTION		BY
U. S. ARMY ENGINEER DISTRICT, HUNTINGTON CORPS OF ENGINEERS HUNTINGTON, W. VA.				
DRAWN BY:		LICKING RIVER DILLON RESERVOIR PROJECT		
TRACED BY:		RELOCATION OF TOWNSHIP ROAD NO. 409 (MT-409-2)		
CHECKED BY: SEW		DATE: AUGUST 1959		
SUBMITTED BY: [Signature]		APPROVED: [Signature] DISTRICT ENGINEER		
ELMER S. BARRETT ASSOCIATES		SCALE: 1"=10'		
RECOMMENDED: [Signature]		SPEC. NO.		
CHIEF ENG. DIV.		DRAWING NUMBER		
ELMER S. BARRETT ASSOCIATES CONSULTING ENGINEERS CHILLICOTHE, OHIO		027f-UD15-68/20		
		SHEET 20 OF 27		

WORK AS CONSTRUCTED CROSS SECTIONS STA. 62+00 TO STA. 63+50