


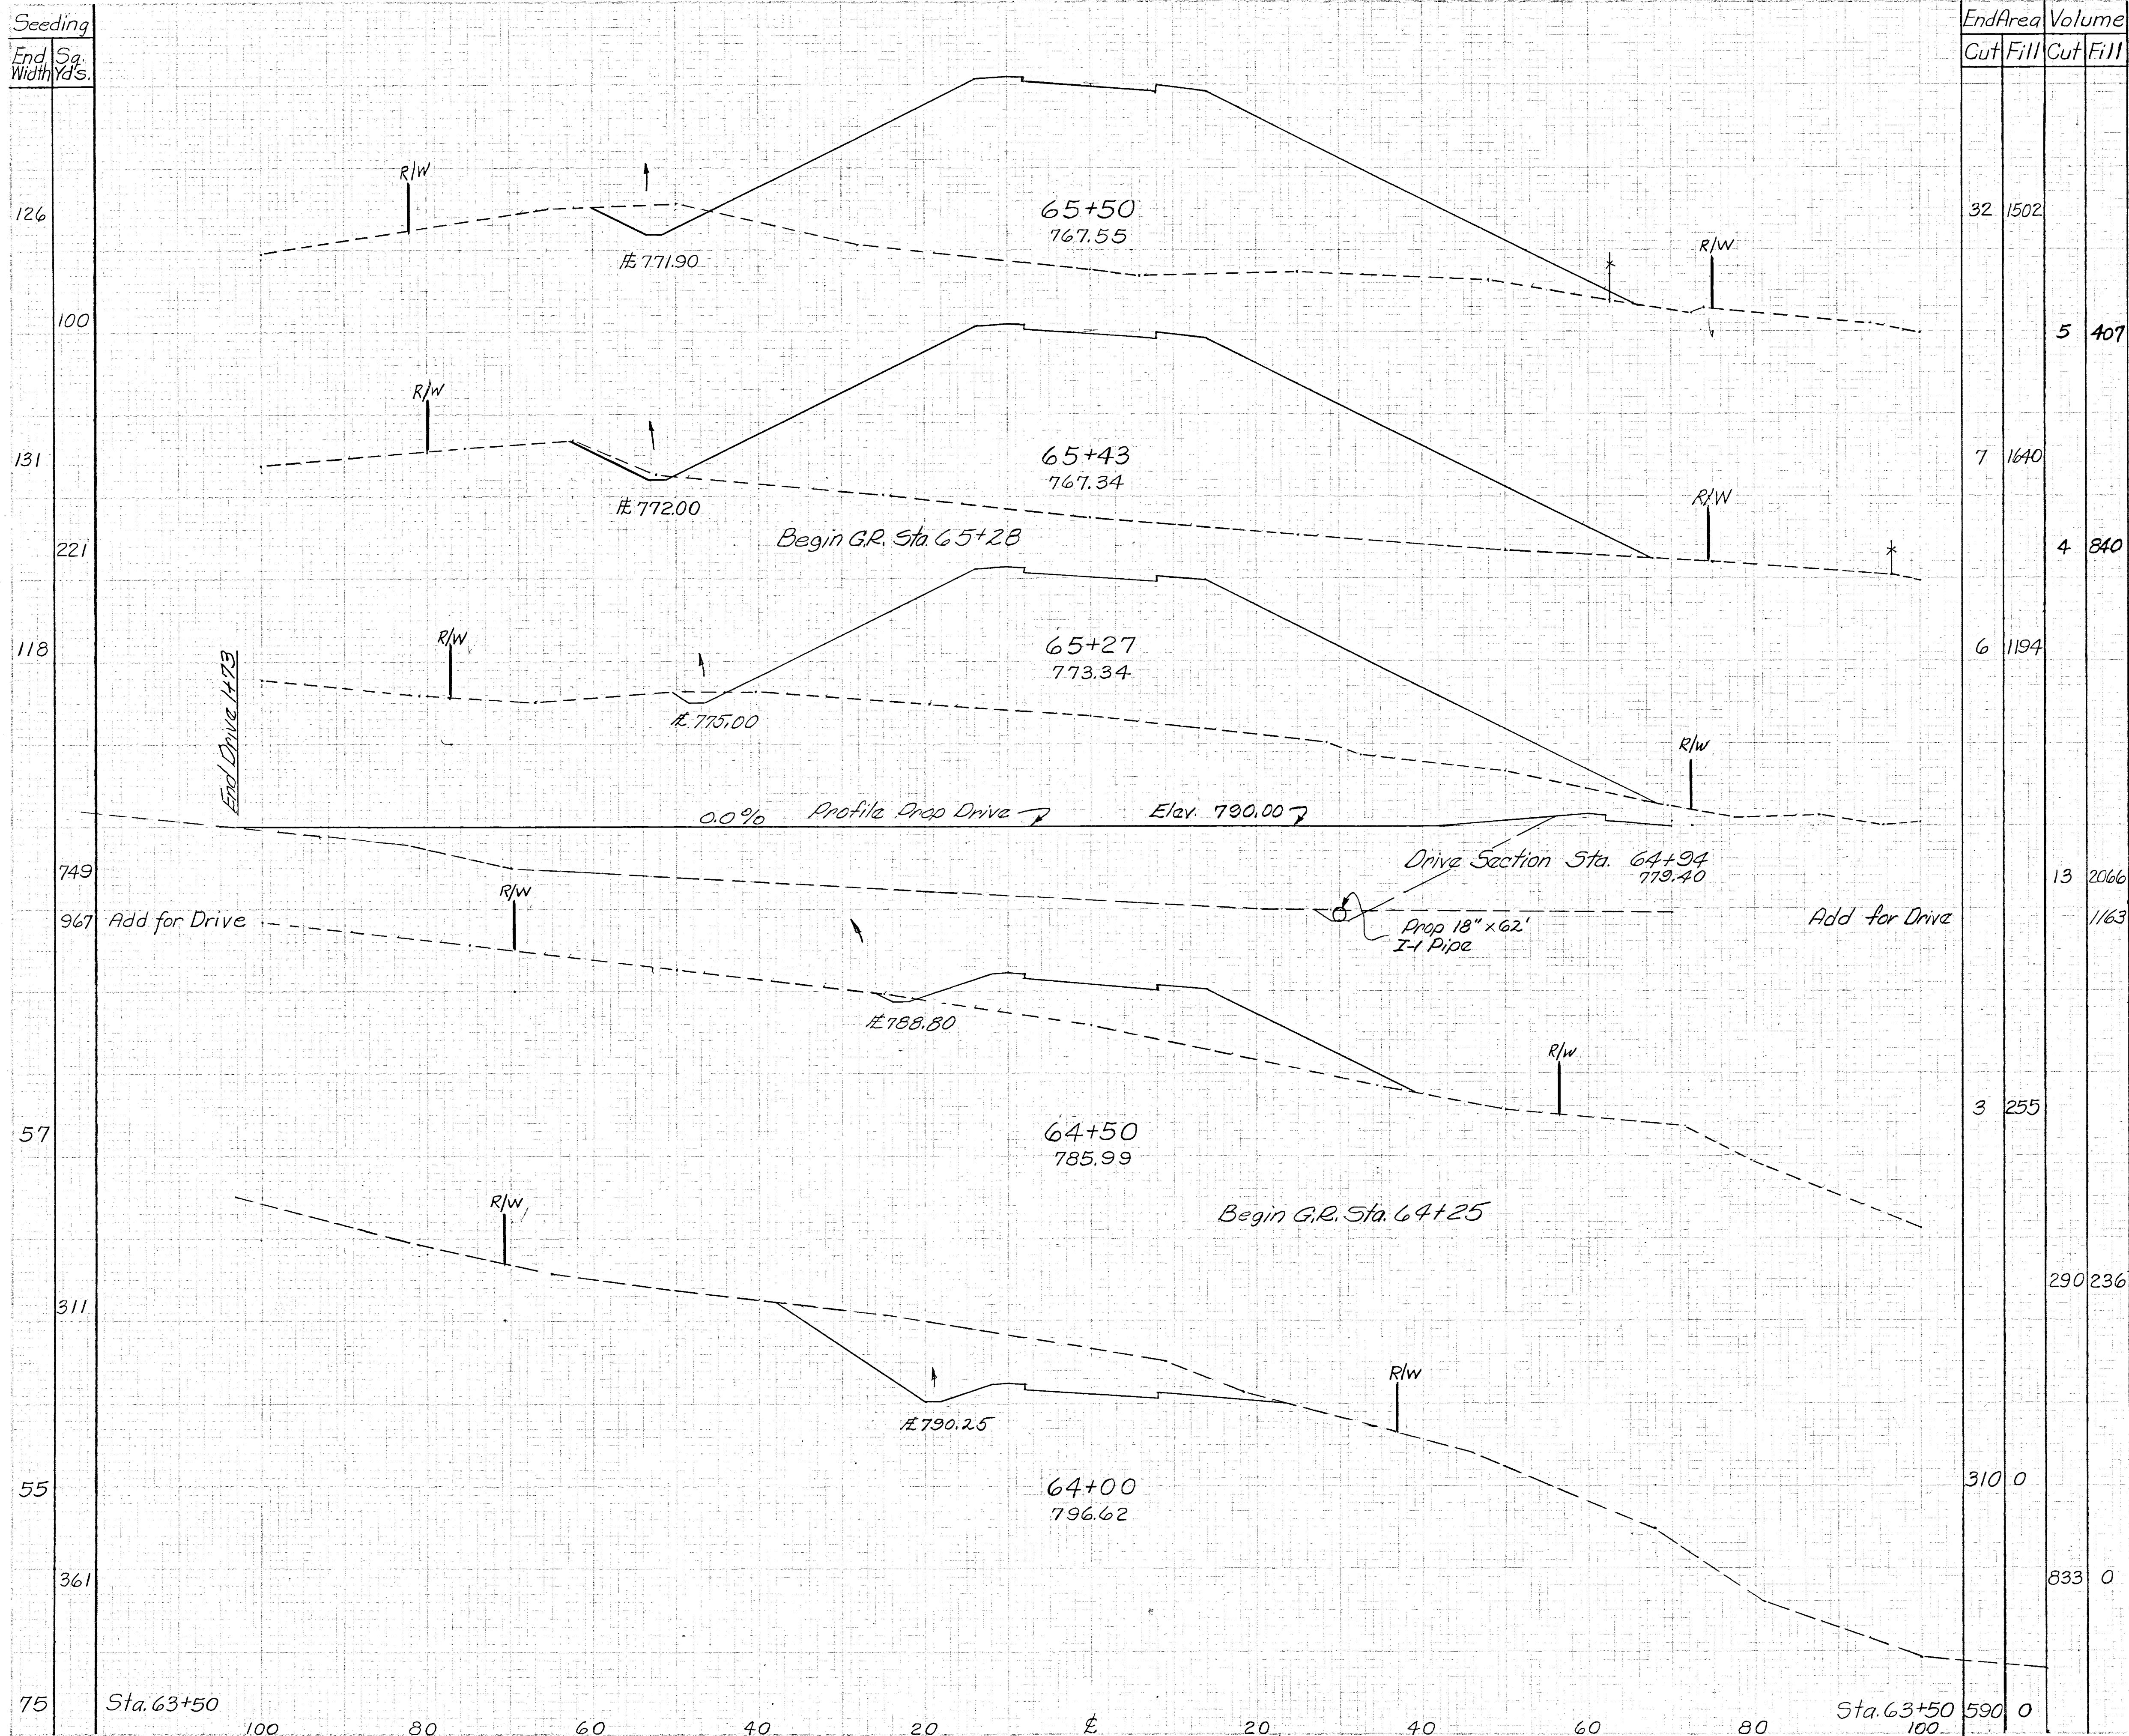

MUSKINGUM COUNTY
TOWNSHIP ROAD NO. 409

REVISION	DATE	DESCRIPTION	BY
3/20/62	AS CONSTRUCTED		H.F.K.
U. S. ARMY ENGINEER DISTRICT, HUNTINGTON CORPS OF ENGINEERS HUNTINGTON, W. VA.			
DRAWN BY:		LICKING RIVER DILLON RESERVOIR PROJECT	
CHECKED BY: SEW		RELOCATION OF TOWNSHIP ROAD NO. 409	
SUBMITTED BY: Elmer S. Barrett Associates		(MT-409-2)	
RECOMMENDED: James H. Barrett		APPROVED: J. J. Barrett	
CHIEF ENG. DIV.		DISTRICT ENGINEER	
ELMER S. BARRETT ASSOCIATES CONSULTING ENGINEERS CHILLICOTHE, OHIO		DATE: AUGUST 1959	
SCALE: 1"=10'		SPEC. NO.	
DRAWING NUMBER		027f-UD15-68/21	
SHEET 21 OF 27			