


Seeding
End Sta.
Width Yds.

End Area
Cut Fill
Volume
Cut Fill

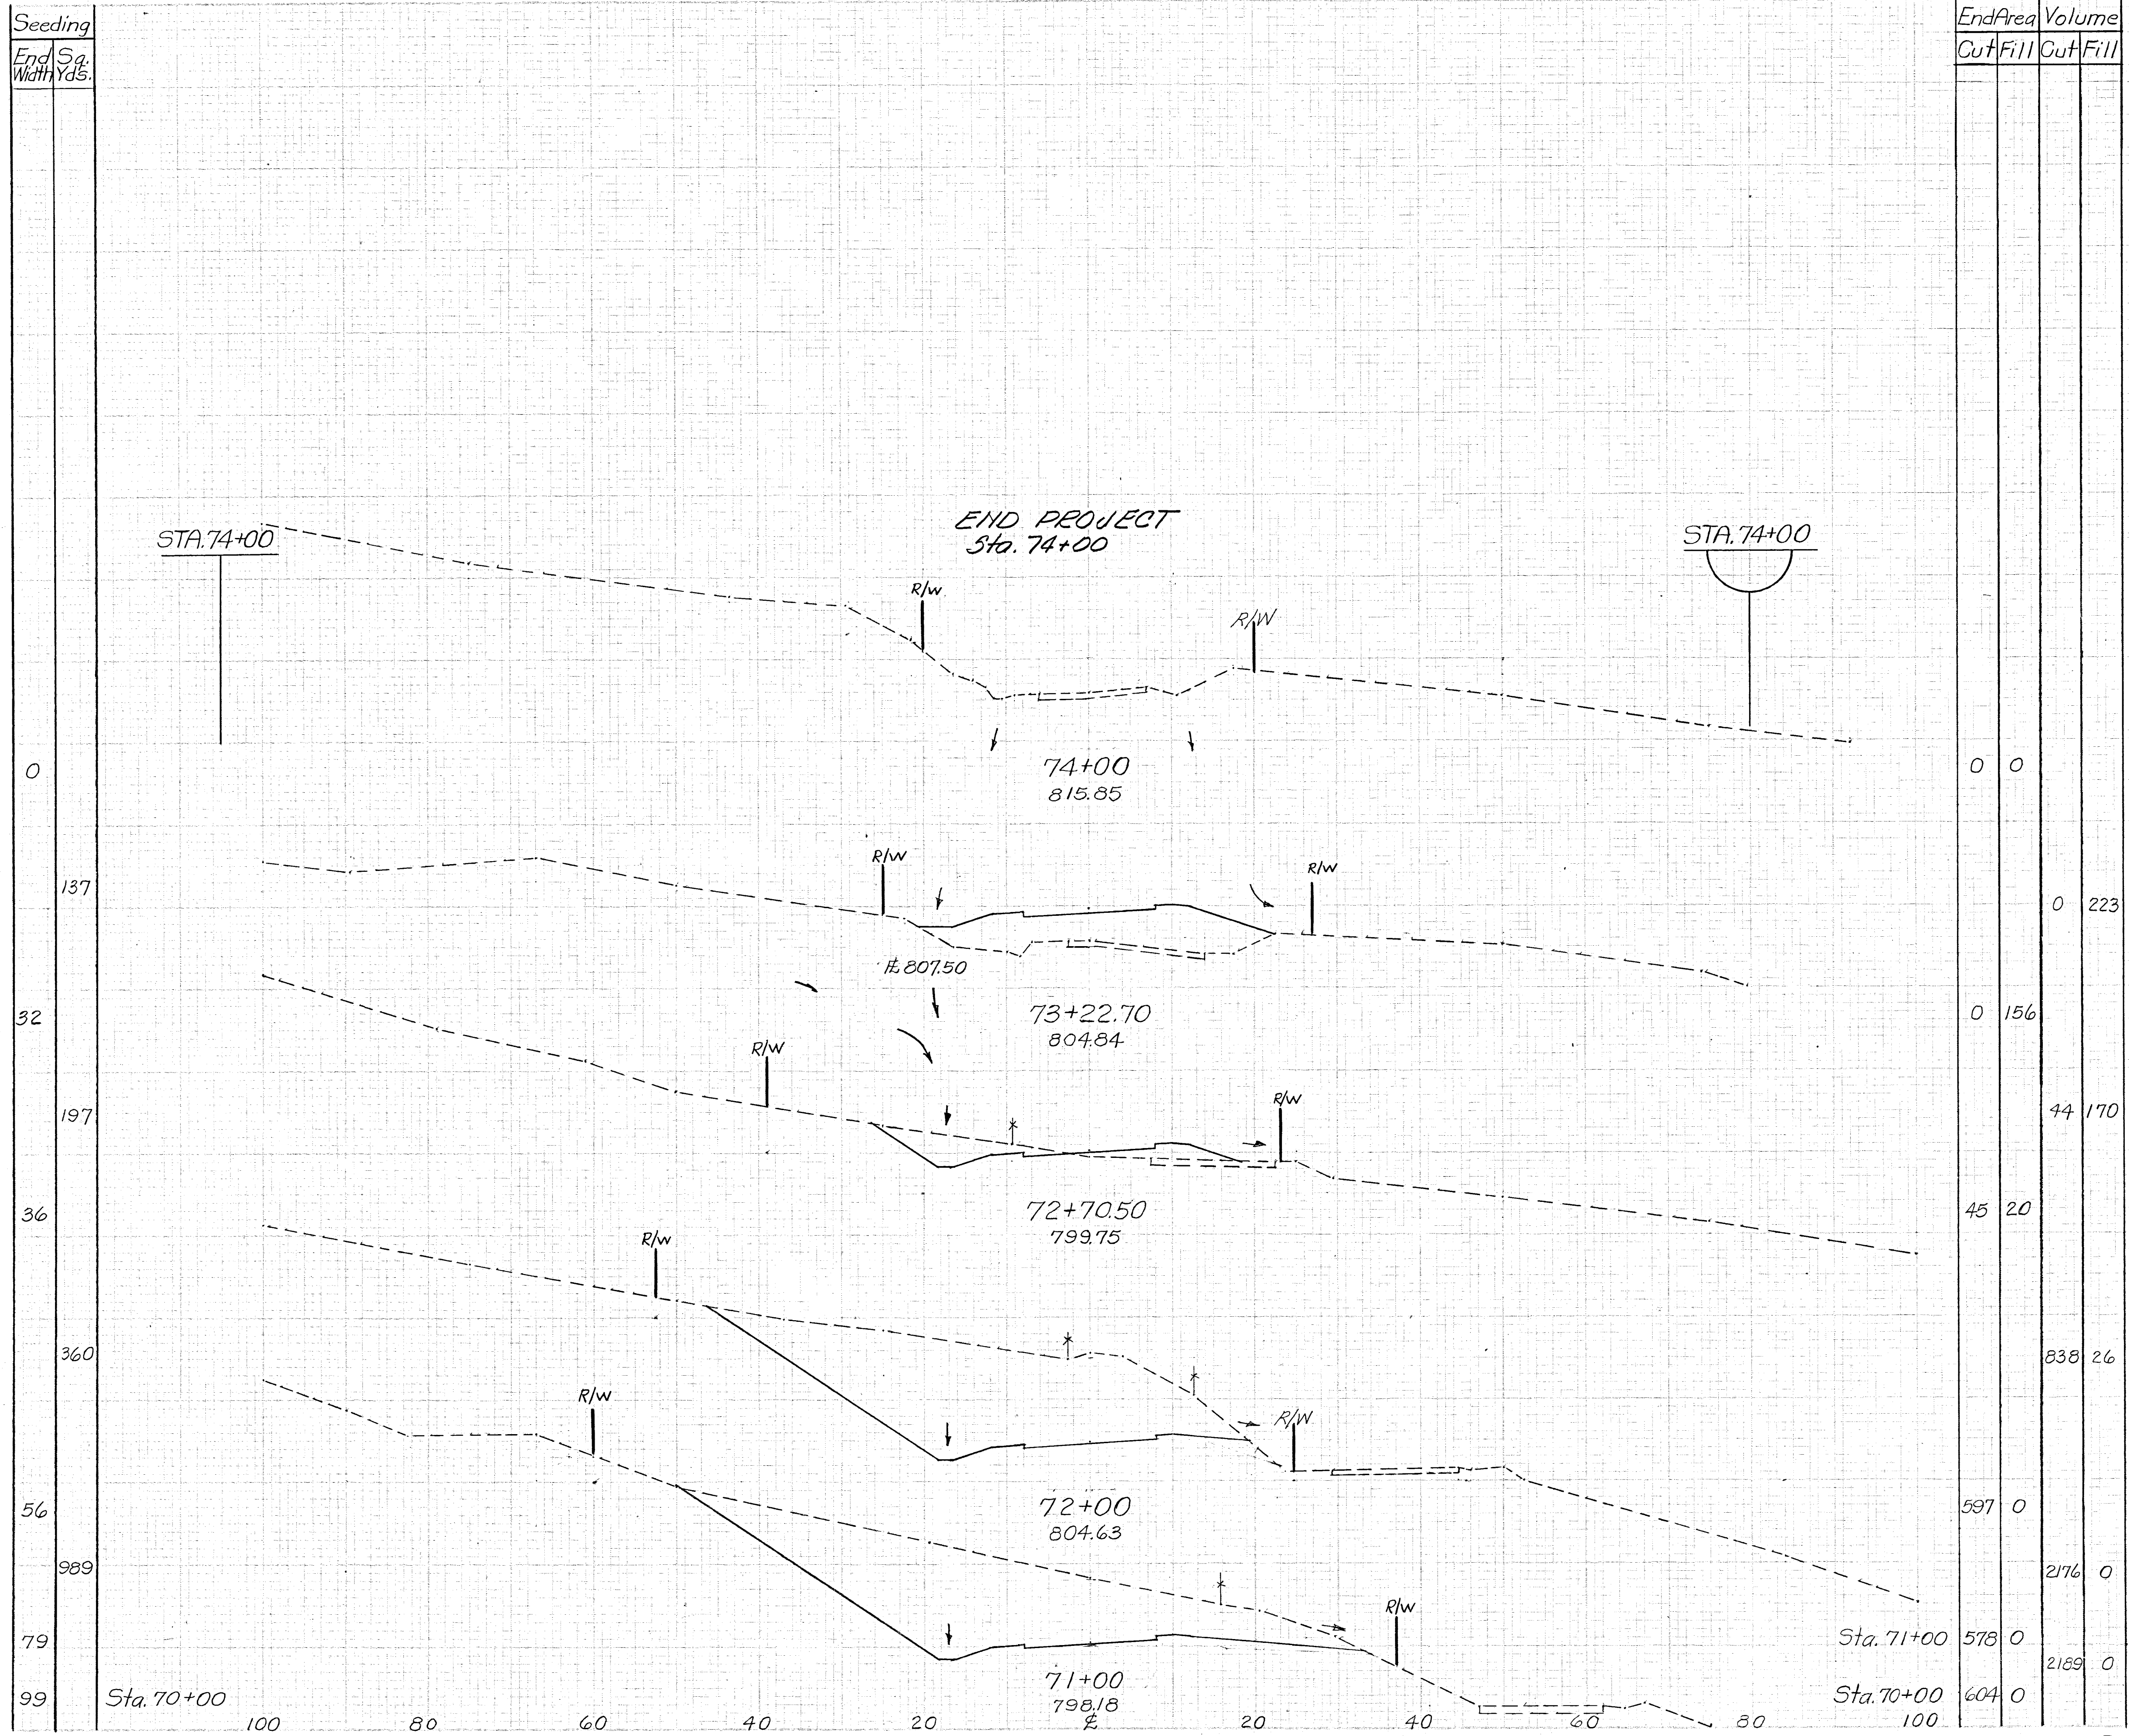

REVISION		DATE	DESCRIPTION	BY
3/20/62		AS CONSTRUCTED		H.F.K.
U. S. ARMY ENGINEER DISTRICT, HUNTINGTON CORPS OF ENGINEERS HUNTINGTON, W. VA.				
DRAWN BY:		LICKING RIVER DILLON RESERVOIR PROJECT		
TRACED BY:		RELOCATION OF TOWNSHIP ROAD NO. 409 (MT-409-2)		
CHECKED BY: <i>EW</i>		DATE: AUGUST 1959		
SUBMITTED BY: <i>EW</i>		APPROVED: <i>H. J. [Signature]</i> COL. C. E., DISTRICT ENGINEER		
RECOMMENDED: <i>James H. [Signature]</i> CHIEF ENG. DIV.		ELMER S. BARRETT ASSOCIATES CONSULTING ENGINEERS CHILLICOTHE, OHIO		
SCALE: 1" = 10'		SPEC. NO. DRAWING NUMBER 027f-UD15-68/24 SHEET 24 OF 27		

WORK AS CONSTRUCTED CROSS SECTIONS STA. 71+00 TO STA. 74+00