


SCHEMATIC PLAN

FED. RD. DIVISION	STATE	PROJECT	2
2	OHIO		26

MUSKINGUM COUNTY
TOWNSHIP ROADS NO. 47 & 60

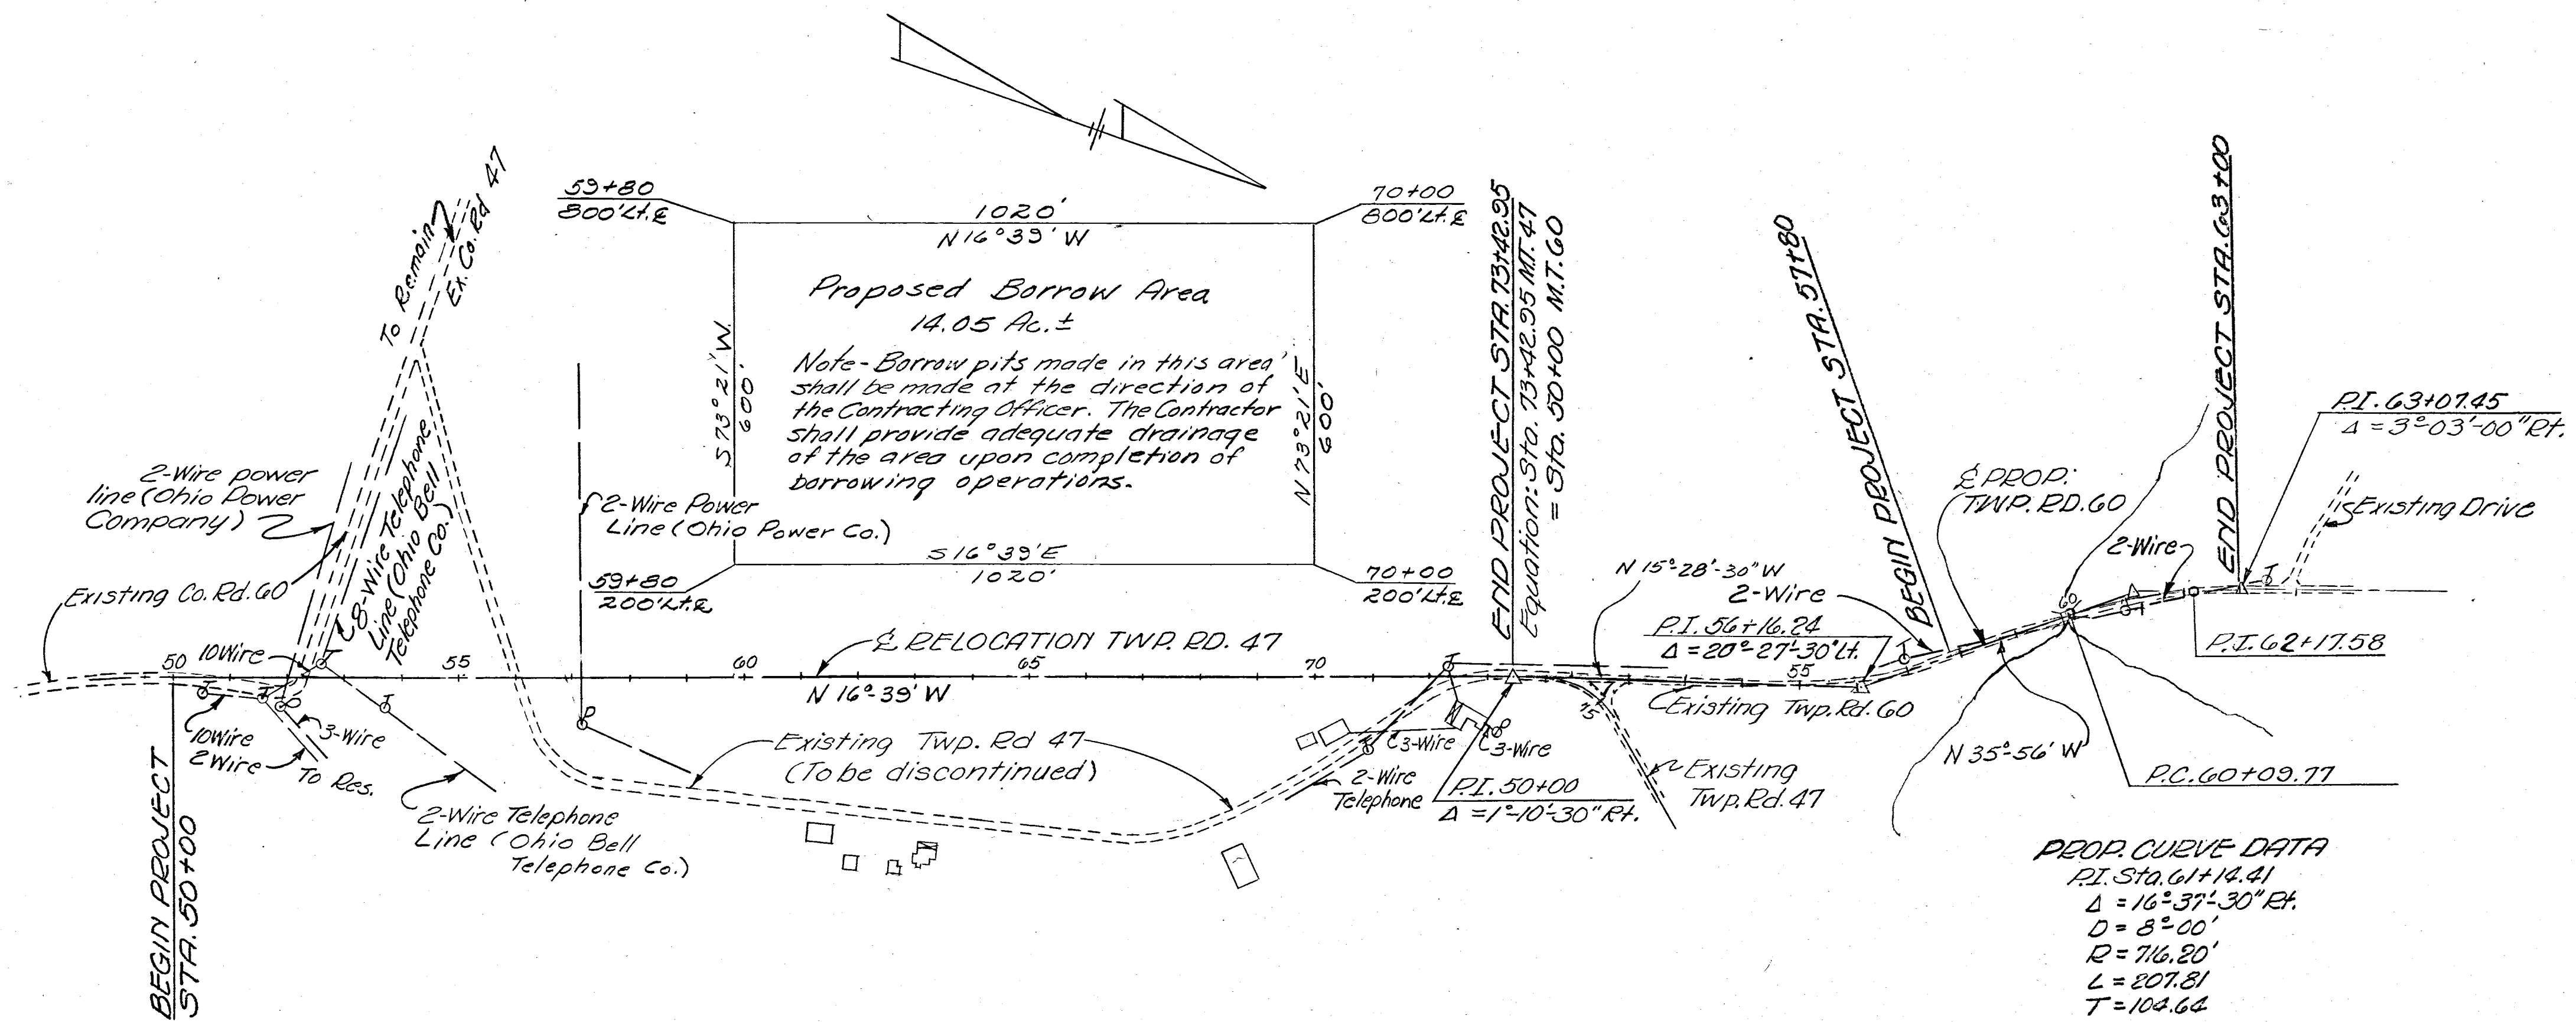

REVISION		DATE	DESCRIPTION	BY
U. S. ARMY ENGINEER DISTRICT, HUNTINGTON CORPS OF ENGINEERS HUNTINGTON, W. VA.				
DRAWN BY:		LICKING RIVER DILLON RESERVOIR PROJECT RELOCATION OF TOWNSHIP ROAD NO. 47 SECTION I (MT-47-1) READJUSTMENT OF TOWNSHIP ROAD NO. 60 SECTION I (MT-60-1)		
TRACED BY:				
CHECKED BY:				
SUBMITTED BY:				
ELMER S. BARRETT ASSOCIATES				
RECOMMENDED:		APPROVED:		DATE:
CHIEF ENG. DIV.		COL. C. E. DISTRICT ENGINEER		AUGUST 1959
ELMER S. BARRETT ASSOCIATES CONSULTING ENGINEERS CHILLICOTHE, OHIO		SCALE: 1" = 200'		SPEC. NO.
		DRAWING NUMBER		
		027f-UD10-68/2		
		SHEET 2 OF 26		

WORK AS CONSTRUCTED

SCHEMATIC PLAN