

REQ. NO. DIVIS. NO.	STATE	PROJECT
2	OHIO	

26


62

MUSKINGUM COUNTY
MUS-156-2.85

ROADWAY QUANTITIES

[illegible]

DRAINAGE QUANTITIES

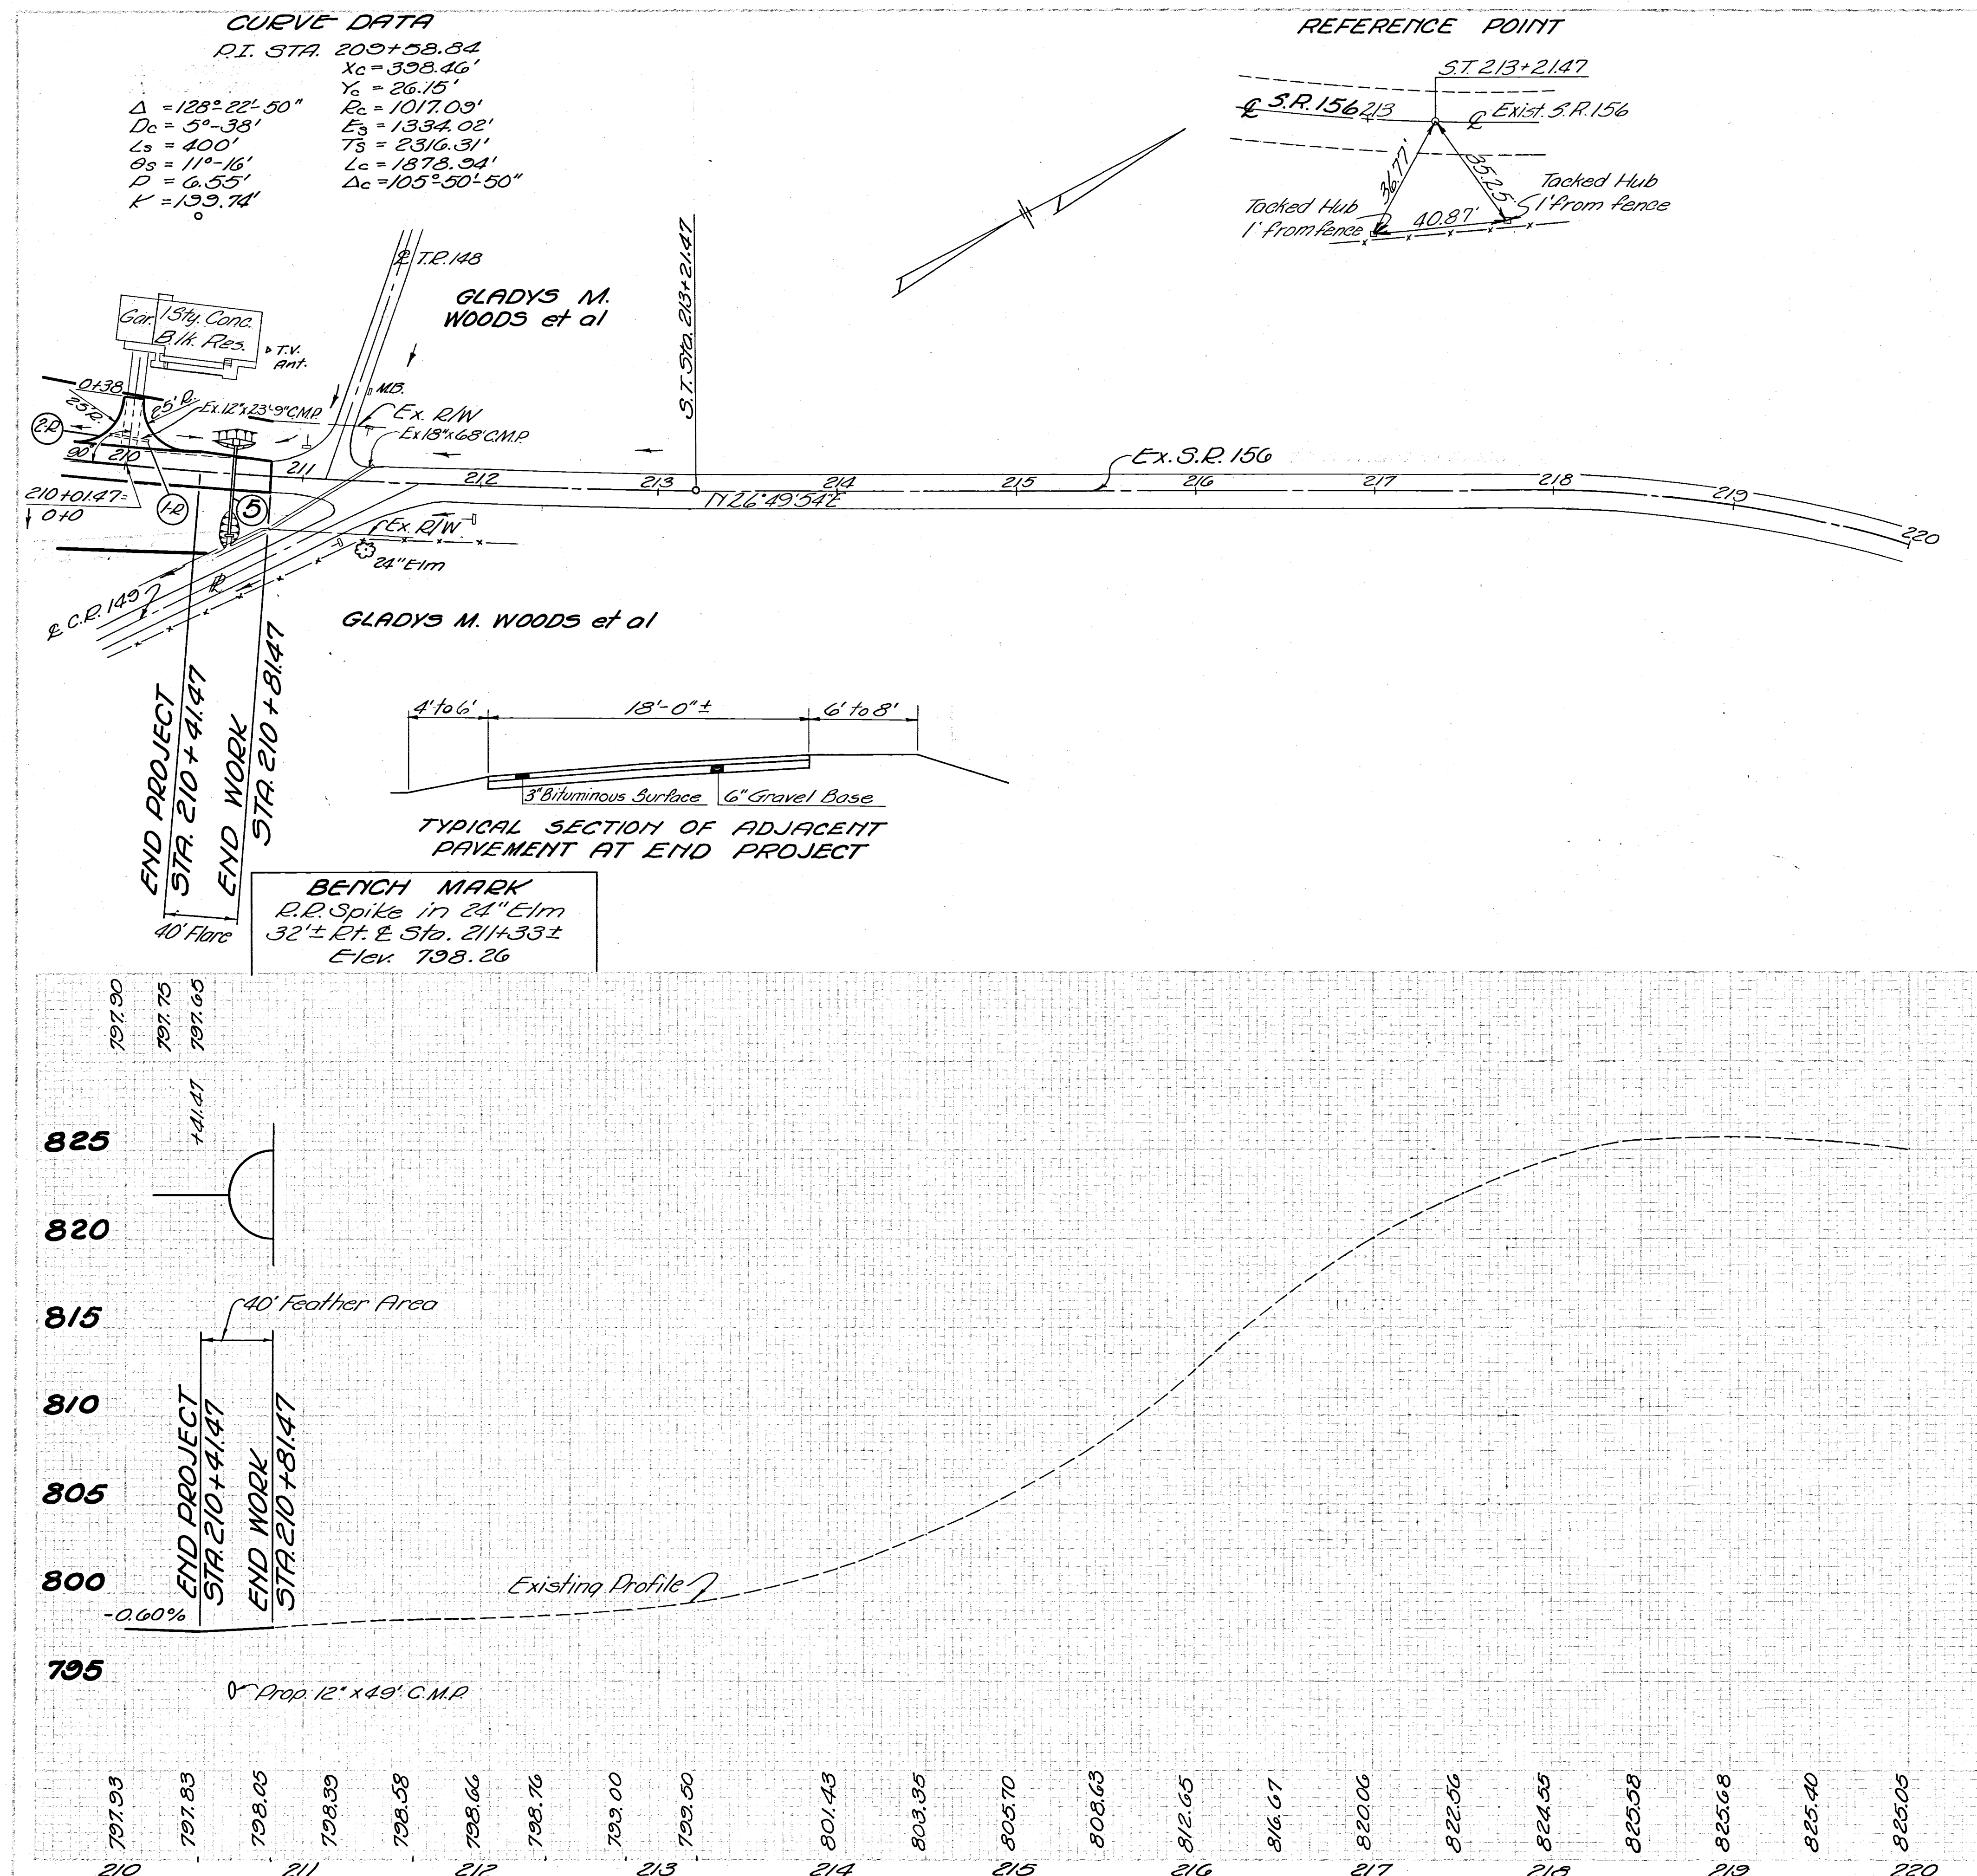[illegible]

REFERENCE POINT

S.T. 213+21.47

Q.S.R. 156213	Exist S.R. 156
---------------	----------------

Exist. S.R. 156

Tacked Hub


Tacked Hub
1' from fence

GLADYS M.
WOODS et al

GLADYS M. WOODS et al

TYPICAL SECTION OF ADJACENT
PAVEMENT AT END PROJECT

BENCH MARK
P.R. Spike in 24" Elm
2'± Rt. & Sto. 211+33±
Elev. 738.26

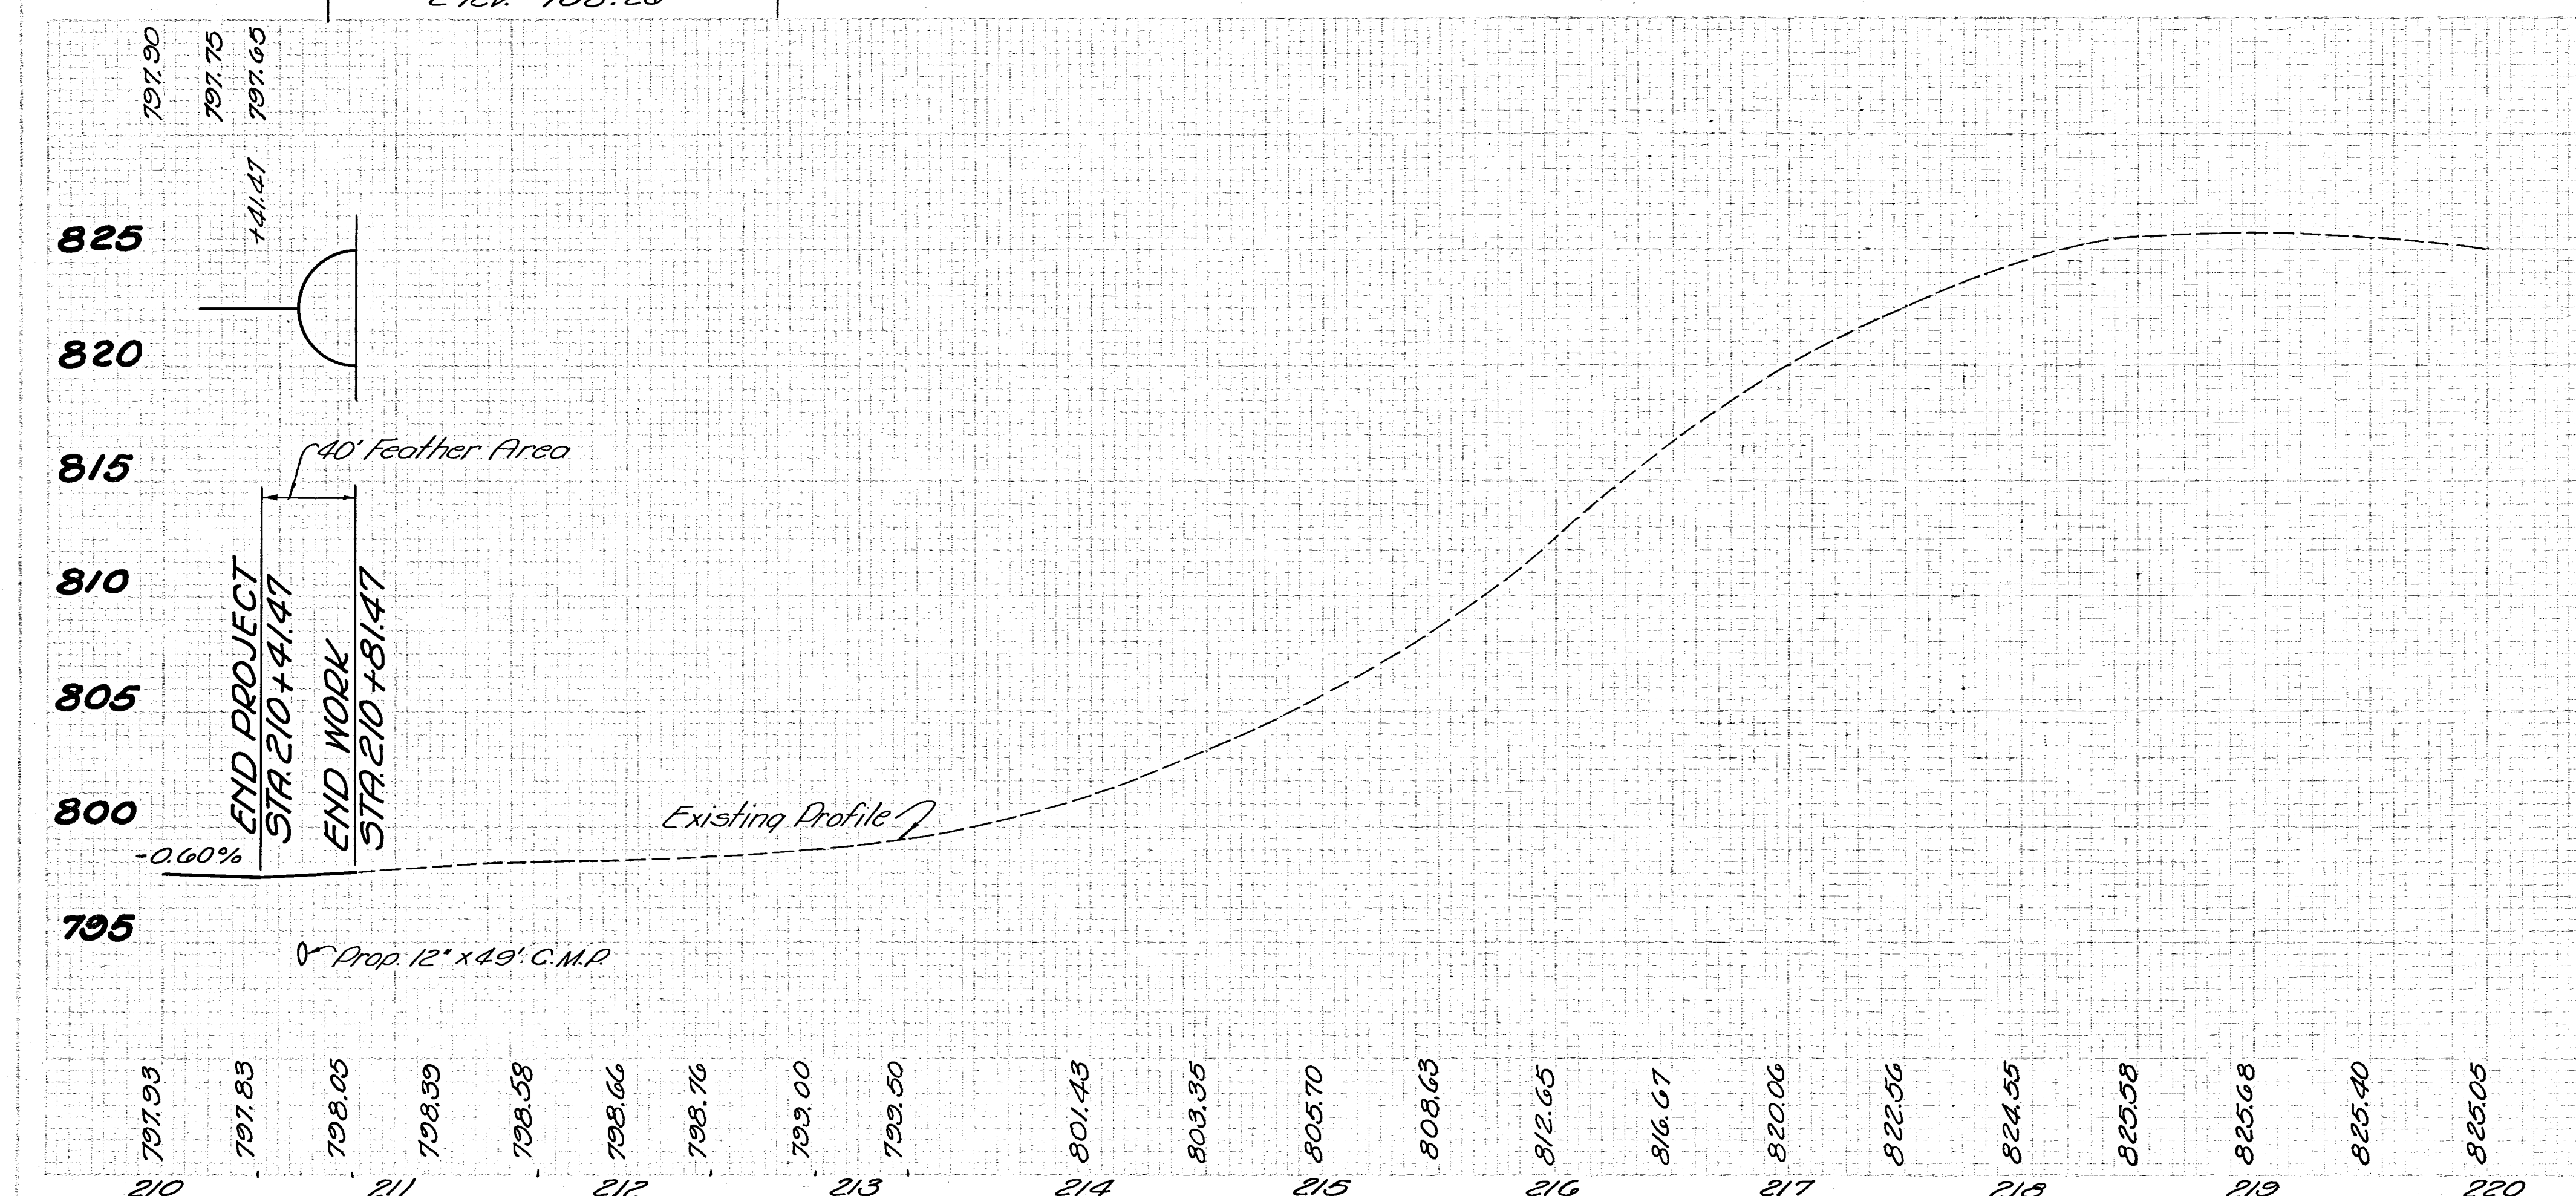

WORK AS CONSTRUCTED

PLAN & PROFILE - STA. 210+00 TO STA. 220+00

REVISION	DATE	DESCRIPTION	BY
U. S. ARMY ENGINEER DISTRICT, HUNTINGTON CORPS OF ENGINEERS HUNTINGTON, W. VA.			
DRAWN BY: <i>EER</i>	LICKING RIVER DILLON RESERVOIR PROJECT RELOCATION OF OHIO STATE ROUTE NO.156 (Section 3 & 4)		
TRACED BY:			
CHECKED BY:			
SUBMITTED BY: <i>Edmund S. Barrett</i>			
ELMER S. BARRETT ASSOCIATES			
RECOMMENDED: <i>James J. [Signature]</i>			
CHIEF ENG. DIV.	APPROVED: <i>[Signature]</i> COL. C. E., DISTRICT ENGINEER	DATE: JULY 1959	
ELMER S. BARRETT ASSOCIATES CONSULTING ENGINEERS CHILLICOTHE, OHIO		SCALE: <i>HORIZ. 1"=50'</i> <i>VERT. 1"=5'</i> DRAWING NUMBER 027f-UD6-68/26 SHEET <i>26</i> OF <i>62</i>	