


Seeding  
End Area  
Cut Width  
Fill Width

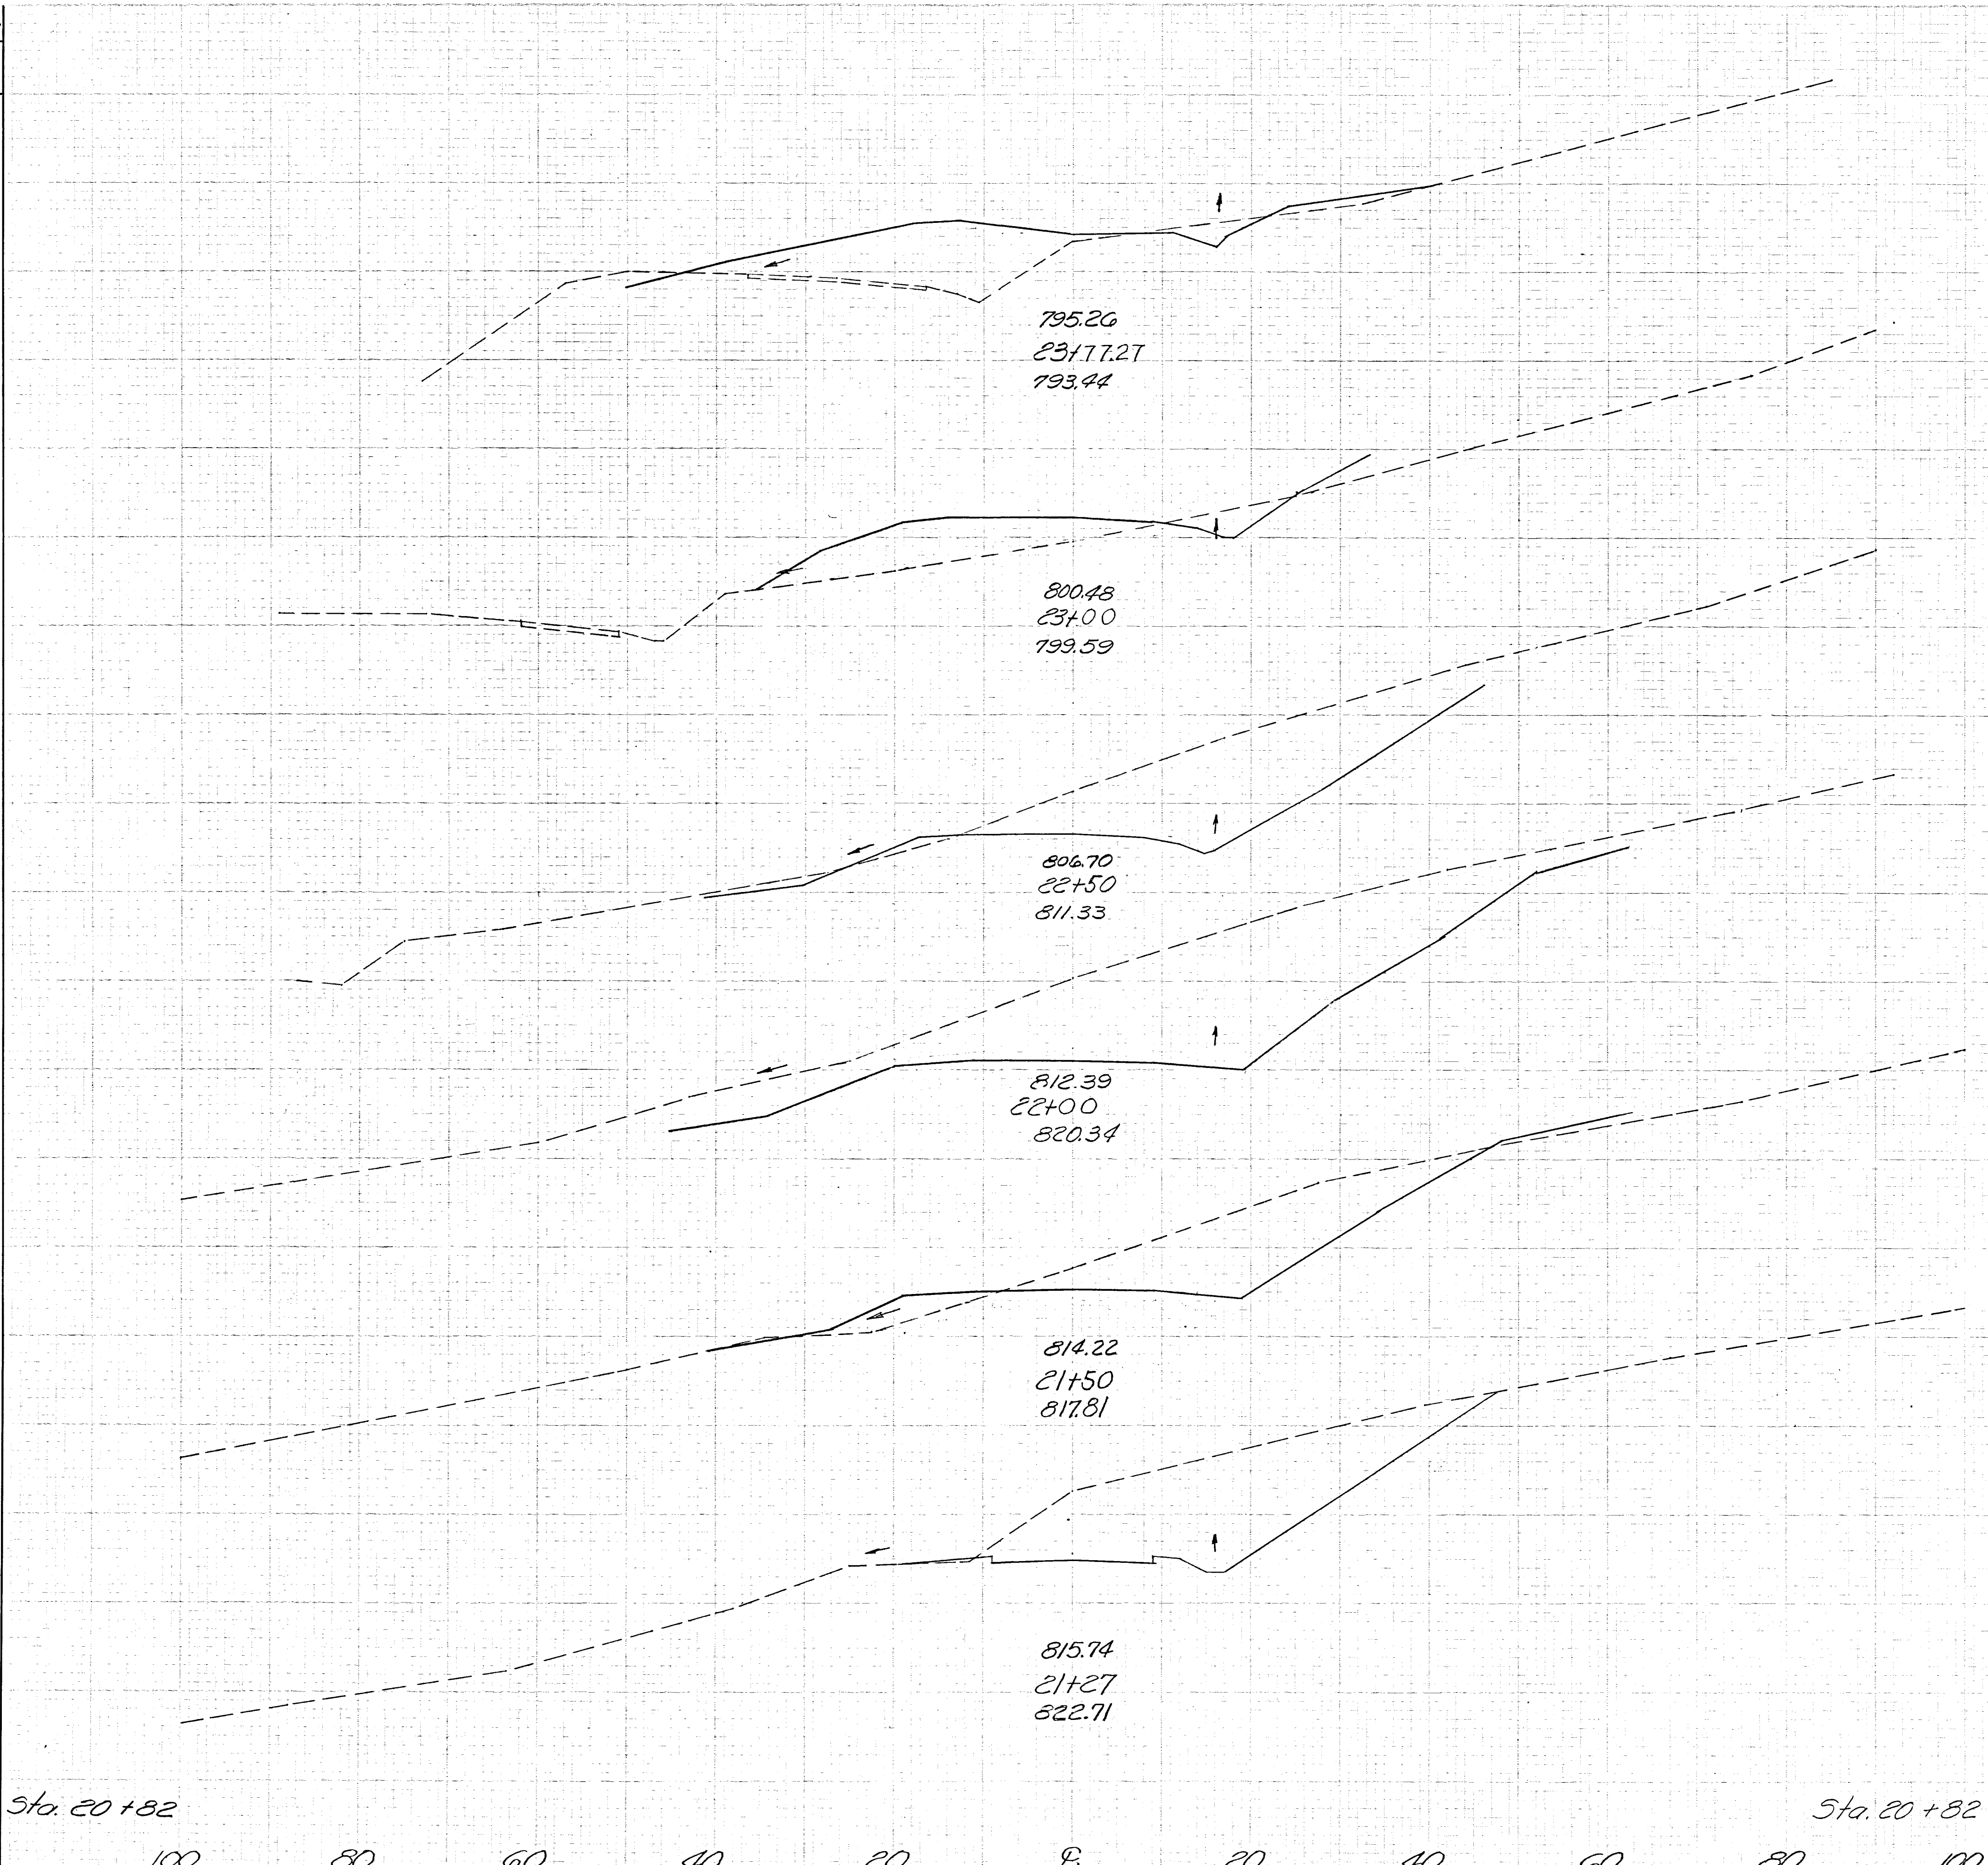

| End Area |      | Volume |      |
|----------|------|--------|------|
| Cut      | Fill | Cut    | Fill |
| 12       | 130  |        |      |
|          | 77   | 201    |      |
| 52       | 37   |        |      |
|          | 694  | 53     |      |
| 430      | 0    |        |      |
|          | 1345 | 0      |      |
| 607      | 0    |        |      |
|          | 399  | 0      |      |
|          | 332  | 0      |      |
|          | 269  | 1      |      |
| 433      | 3    |        |      |
|          | 842  | 3      |      |
| 577      | 0    |        |      |

MUSKINGUM COUNTY  
MUS-156-2.85

41  
62

|                                                                                      |      |                                                                                                          |    |
|--------------------------------------------------------------------------------------|------|----------------------------------------------------------------------------------------------------------|----|
| REVISION                                                                             | DATE | DESCRIPTION                                                                                              | BY |
| U. S. ARMY ENGINEER DISTRICT, HUNTINGTON<br>CORPS OF ENGINEERS<br>HUNTINGTON, W. VA. |      |                                                                                                          |    |
| DRAWN BY: EER                                                                        |      | LICKING RIVER<br>DILLON RESERVOIR PROJECT<br>RELOCATION OF<br>OHIO STATE ROUTE NO.156<br>(Section 3 & 4) |    |
| CHECKED BY: EER                                                                      |      | DATE: JULY 1959                                                                                          |    |
| SUBMITTED BY: E. S. Barrett                                                          |      | APPROVED: A. J. Schuler                                                                                  |    |
| ELMER S. BARRETT ASSOCIATES                                                          |      | COL. C. E. DISTRICT ENGINEER                                                                             |    |
| RECOMMENDED: A. J. Schuler                                                           |      | SCALE: 1" = 10'-0"                                                                                       |    |
| CHIEF ENG. DIV.                                                                      |      | SHEET 41 OF 62                                                                                           |    |
| ELMER S. BARRETT ASSOCIATES<br>CONSULTING ENGINEERS<br>CHILLICOTHE, OHIO             |      | DRAWING NUMBER<br>0 271-UD 6-68/41                                                                       |    |

WORK AS CONSTRUCTED CONNECTION - STA. 21+27 TO STA. 23+83