
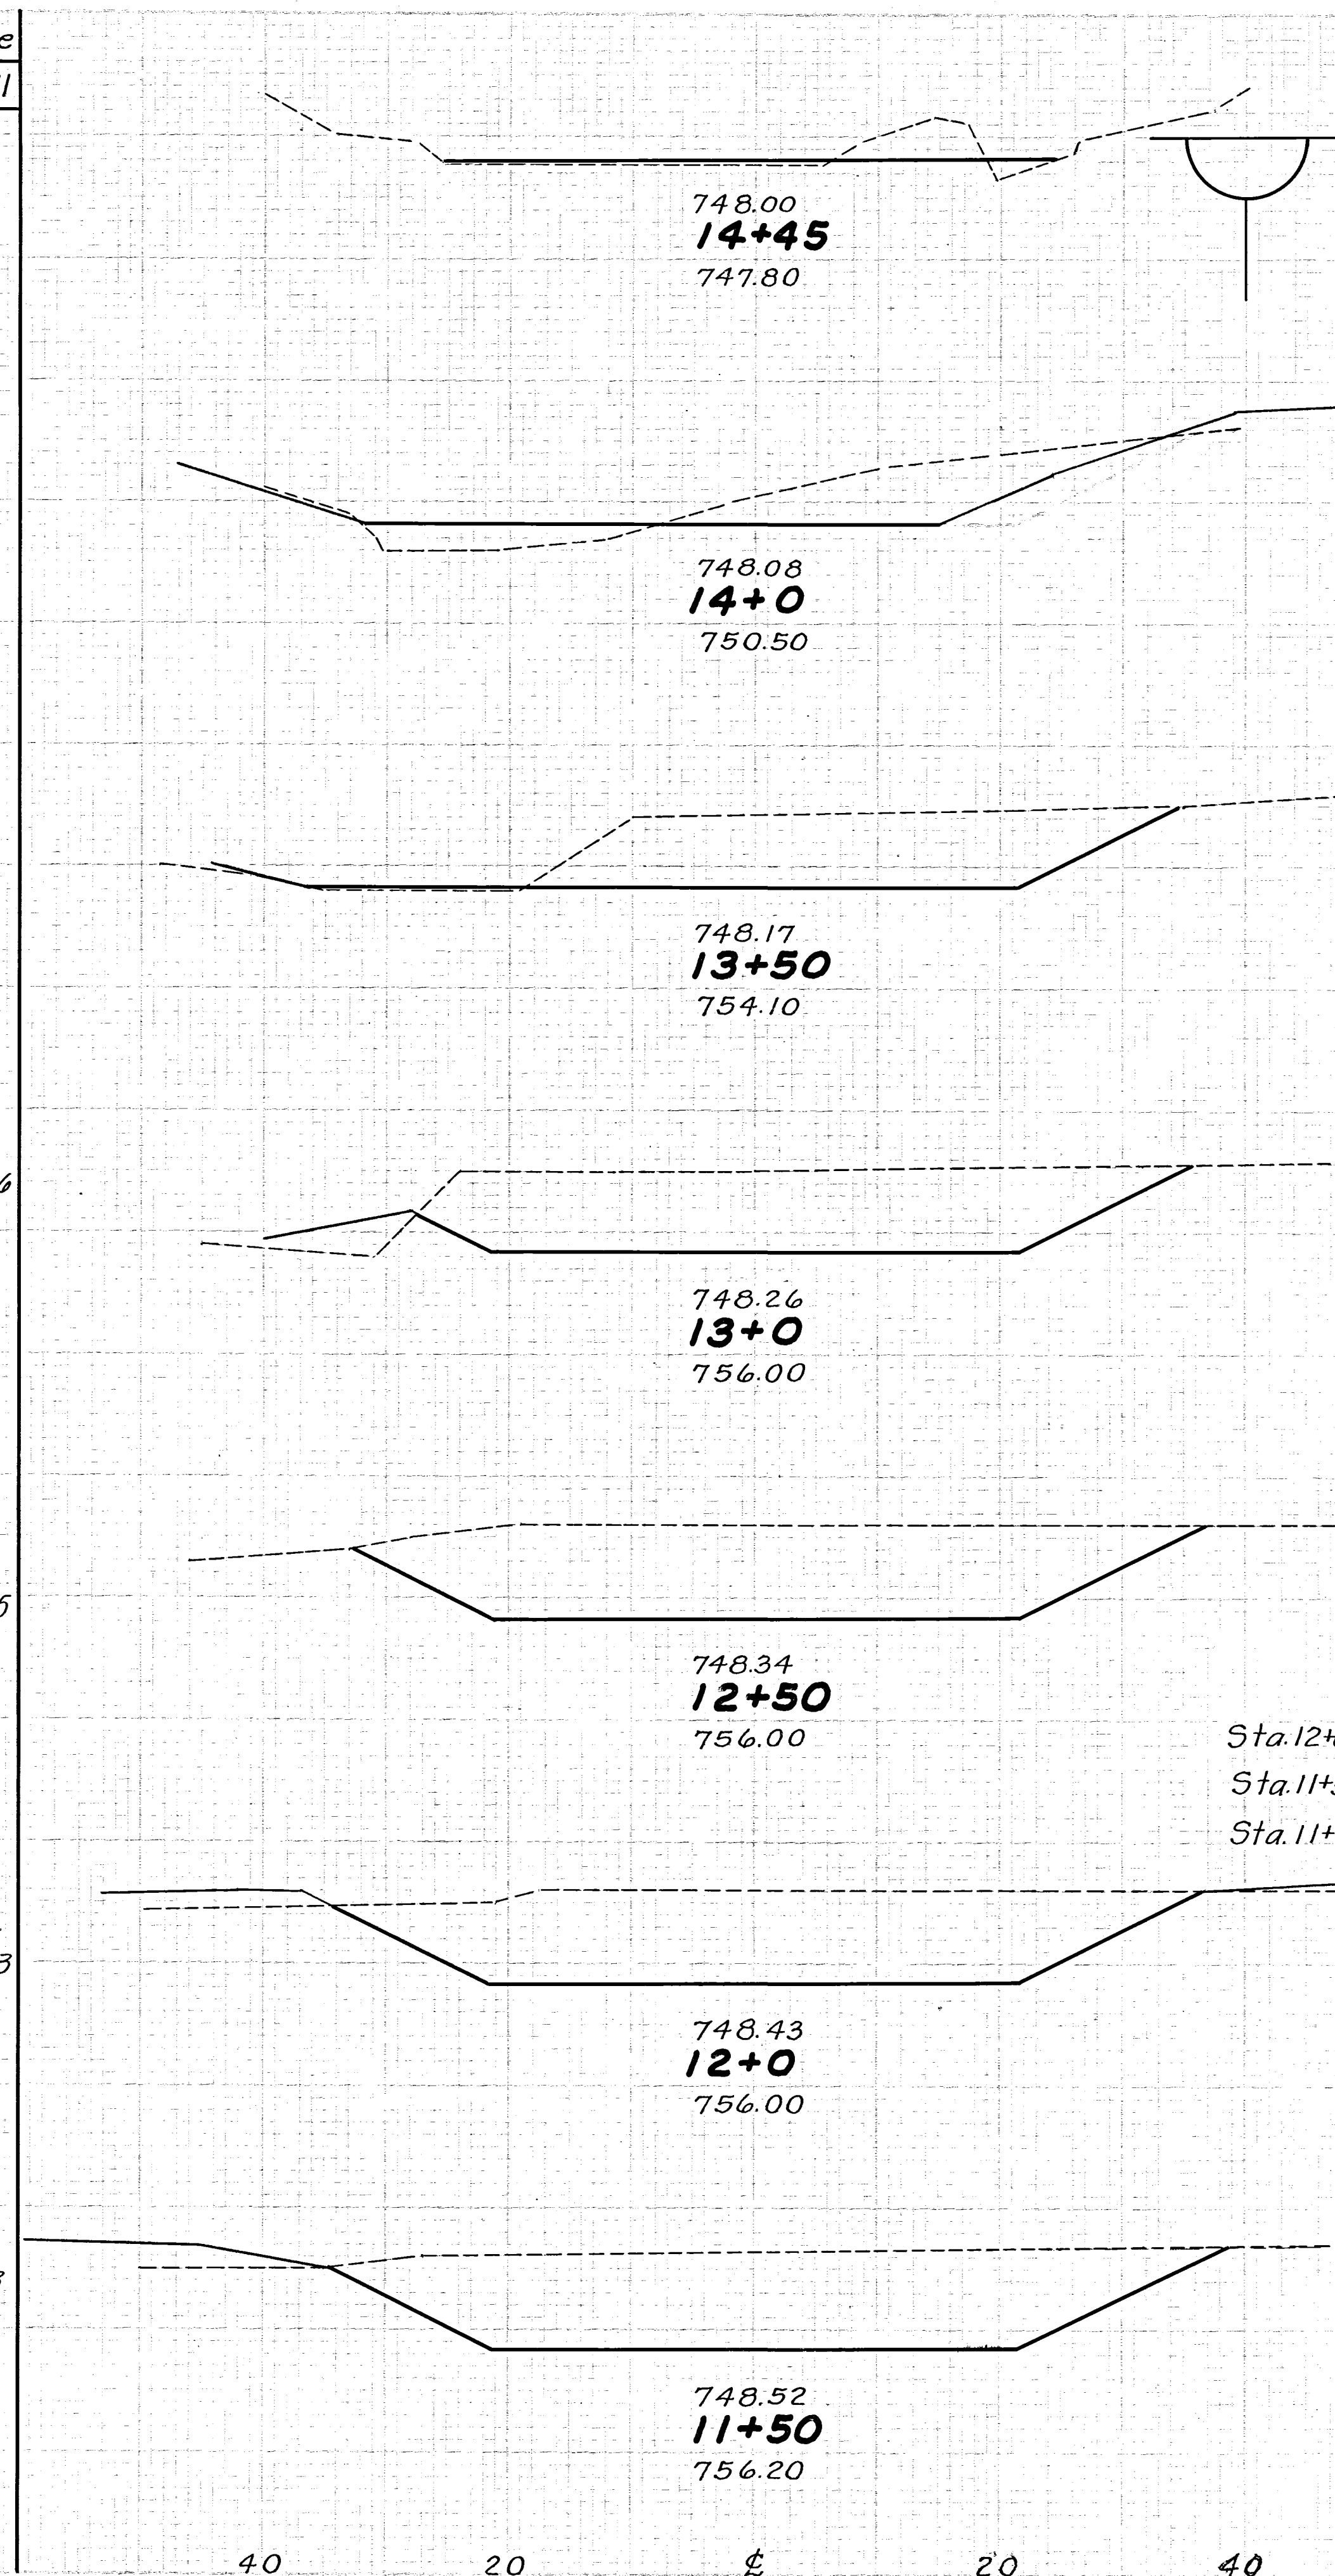


MUSKINGUM COUNTY
MUS-156-2.85

EndArea		Volume	
Cut	Fill	Cut	Fill
458	0		
		880	0
492	0		
		946	0
530	0		
		887	306
428	330		
		519	445
132	151		
		155	153
35	14		
		32	13
0	0		

EndArea		Volume	
Cut	Fill	Cut	Fill
0	0		
		123	33
147	39		
		381	36
265	0		
		380	0
361	0		
		738	0
436	0		
		804	0
432	0	825	0
437	0	829	0
458	0		

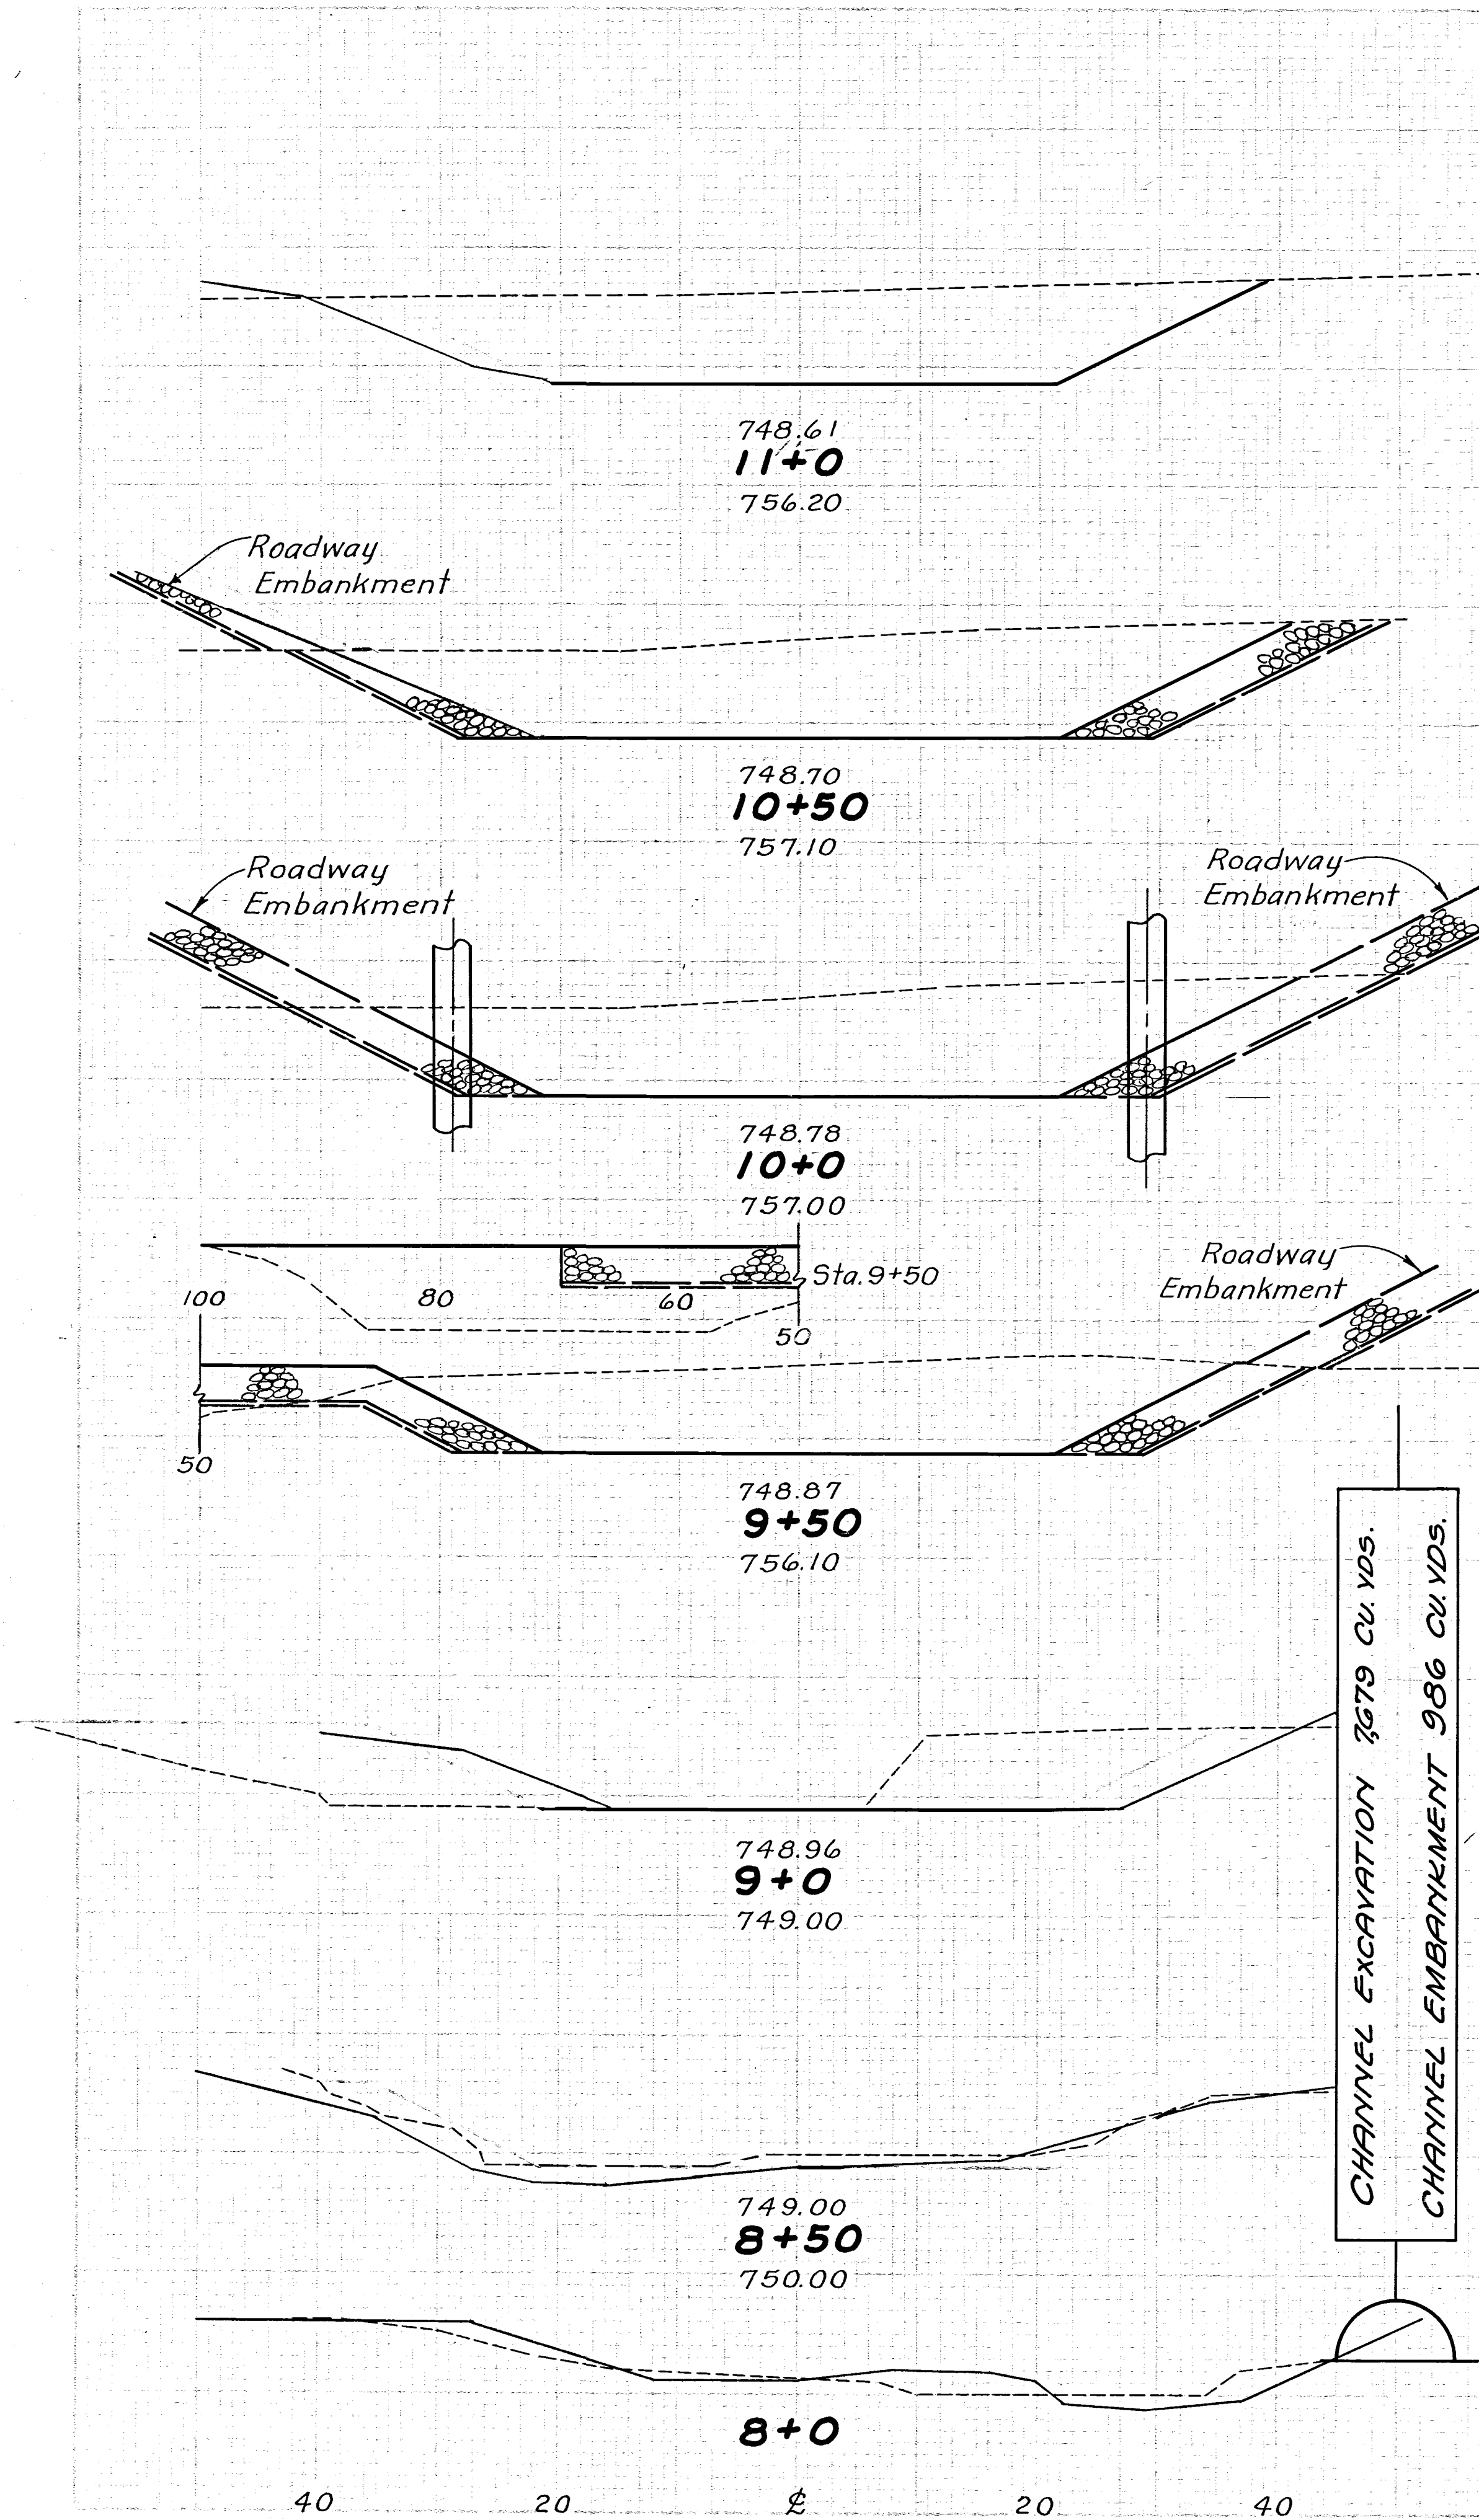

REVISION	DATE	DESCRIPTION	BY
U. S. ARMY ENGINEER DISTRICT, HUNTINGTON CORPS OF ENGINEERS HUNTINGTON, W. VA.			
DRAWN BY: E.E.R.		LICKING RIVER DILLON RESERVOIR PROJECT	
TRACED BY: W.D.J.		RELOCATION OF OHIO STATE ROUTE NO. 156 (Section 3 & 4)	
CHECKED BY: W.I.C.		APPROVED: <i>[Signature]</i> DATE: JULY 1959	
SUBMITTED BY: <i>[Signature]</i> ELMER S. BARRETT ASSOCIATES		COL. C.E. DISTRICT ENGINEER	
RECOMMENDED: <i>[Signature]</i> CHIEF ENG. DIV.		ELMER S. BARRETT ASSOCIATES CONSULTING ENGINEERS CHILLICOTHE, OHIO	
SCALE: 1" = 10'-0"		SPEC. NO. 027f-UD6-68/55 DRAWING NUMBER SHEET 55 OF 62	

WORK AS CONSTRUCTED

CHANNEL SECTIONS ON BIG RUN