


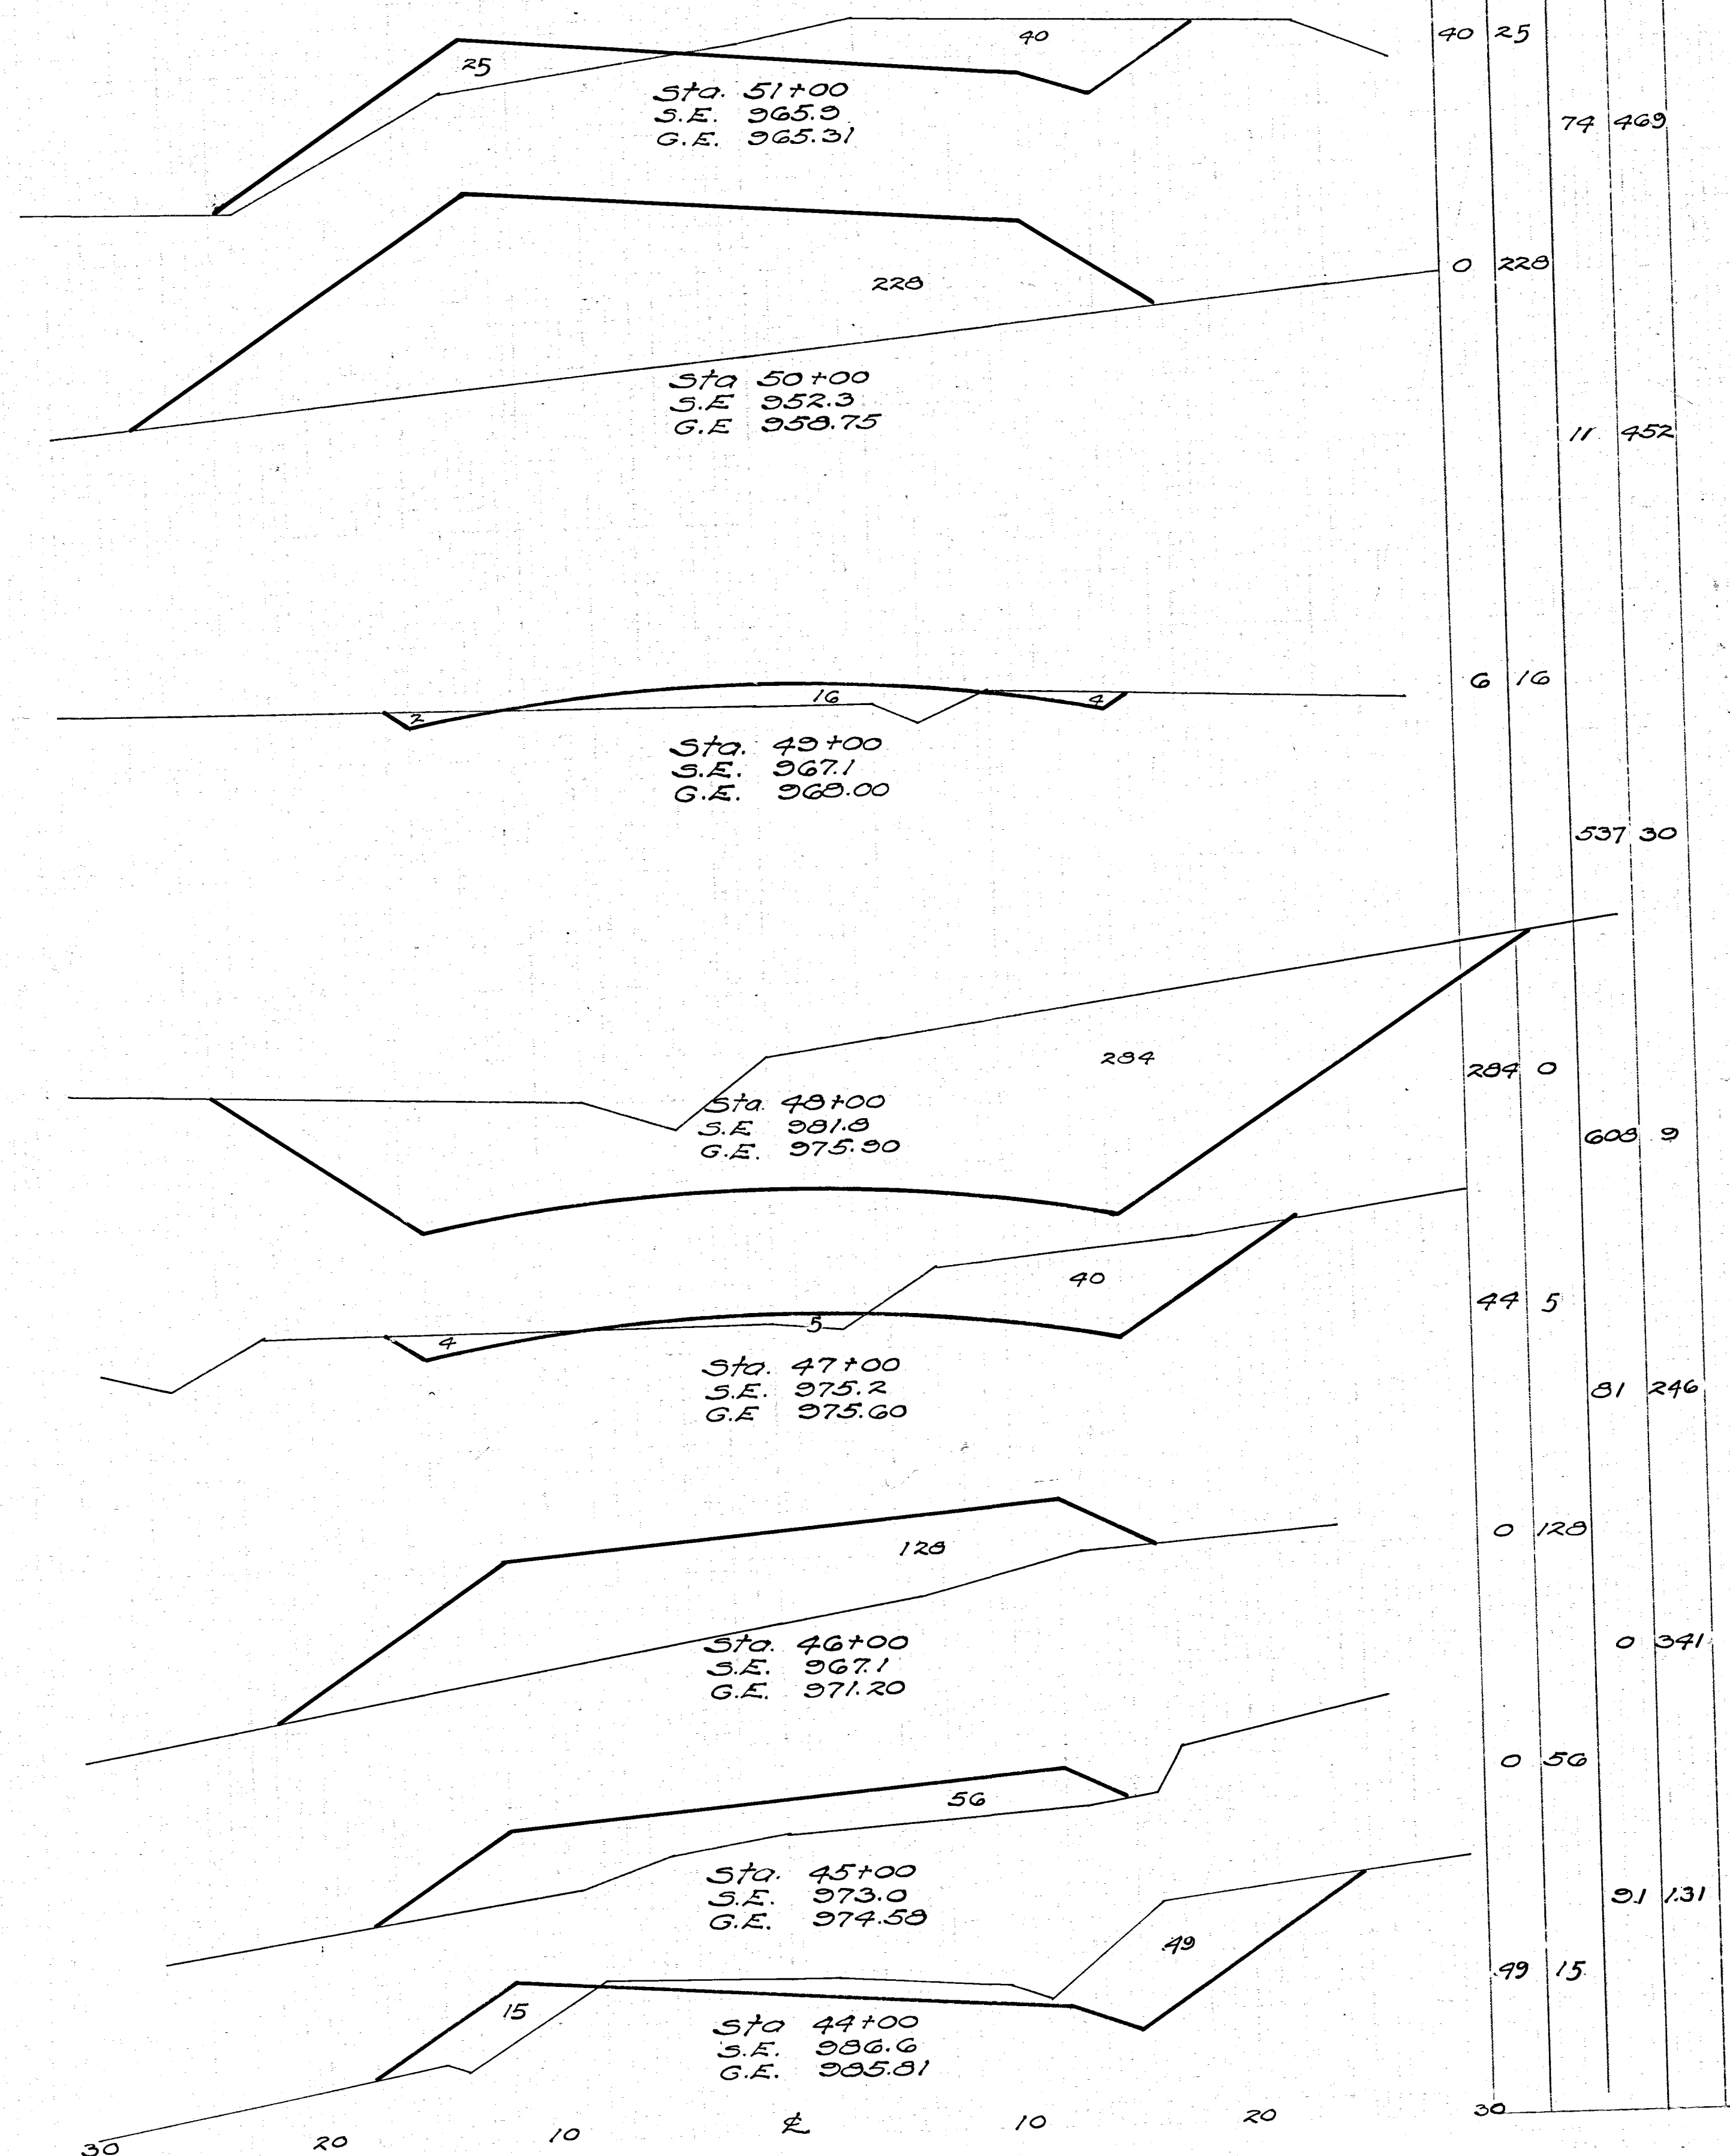

As planned
As constructed
Addition

Exc.
1393
2021
628

Cu. yds.
Cu. yds.
Cu. yds.

LINE CHANGE COVERED BY CHANGE ORDER No. 1

