

TOWNSHIP ROAD NO. 607 MUSKINGUM COUNTY

MUSKINGUM TOWNSHIP & LICKING TOWNSHIP

CONVENTIONAL SIGNS


State Line	-----
County Line	-----
Township Line	-----
Section Line	-----
Center Line	-----
Corporation Line	-----
Fence Line	x x x x x
Guard Rail (existing)	o o o o o
Guard Rail (proposed)	o o o o o
Steam Railroad	-----
Power Poles	o o o o o
Telephone Poles	o o o o o
Trees & Stumps (existing)	o o o o o
Trees & Stumps (to be removed)	x x x x x

INDEX OF SHEETS

Title Sheet	1
Typical Sections	2
Typical Details	2-5
Notes	6
Summary of Quantities	7
General Summary	7
Plan & Profile & R/W Plan	8-10
Cross Sections	11-14
Structures 20' Span & Under (Pipe Culverts)	15
Location Plan	16

LINE DATA

Begin Project	Sta. 14 + 75.00
End Project	Sta. 37 + 75.00
Net Length of Project	2,300.00 Lin. Ft. or 0.435 Miles

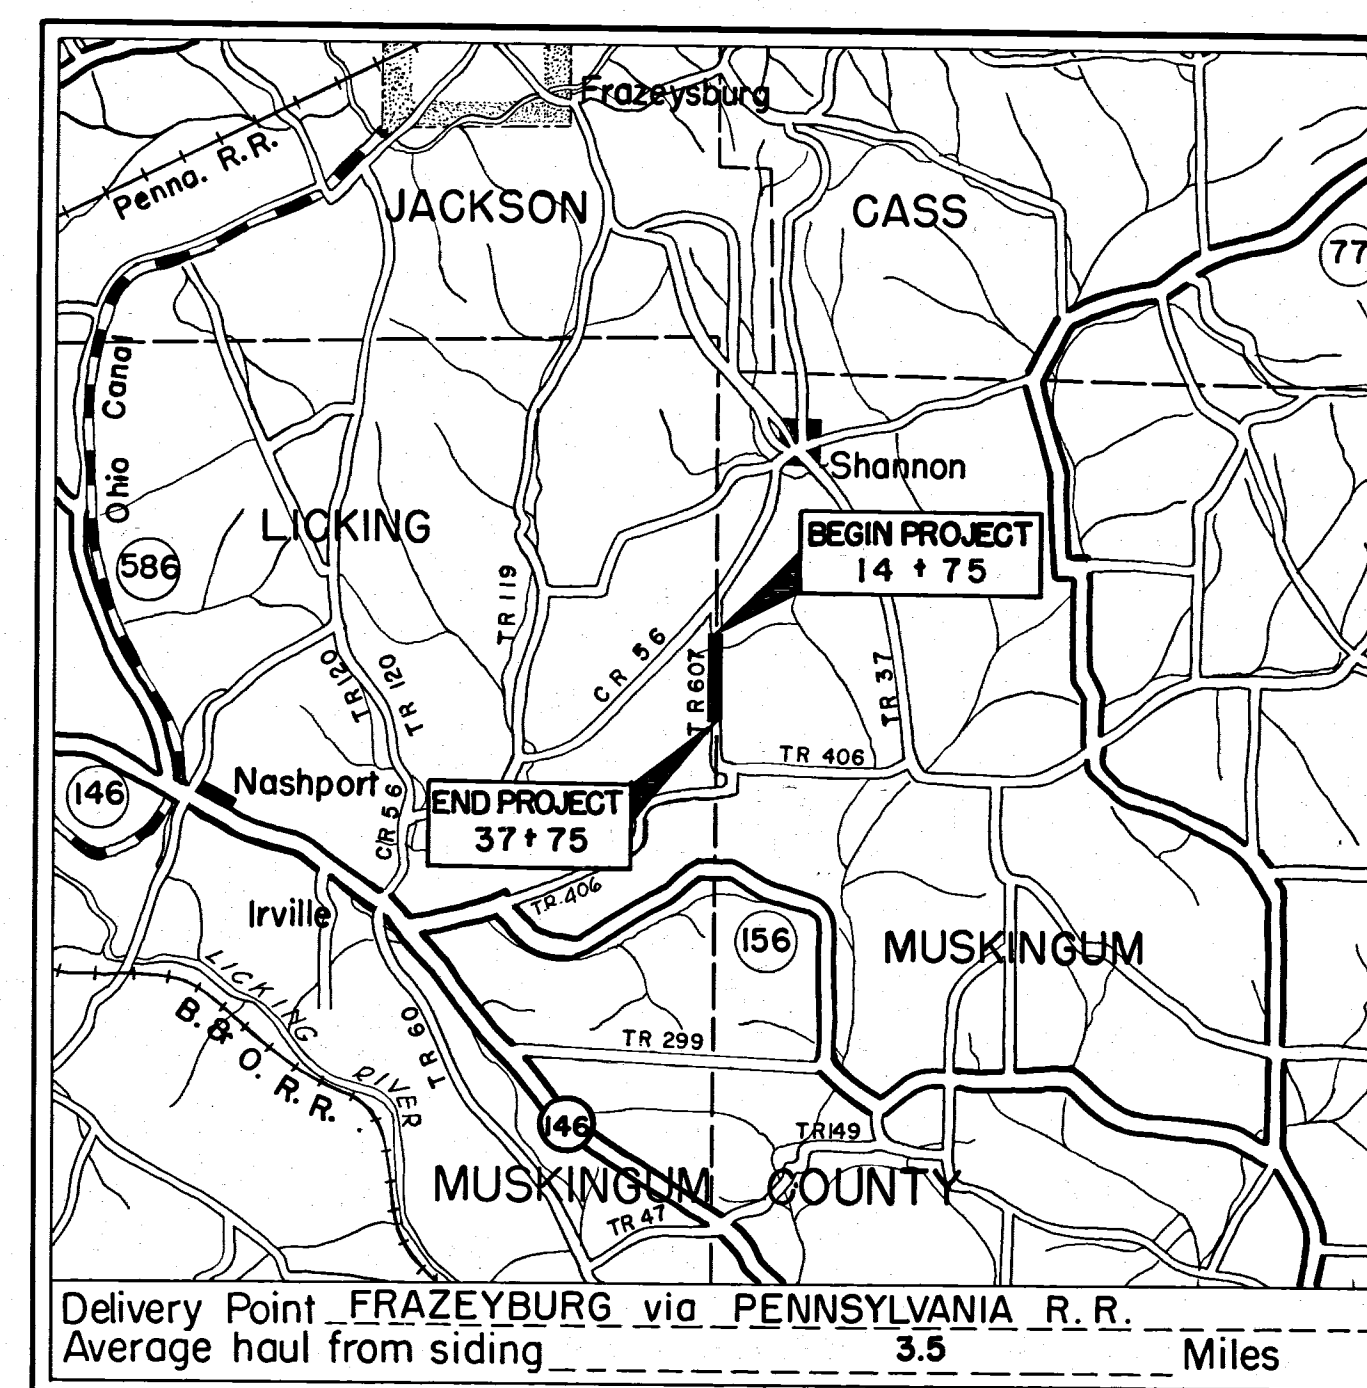


LOCATION MAP

SCALE OF MILES



Portion to be improved
Federal Roads
State Roads
Other Roads

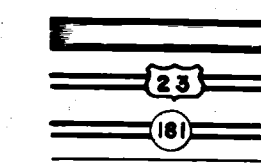

SCALE

Plan	1" = 50'
Profile: Horizontal	1" = 50'
Profile: Vertical	1" = 5'
Cross Sections	1" = 10'

Supplemental Prints of Standard Construction Drawings

Supplemental Specifications

File No.	Date of Letting	195
	Contract No.	

We, the Commissioners of Muskingum County in formal session hereby approve these plans.

BOARD OF COMMISSIONERS

Hutton Barnes
Roy S. Davis
Roy Thompson

Date August 26, 1959

The standard specifications of the State of Ohio, Department of Highways, including changes and supplemental specifications listed in the proposal shall govern this improvement.

Muskingum County, Ohio shall furnish such rights of way as are currently available on the existing highways. The United States of America shall provide all necessary new or additional rights of way.

I hereby approve these plans and declare that the making of this improvement will require the closing of the road to traffic and that detours will be provided as indicated on the plans.

Approved Lipton Walters
Date Aug. 26, 1959 County Engineer

REVISION	DATE	DESCRIPTION	BY
	3/23/62	AS CONSTRUCTED	H.F.K.
U. S. ARMY ENGINEER DISTRICT, HUNTINGTON CORPS OF ENGINEERS HUNTINGTON, W. VA.			
DRAWN BY: <u>H.I.Z.</u>			
TRACED BY: <u>EDH.</u>			
CHECKED BY: <u>RCW</u>			
SUBMITTED BY: <u>Elmer S. Barrett</u>			
RECOMMENDED: <u>James S. Barrett</u>			
APPROVED: <u>James S. Barrett</u>			
DATE: AUGUST 1959			
ELMER S. BARRETT ASSOCIATES CONSULTING ENGINEERS CHILLICOTHE, OHIO			
SCALE: 1" = 50'			
SHEET 1 OF 16			
DRAWING NUMBER 027f-UD9-68/1			

T-607

WORK AS CONSTRUCTED

60-359