

LOCATION PLAN



TOWNSHIP ROAD NO. 607

MUSKINGUM COUNTY

MUSKINGUM TOWNSHIP & LICKING TOWNSHIP

FED. RD. DIVISION	STATE	PROJECT	
2	OHIO		16/16

MUSKINGUM COUNTY
TOWNSHIP ROAD 607

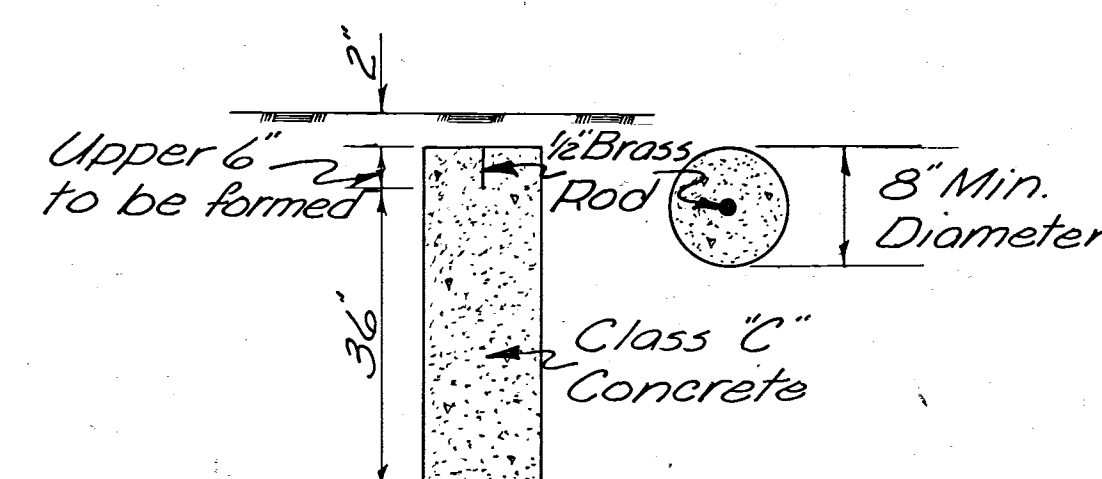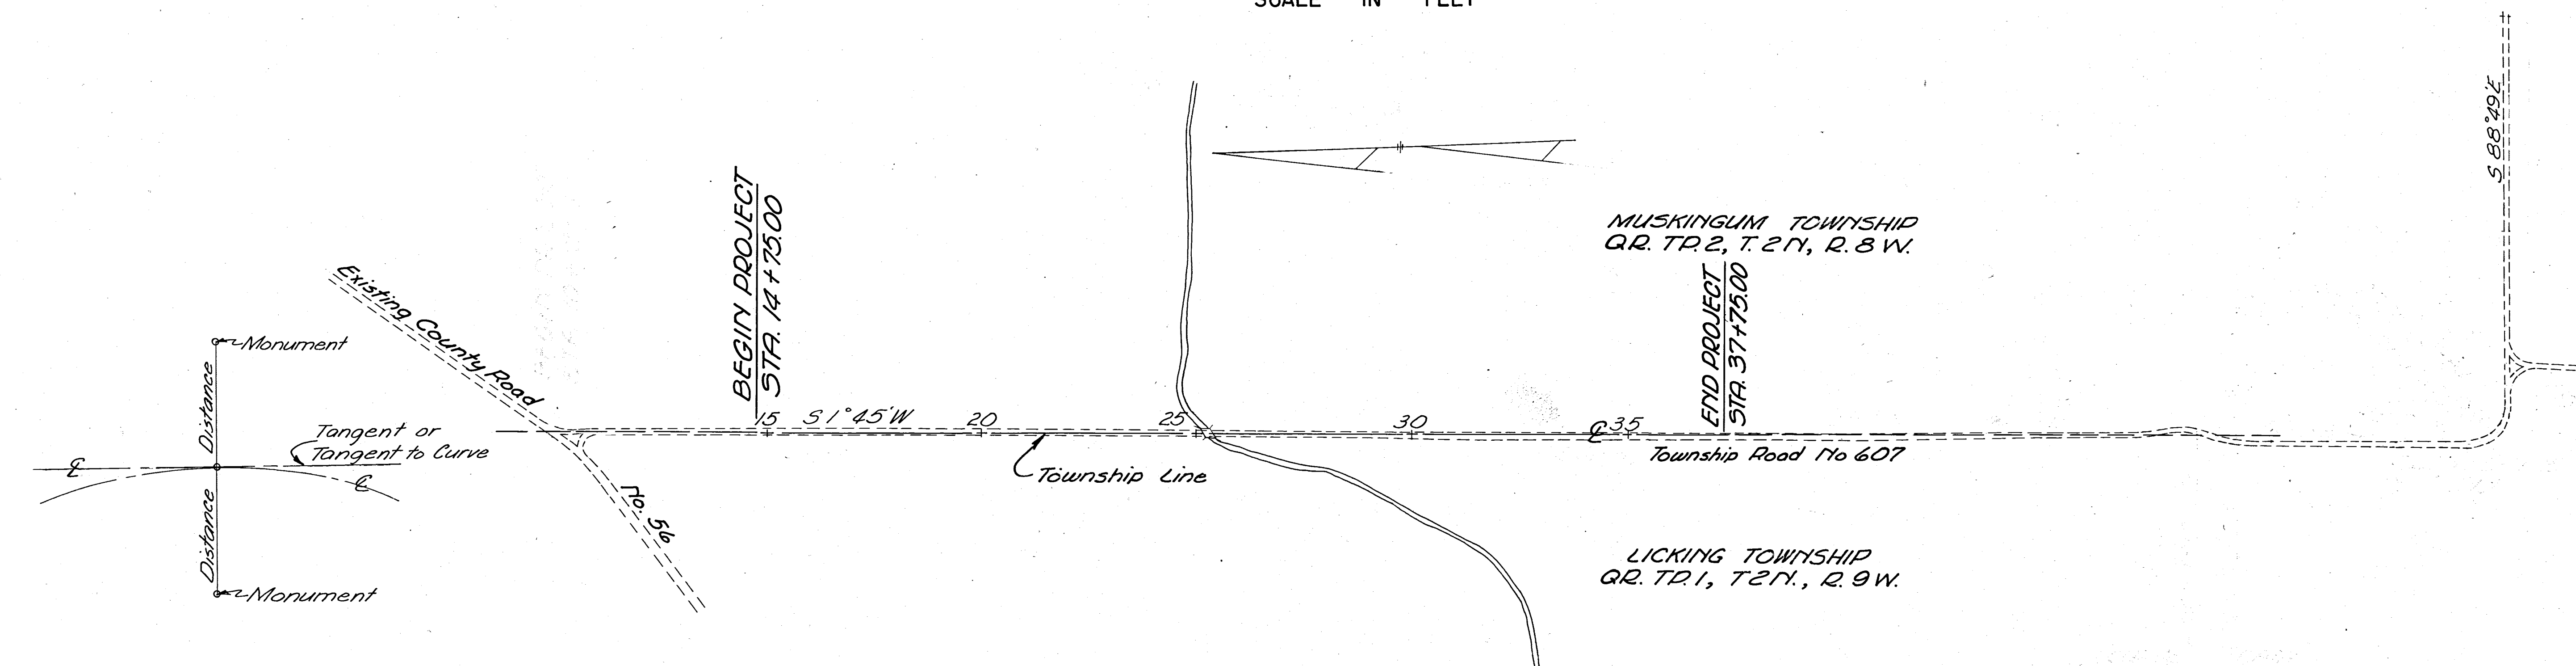

DETAIL OF MONUMENT

Monuments shall be constructed of Class "C" concrete cast-in-place in a circular hole eight (8") inches in diameter and forty-four (44") inches in depth. The top of concrete shall be finished at a depth of two (2") inches below ground level and the upper six (6") inch portion of the concrete shall be formed. One-half (1/2") inch brass rods, six (6") inches long, shall be embedded in the wet concrete as directed by the Contracting Officer to mark the centerline and station.

MONUMENTS TO BE PLACED AFTER CONSTRUCTION					
Station	Dist.	Dist.	Station	Dist.	Dist.
15+25	12'	12'	29+75	12'	12'
19+75	12'	12'	34+75	12'	12'
24+75	12'	12'	37+25	12'	12'

Item I-8 Monument Assemblies 12 Each

I hereby certify that this plan is a true delineation of a survey made in 1959 for the U.S. Army, Corps of Engineers, Huntington District and Muskingum County by Elmer S. Barrett Associates.

Elmer S. Barrett Date: 8-20-59
ELMER S. BARRETT P.E. #6937, Registered Surveyor #2890

This plan recorded in the Muskingum County Record of Plats, Book: Page: Date:

REVISION	DATE	DESCRIPTION	BY
	3/23/62	AS CONSTRUCTED	H.F.K.
U. S. ARMY ENGINEER DISTRICT, HUNTINGTON CORPS OF ENGINEERS HUNTINGTON, W. VA.			
LICKING RIVER DILLON RESERVOIR PROJECT READJUSTMENT OF TOWNSHIP ROAD NO. 607 (MT- 607-1)			
DRAWN BY: R.E.J. TRACED BY: L.L.F. CHECKED BY: S.W. SUBMITTED BY: Elmer S. Barrett ELMER S. BARRETT ASSOCIATES		APPROVED: <i>James O. James</i> CHIEF ENG. DIV. COL. C.E. DISTRICT ENGINEER	
RECOMMENDED: <i>James O. James</i> CHIEF ENG. DIV.		DATE: AUGUST 1959	
ELMER S. BARRETT ASSOCIATES CONSULTING ENGINEERS CHILLICOTHE, OHIO		SCALE: 1" = 200' DRAWING NUMBER 0 27f-UD9-68116 SHEET 16 OF 16	

WORK AS CONSTRUCTED

LOCATION PLAN