


CONDOMINIUM DRAWINGS
OF
THE VILLAGE OF
WELLINGTON PLACE CONDOMINIUMS
SECOND AMENDMENT, PHASE III
LOCATED IN
SECTION 21, TOWNSHIP 2, RANGE 8
UNITED STATES MILITARY LANDS
CITY OF ZANESVILLE, MUSKINGUM COUNTY, OHIO

2.140 ACRES - PHASE III
0.033 ACRES - LIMITED COMMON ELEMENTS
1.932 ACRES - COMMON ELEMENTS
0.175 ACRES - CONDOMINIUM UNITS

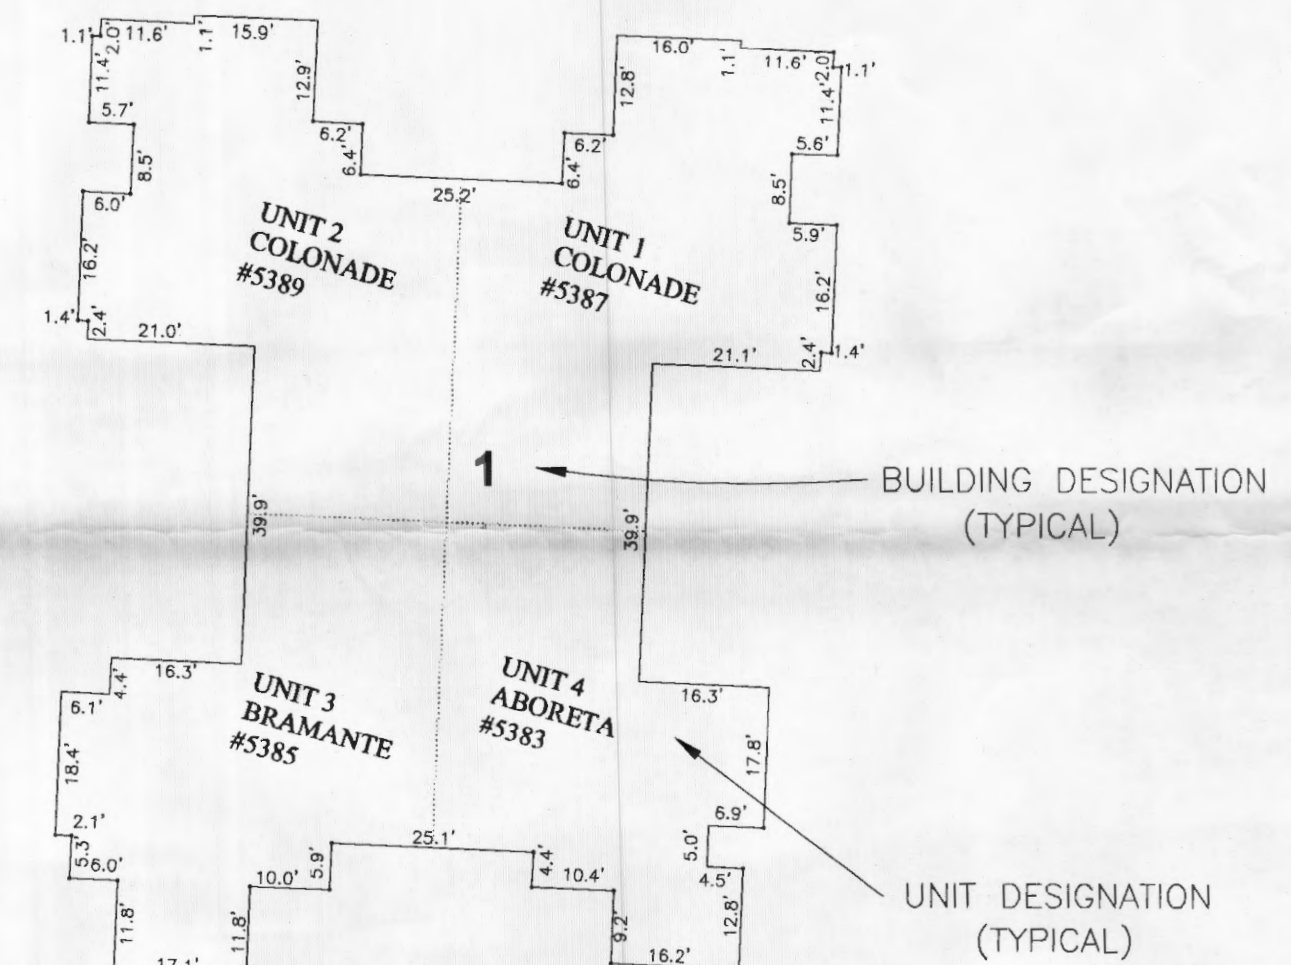

BUILDING DETAILS
NOT TO SCALE


REQUIRED ARCHITECT OR PROFESSIONAL ENGINEER
CERTIFICATION

The undersigned Registered Professional Architect
hereby certifies that this Drawing, consisting of ___
sheet(s), accurately shows each building depicted
hereon as built or constructed.

Paul T. Keeg
Registered Architect
No. 9109804 Date 10/29/2012

The undersigned Registered Professional Surveyor
hereby certifies that this Drawing, consisting of 3
sheet(s), accurately reflects the location of improvements
and recorded easements.

OFFICE COPY
NOT RECORDABLE
10/25/2012
Registered Professional Surveyor No. 7632
David B. McCoy, P.S.

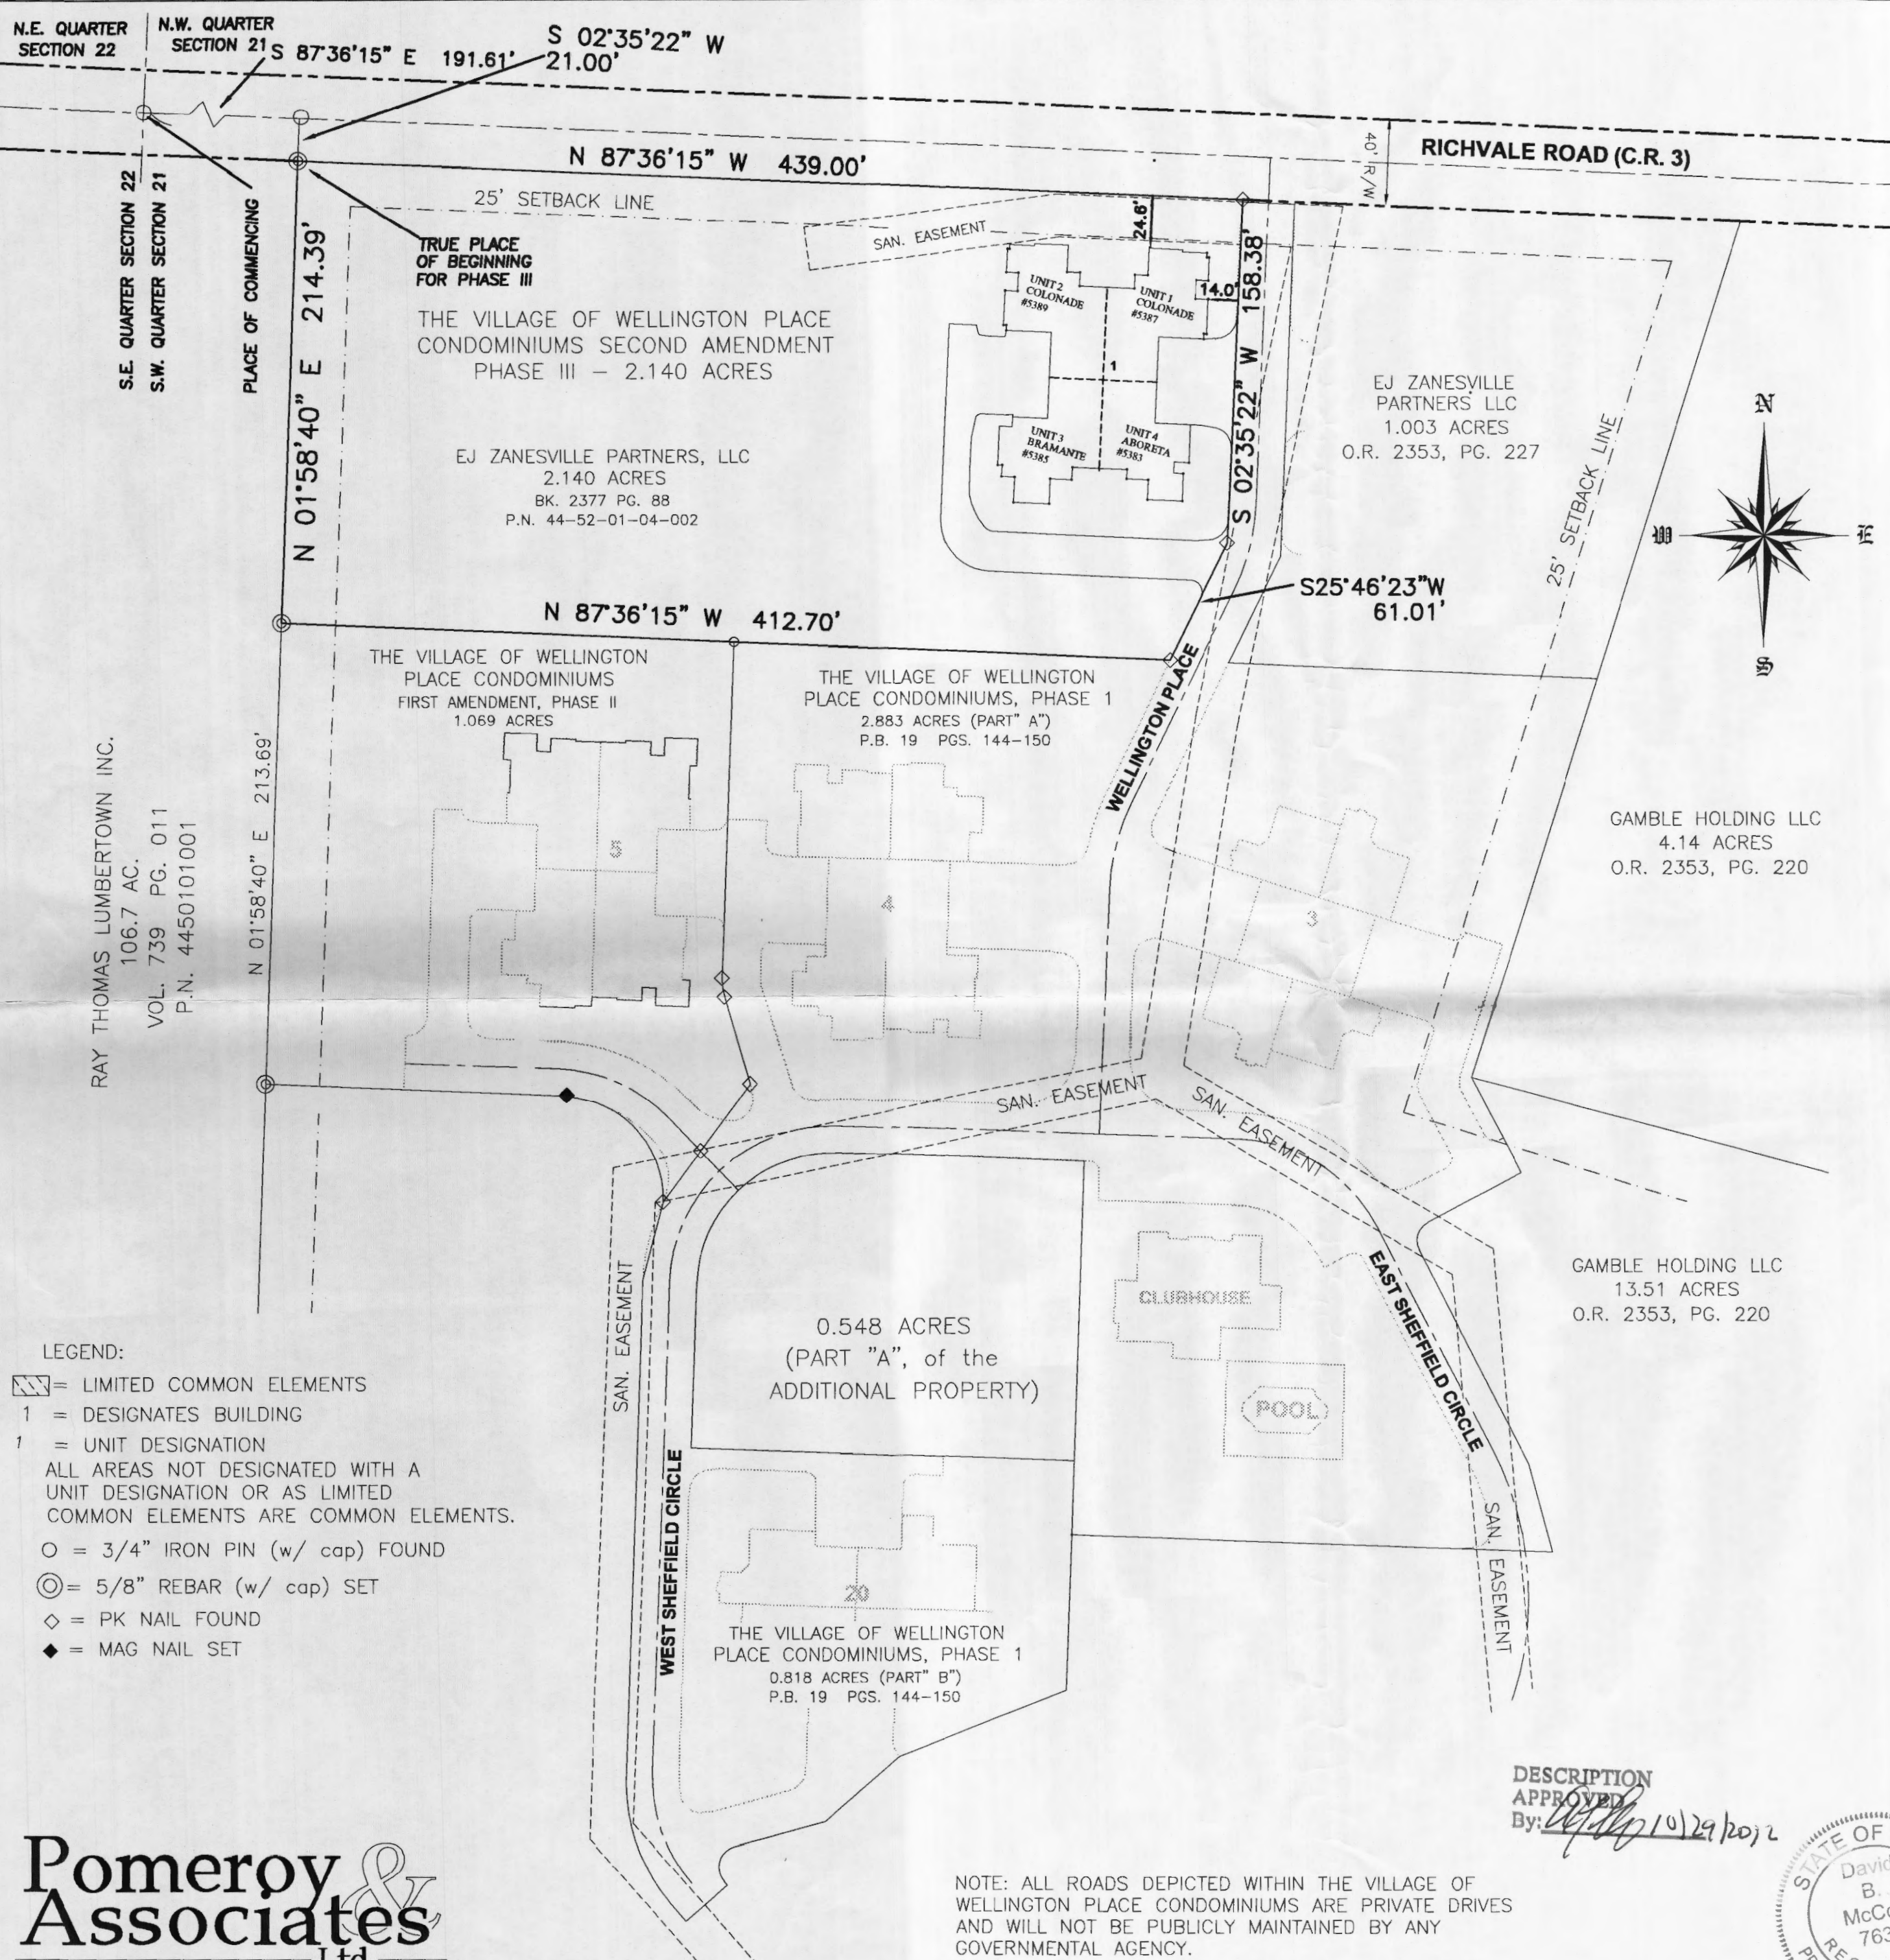

Pomeroy & Associates Ltd.
Consulting Engineers & Surveyors

599 Scherers Court • Worthington, Ohio 43085
Phone (614)885-2498 • Fax (614)885-2886

Order No. Zanes-2ND

0' 60' 120' 180'
SCALE 1" = 60'