


N

SCALE 1"=20'

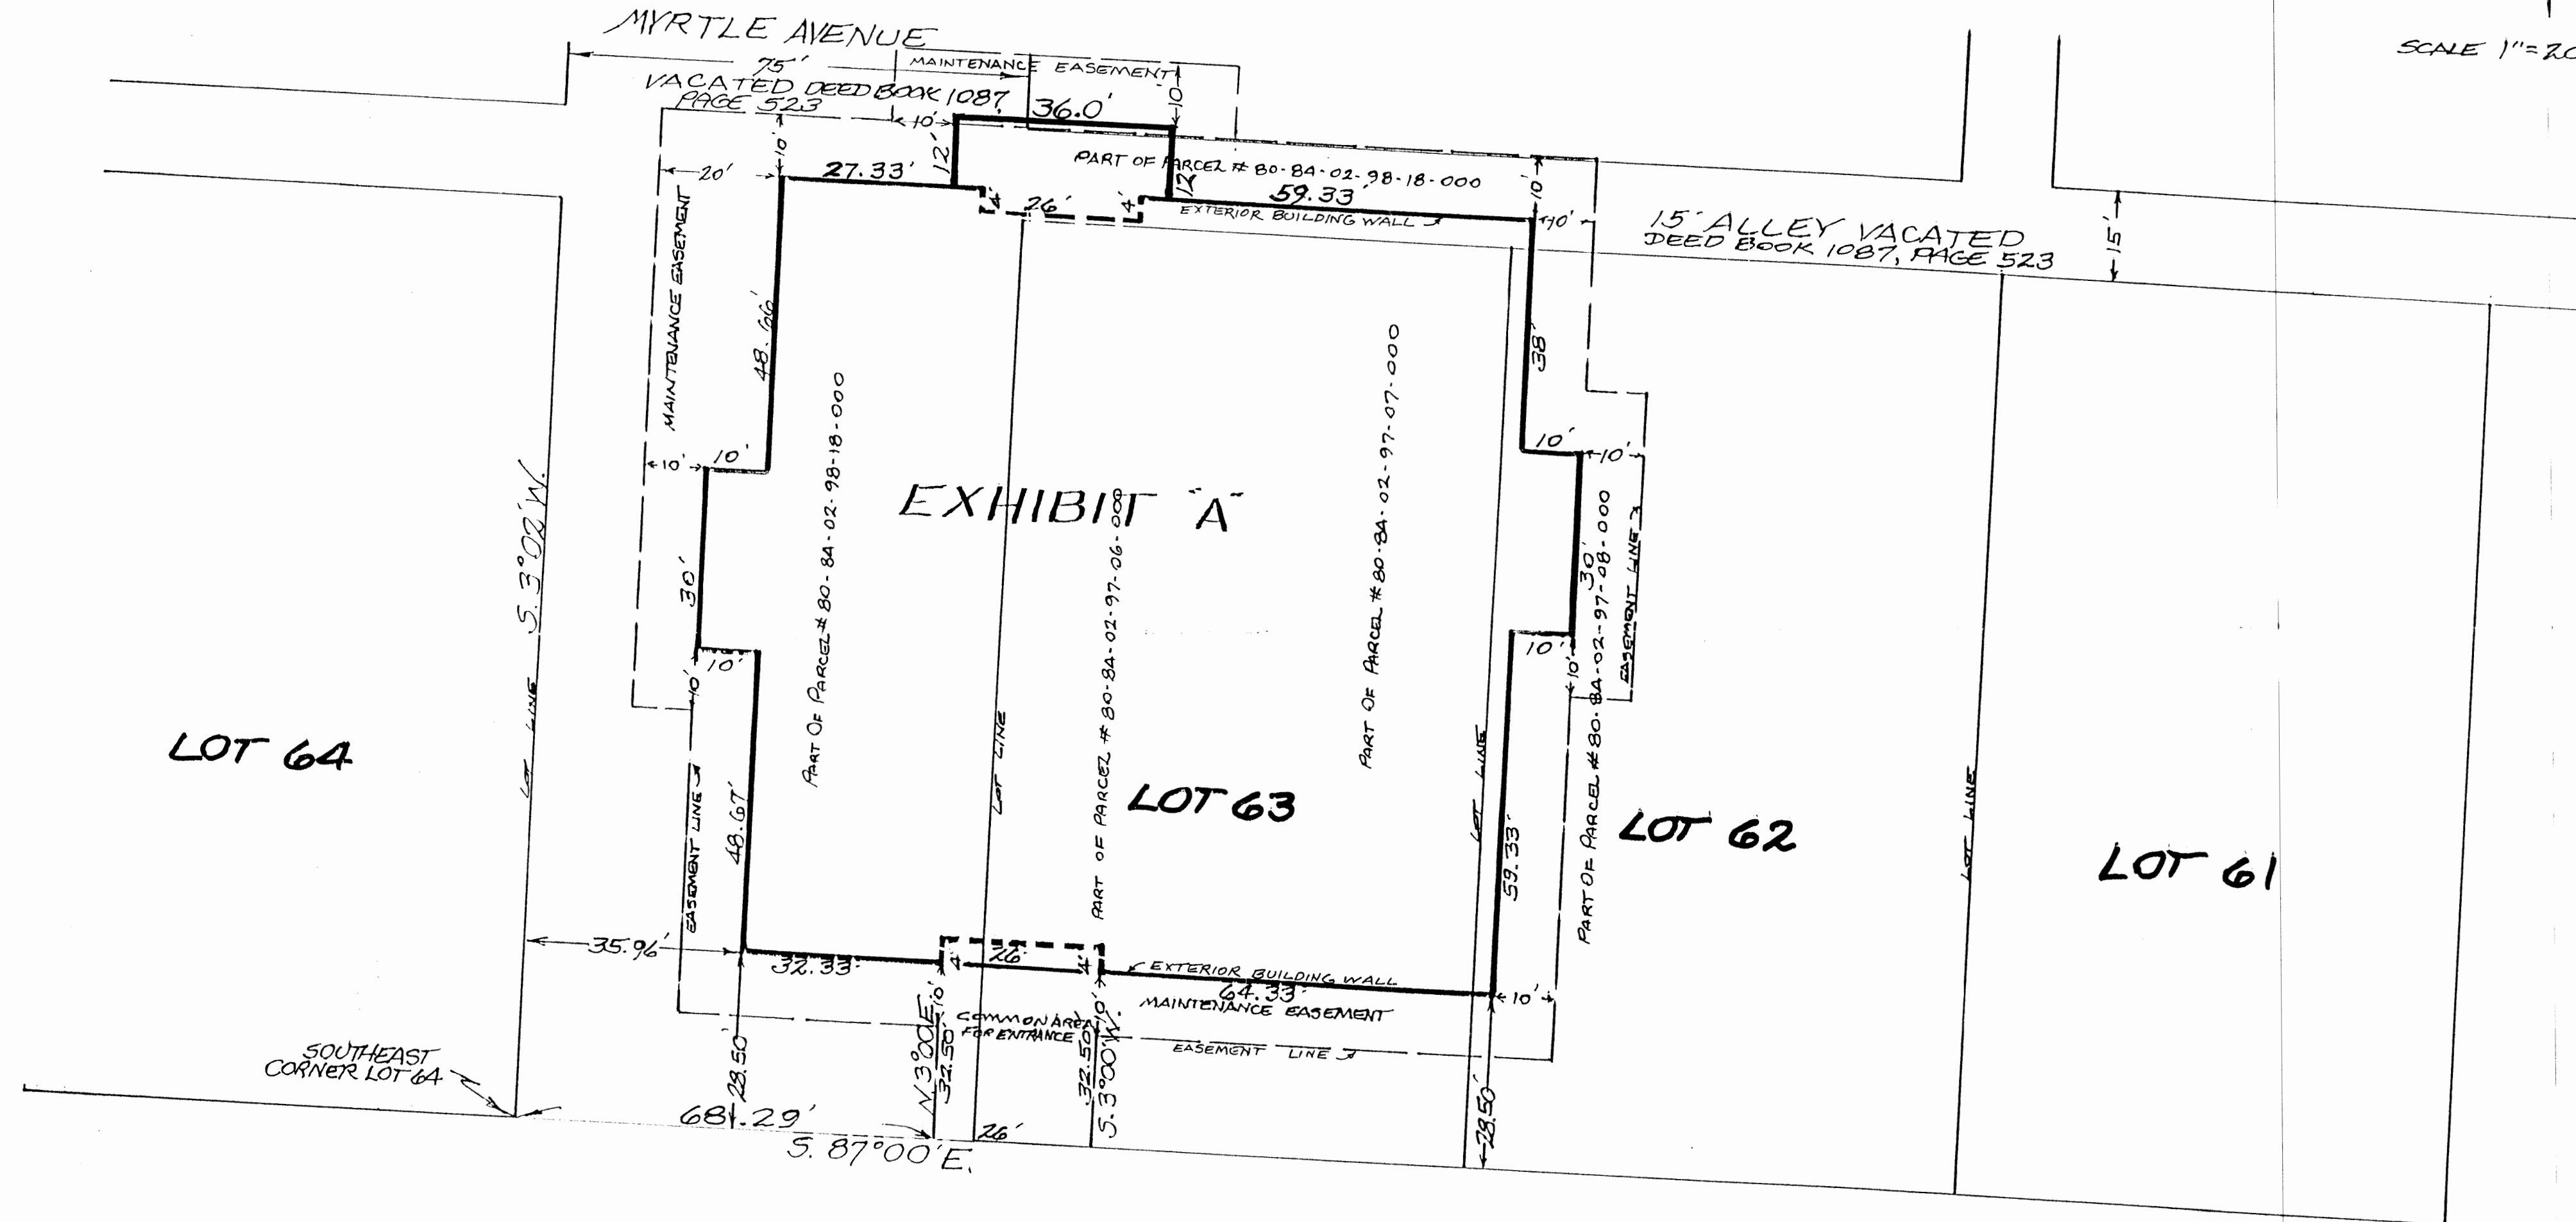

DESCRIPTION APPROVED
FOR AUDITORS TRANSFER
BY 12-4-76

I HEREBY CERTIFY THAT THIS PLAT IS A CORRECT REPRESENTATION OF
A SURVEY MADE BY ME AND THAT IT CORRECTLY SHOWS ALL THE IMPROVEMENTS
AS CONSTRUCTED _____ 1976

JEFFERY W. STUBBS, ARCHITECT 7359
L. PETER DINAN REG. SURVEYOR #5451

FOREST AVE.
75' RIGHT OF WAY

GOOD SAMARITAN MEDICAL CENTER
MEDICAL OFFICE BUILDING 2 CONDOMINIUM
751 FOREST AVENUE
ZANESVILLE, OHIO