

Description of Parcel 11

OFFICE COPY
NOT RECORDABLE

Situated in the State of Ohio, County of Muskingum, Township of Brush Creek, being in the northeast quarter of Section 8, Route 13 West, Township 10 North, of "The Congress Lands East of the Scioto River", and being bounded and described as follows:

Commencing for reference at an iron pin set at the northeast corner of Section 8 (Note: Reference bearing on the north line of Section 8 used as South 88°33'21" East.);

thence, with the east line of Section 8, South 01°41'10" West a distance of 2,022.61 feet to an iron pin set at the northeast corner of a 39.59 acres tract as conveyed to Ronald B. Miracle by Deed Volume 986, Page 97 of the Muskingum County Recorder's Office;

thence, with the north line of said Miracle property, North 89°02'04" West a distance of 1,559.~~23~~ ^{37?} feet to an iron pin set;

thence North 01°09'46" East a distance of 892.86 feet to an iron pin set, being THE TRUE POINT OF BEGINNING for this description;

thence, from said Point of Beginning continuing, North 01°09'46" East a distance of 172.65 feet to an iron pin set;

thence North 87°09'03" East a distance of 1,150.02 feet to a point in the centerline of State Route 555, passing through two iron pins set at distances of plus 1,020.02 feet and plus 1,120.02 feet, respectively;

thence, with the centerline of State Route 555, South 15°12'40" East a distance of 172.14 feet to a point;

thence, leaving the road and running with the centerline of an existing driveway, the following two courses:

- (1) South 66°24'44" West a distance of 46.43 feet a point;
- (2) thence South 76°53'24" West a distance of 174.46 feet a point;

thence, leaving the existing driveway, South 89°40'44" West a distance of 984.82 feet to the Point of Beginning, passing through two iron pins set at distances of plus 75.00 feet and plus 175.00 feet, respectively;

containing 5.250 acres, more or less, out of Parcel No. 08-08-70-08-12-000.

Page 2 of 3
Description of Parcel 11

Subject to all legal right-of-ways, easements, restrictions, reservations, and zoning regulations of record.

Subject to the right-of-way of State Route 555.

Subject to the 100 year Flood Plain restrictions.

Subject to any facts that may be disclosed by a full and accurate title search.

Subject to a 40.00 feet wide easement being reserved unto the grantor, his heirs, and/or assigns, forever. Said easement is for the purposes of running utilities to other parcels of land on or near State Route 555. Said easement runs in a north-south direction across the east end of the above described property with the east line of said easement being the centerline of State Route 555. Containing 0.158 acres, more or less, of easement.

TOGETHER WITH a 40.00 feet wide right-of-way, for the purposes of ingress from State Route 555. The centerline of said right-of way being described as follows:

Beginning at a point in the centerline of State Route 555 at the southeast corner of the above described 5.008 acres tract;

thence, from said Point of Beginning with the south line of said 5.008 acres tract, the following three courses:

- (1) South 66°24'44" West a distance of 46.43 feet a point;
- (2) thence South 76°53'24" West a distance of 174.46 feet a point;
- (3) thence South 89°40'44" West a distance of 75.00 feet to an iron pin set at the Point of Ending for this right-of-way description;

Containing 0.083 acres, more or less, of right-of-way.

Subject to all of the above described 40.00 feet wide right-of-way being also reserved unto the grantor, his heirs, and/or assigns, forever, for the purposes of ingress and egress to any and all tract of land which may join said right-of-way.

All iron pins set are rebar with yellow caps labeled "Claus 6454".

**OFFICE COPY
NOT RECORDABLE**

Page 3 of 3

Description of Parcel 11

The bearings in this description are for angle calculations only and are based on the north line Section 8 used as an assumed bearing of South 88°33'21" East.

The above description prepared by Roger W. Clark Registered Surveyor No. 6456, based on a new survey of September 10, 1992


Prior Deed: Deed Volume _____, Page _____

OFFICE COPY
NOT RECORDABLE

DESCRIPTION APPROVED
FOR AUDITOR'S TRANSFER

By J L Namb
10-08-92

LINE	BEARING	DIST.
A	S 74°00'16" E	129.49'
B	S 25°53'42" W	109.05'
C	S 55°16'33" E	75.53'
D	S 10°19'16" E	57.24'
E	S 00°15'47" W	177.47'
F	S 46°27'50" W	227.70'
G	S 01°41'10" W	216.08'
H		
I	S 77°42'12" W	253.46'
J	S 09°47'50" E	60.88'
K	S 09°47'50" E	102.66'
L	S 05°25'12" W	126.72'
M	S 05°25'12" W	38.58'
N	S 12°29'11" W	196.50'
O	S 67°31'49" W	17.57'
P	N 71°02'34" E	110.80'
Q	N 75°28'11" E	79.44'
R	N 78°10'30" E	93.63'
S	N 79°27'10" E	113.68'
T	N 75°36'42" E	148.41'
U	N 75°36'42" E	28.14'
V	N 78°36'18" E	59.84'
W	N 83°03'54" E	54.34'
X	S 80°12'48" E	49.53'
Y	S 77°25'34" E	60.35'
Z	S 77°25'34" E	54.27'
AA	S 87°29'46" E	47.23'
BB	N 87°10'48" E	47.92'
CC	N 78°04'45" E	50.91'
DD	N 69°17'49" E	57.66'
EE	N 60°45'00" E	68.62'
FF	N 55°13'13" E	164.14'
GG	N 57°40'54" E	89.56'
HH	N 49°44'59" E	46.96'
II	N 39°49'35" E	52.43'
JJ		
LL	S 19°37'36" E	85.90'
MM	S 21°31'04" E	86.23'
NN	S 18°44'22" E	138.96'
OO	S 16°55'11" E	226.62'
PP	S 16°29'55" E	67.64'
QQ	S 14°27'59" E	136.87'
RR	S 15°12'40" E	191.00'
SS	S 15°12'40" E	172.14'
TT	S 15°12'40" E	136.52'
UU	S 14°40'10" E	159.99'
VV	S 11°54'34" E	178.48'
WW	S 76°53'24" W	174.46'
XX	S 66°24'44" W	46.43'
YY	S 85°49'00" W	153.00'
ZZ		
(1)	S 17°17'01" N	113.05'
(2)	S 47°34'24" W	29.45'
(3)	S 47°34'24" W	84.15'
(4)	S 21°40'24" W	134.01'
(5)	S 36°37'39" W	137.40'
(6)	S 60°44'24" W	68.70'
(7)	S 77°39'52" W	261.52'

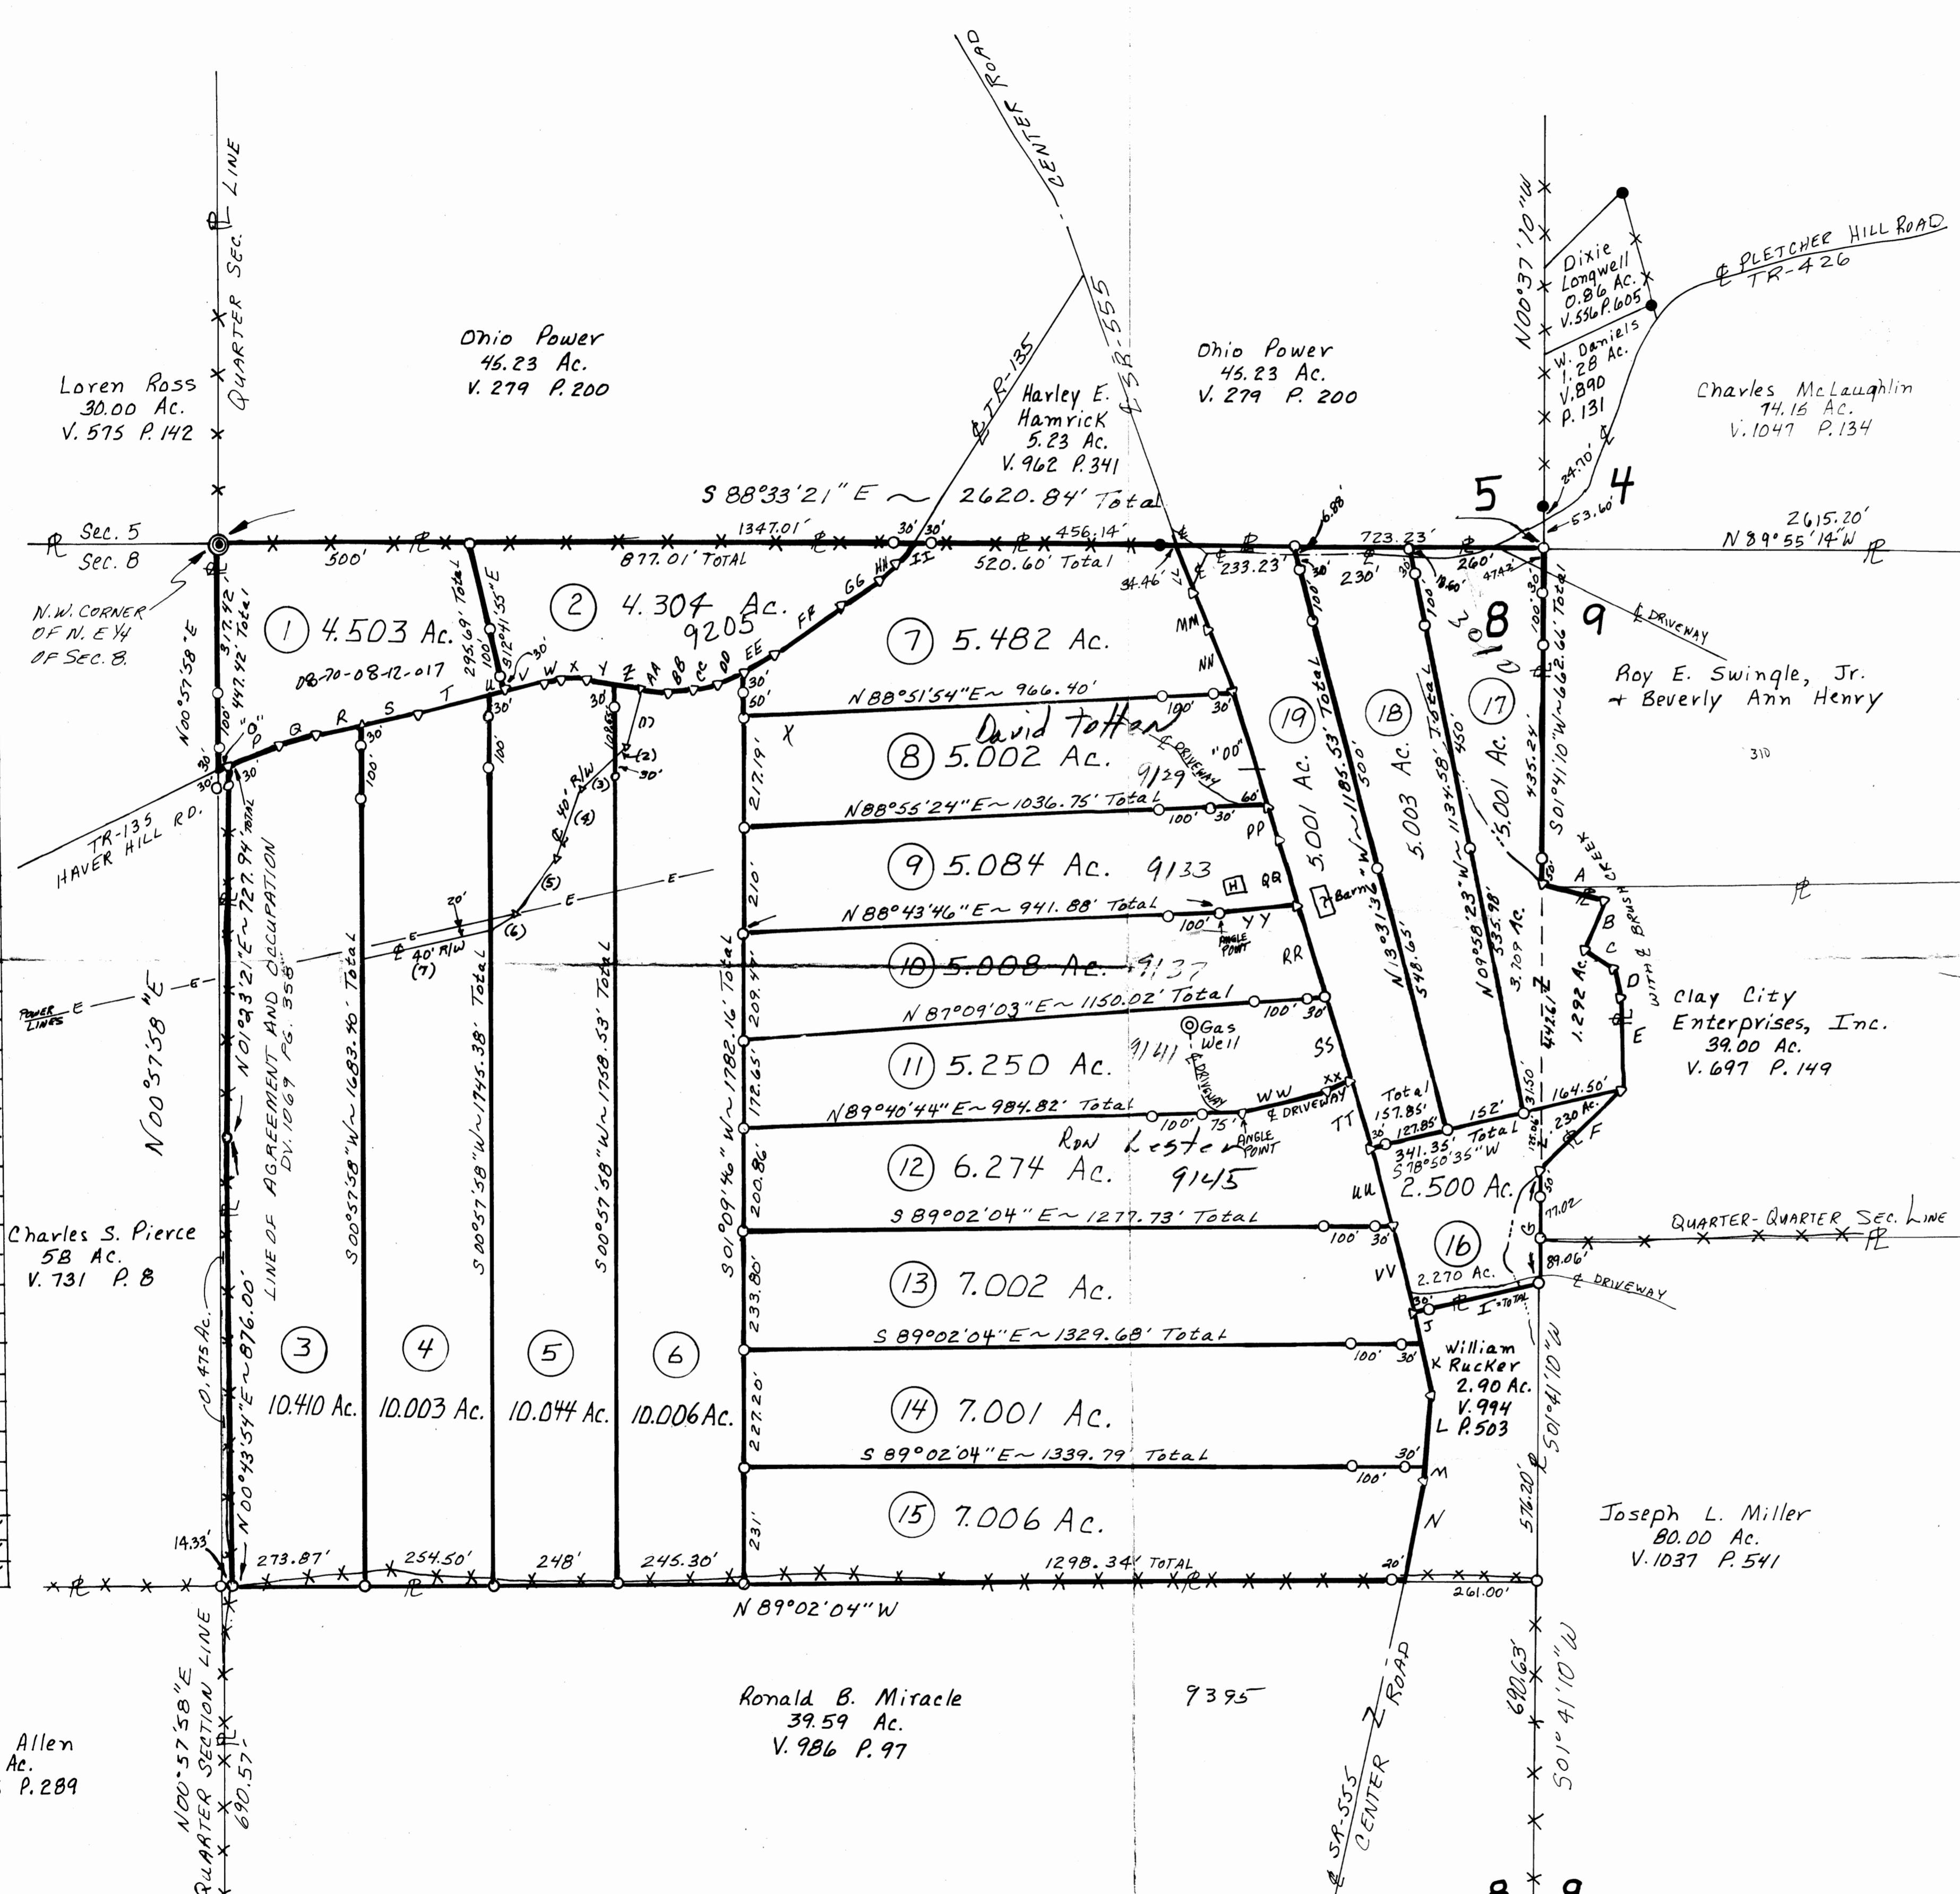

SURVEY PLAT FOR J. J. Detweiler Ent.

SECTION 8 = PARCEL # 08-08-70-08-12-000
SECTION 9 = PARCEL # 08-08-70-09-07-000

SCALE 1" = 200'

Situated in the State of Ohio, County of Muskingum, Township of Brush Creek, being in the Northwest Quarter of Section 9 and the Northeast Quarter of Section 8, Township 10 North, Range 13 West, of the "Congress Lands East of the Scioto River".

- = IRON PIN SET CAPPED "CLAWS 6456".
- = IRON PIN FOUND.
- ◎ = CONCRETE MONUMENT FOUND.
- ▽ = SURVEY ANGLE POINT.
- = MARKED STONE FOUND.
- × = FENCE EVIDENCE FOUND.
- = PROPERTY LINES.
- = LINES OF THIS SURVEY.

RECORD COPY
NOT RECORDABLE
Sept. 28, 1992
T. J. Detweiler

DESCRIPTION APPROVED
FOR AUDITOR'S TRANSFER
BY J. J. Detweiler
10-08-92

920918