

Thomas J. Isa
7/8/87

Situated in the State of Ohio, County of Muskingum,
City of Zanesville, bounded and described as follows:

Commencing at the Northwest corner of Lot 1 of Plantation
Subdivision, Recorded in Plat Book 9, Page 54; thence
North $59^{\circ} 50'$ East 35.00 feet; thence North $30^{\circ} 10'$
West 300.00 feet; thence South $59^{\circ} 50'$ West 325.00
feet to the center of Dresden Road; thence along center
of Dresden Road North $30^{\circ} 10'$ West 100.00 feet to the
place of beginning; thence along Dresden Road North
 $30^{\circ} 24' 33''$ West 99.93 feet; thence leaving Dresden
Road North $59^{\circ} 48' 42''$ East 317.06 feet to an axel
found passing an axel found at 18.00 feet; thence North
 $29^{\circ} 45' 14''$ West 86.42 feet to a pipe found; thence
South $84^{\circ} 40'$ East 320.72 feet to an iron pin set;
thence South $59^{\circ} 48' 42''$ West 578.36 feet to the place
of beginning passing an axel found at 560.36 feet,
containing 1.29 acres more or less.

Bearings are based on those of Plantation Subdivision.

Being all of Auditor's Parcel No. 17-17-39-03-02-000.


Survey & Description by:

~~OFFICE COPY~~
~~NOT RECORDABLE~~
R. Daniels
Registered Surveyor No. 5410

DESCRIPTION APPROVED
FOR AUDITOR'S TRANSFER


BY J. J. Nambel
7-13-87

R L DANIELS & ASSOC.
61 Rainer Rd.
Roseville, Ohio 43777
Ph. (614) 697-7480

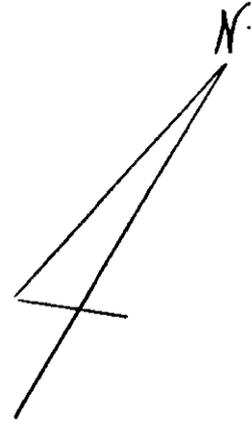

1" = 100'

OFFICE COPY
NOT RECORDABLE

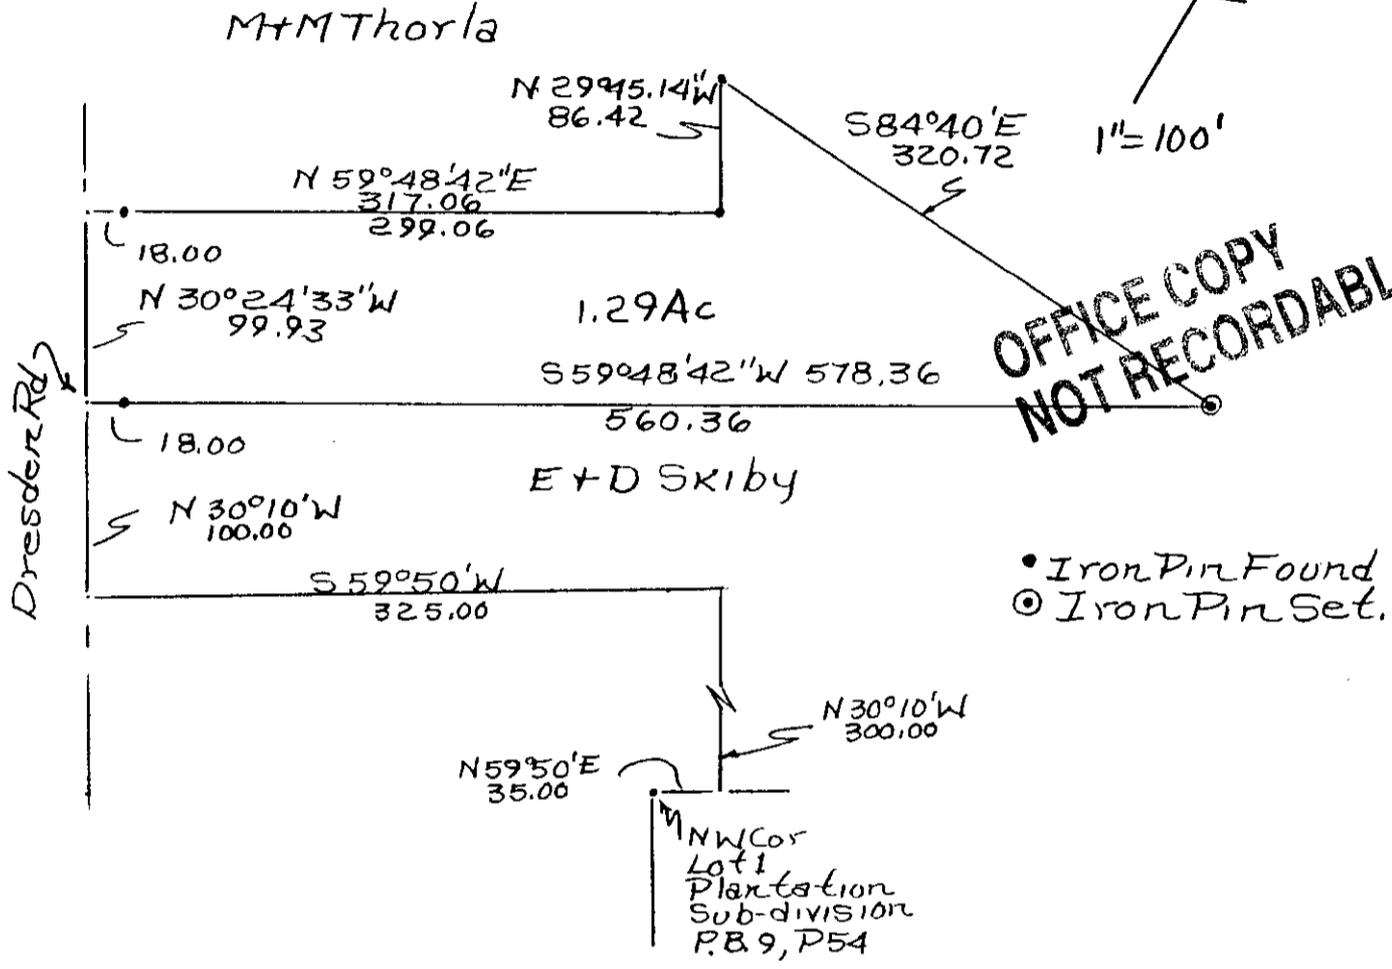

Survey Of Thomas J. Isa
Property @ 3394 Dresden
Road Zanesville 7/8/87
By R L Daniels Reg Surveyor
No. 5410
Zanesville, Ohio
Franklin County, City
of Zanesville

OFFICE COPY
NOT RECORDABLE

DESCRIPTION APPROVED
FOR AUDITOR'S TRANSFER

BY A J Nambel
7-13-87