Situated in the State of Ohio, County of Muskingum, Township of Jefferson, Village of Dresden, being a part of J.W. Lanning's Subdivision as replatted in Plat Book 10, Page 39 A and being further described as follows;

Commencing at an iron pin - set (5/8" X 30" re-bar with identification cap) at the point of intersection of the south right-ofway line of Seventh Street - Mound Street - with the west rightof way line of Cass Street, said point of intersection being also the northeast corner of Lot 1 of the said J.W. Lannings re-plat, thence, South 21° 03' 03" East, 377.52 feet along the west line of Cass Street to the point of beginning at the intersection of the west line of Cass Street and the south line of vacated Eighth Street,

thence, South 210 03' 03" East, 133.13 feet along the west line of Cass Street to a point,

thence, Sauth. 690 00' 43" West, 182.34 feet across Lots 13, 14 and 15 of the said J.W. Lannings Subdivision to a point on the Limited Access Line of State Route 50 (Refer to State of Ohio Department of Transportation Right-of-Way Plans MUS - 60-31.70),

thence, North 27° 32' 29" West, 134.19 feet along the said Limited Access Line to a point of intersection with the south line of vacated Eighth Street at an existing iron pin,

thence, North 69° 03' 51" East, 197.51 feet along the south line of vacated Eighth Street being also the south line of Phase IV to the point of beginning,

Phase V Area 25,302 Sq. Ft. = 0.5808 acres +

Phase V Building Unit Areas

Unit V-A 1423 Sg. Ft.

Unit V-B First Floor 1602 Sq. Ft.

> Second Floor 525 Sq. Ft.

Unit V-C 1602 Sq. Ft.

Unit V-D 1423 Sq. ft.

Common Area 25,302 Sq. Ft.

Each Unit responsible for \$\frac{1}{3}\$ of the common area.  $\frac{1}{2}$  of 25,302 Sq. Ft. = 6,325.5 Sq. Ft. = 0.1452 acres.

Part of J.W. Lannings Subdivision, Plat Book 10, Page 39 A

Part Lot 13 Part 33-33-30-14-01 (60 x 133)

Part Lot 14 Part 33-33-30-14-02 (60 X 133)

Part Lot 15 Part 33-33-30-14-03 (60 X 133)

Part Lot 16 All 33-33-30-14-04

Prior Deed Reference Volume 1055, Page 620

DESCRIPTION APPROVED FOR AUDIFORS TRANSFER

Survey and Description by

OFFICE CODVactor
Register Surveyor #5437
December OFDABLE

40 60 100 SCALE 1"= 20'

PHASE I BLDG AREA 6050 Sq. Ft = 0.1389 A. t COMMON AREA 25,302 59, Ft = 0.5808 Ac. + TOTAL AREA 25,302 59, Ft = 0.5808 Ac. +


> BLDGY UNIT AREAS UNITY A 1423 Sq. Ft. First Floor 1602 Sq. Ft. Second Floor 525 Sq. Ft. UNITY C 1602 Sq. Ft. UNITY D 1423 Sq. Ft.

COMMON AREA EACH UNIT IS RESPONSIBLE FOR 1/4 OF THE COMMON AREA

TRANSFER INFORMATION PART U.W. LANNING RE-PLAT PLAT BOOK 10, PAGE 39-A PART LOT 13 PART 33-33-30-14-01 (60 x /33) LOT 14 " 33-33-30-14-02 (60x 133) LOT 15 " 33-33-30-14-03 (60x/33 LOT 16 ALL 33-33-30-14-04

PRIOR DEED VOL 1055, PAGE 620

DESCRIPTION APPROVED 12-4-95

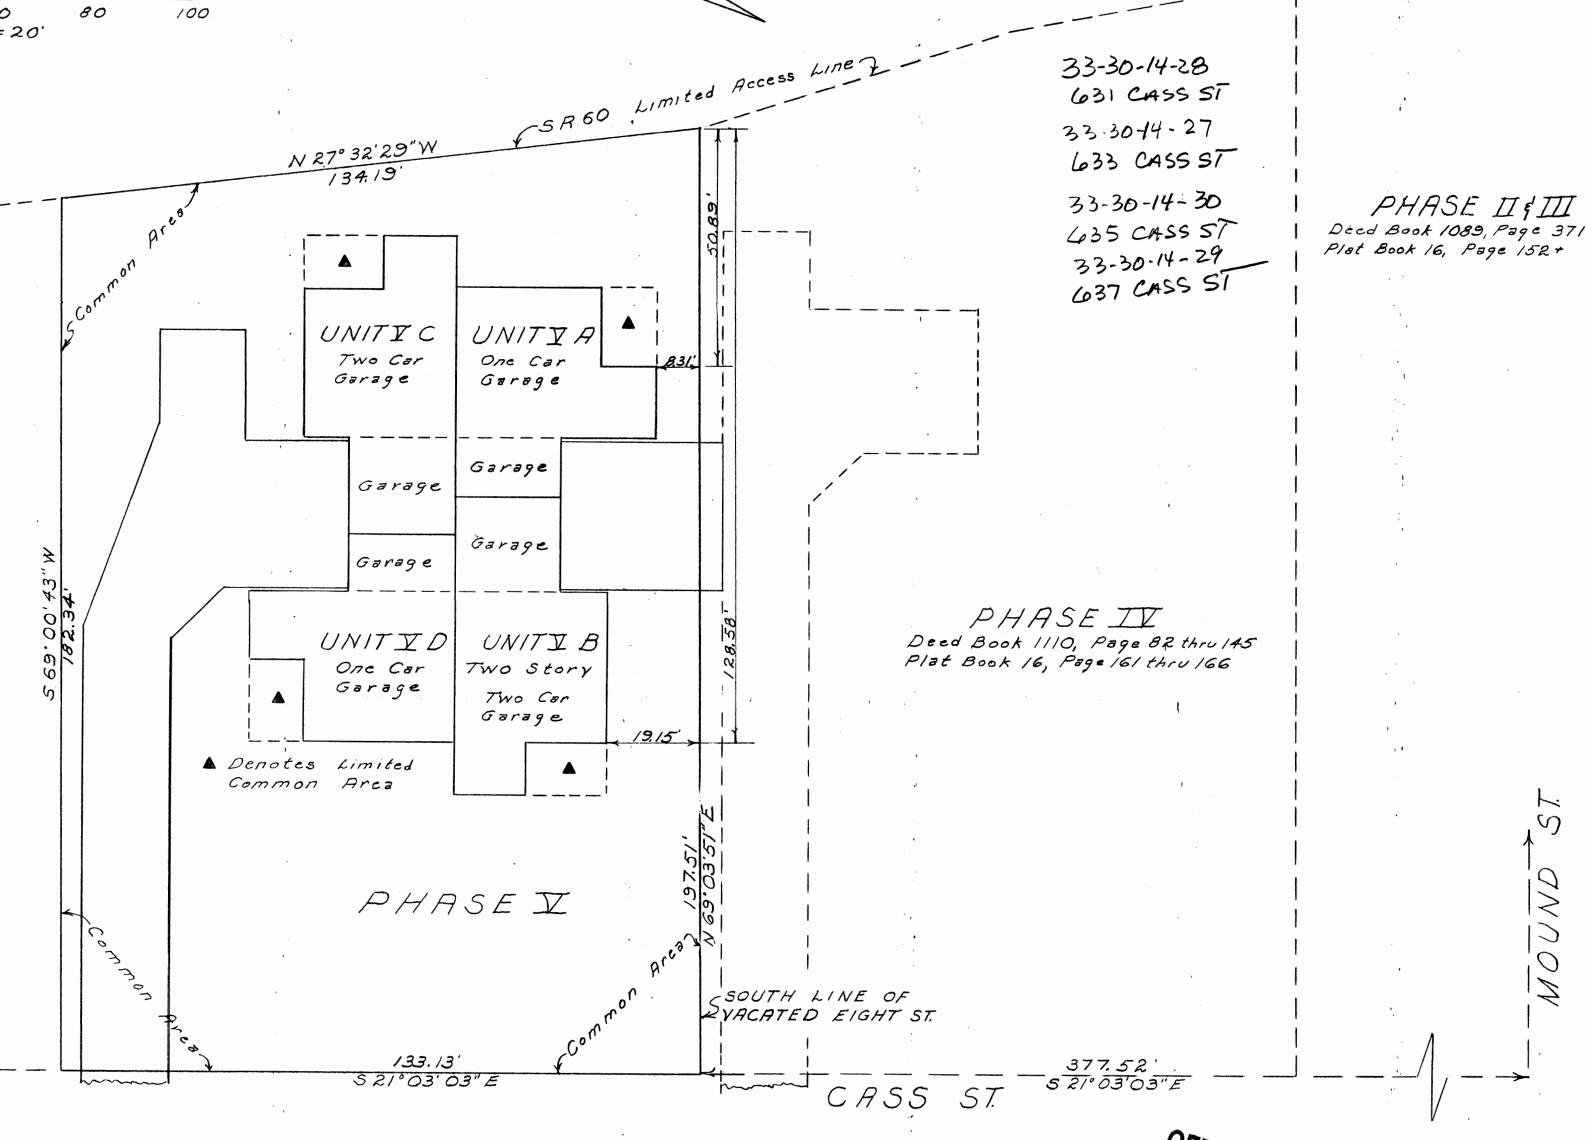

I hereby certify that this unit location plan correctly represents a boundary survey made by me and shows the building as constructed November 1995 Willem H. Wewark William H. Derwacter Registered Surveyor \* 5437

I hereby certify that this plat is a correct representation of a survey made by me and that it correctly shows all buildings and improvements as constructed November 1995 William H. Dewate Registered Surveyor \$5437 Registered Engineer #

FOR DECLARATION. AND BYLAWS PAGE SEE DEED YOL THRU



STATE OF OHIO COUNTY OF MUSKINGUN

RECEIVED FOR RECORD The day of December 1995 RECORDED day of December 1995

RECORDER

TRANSFERED day of December 1995

AUDITOR

PHASEY SITUATED IN County of Muskingum Township of Vefferson Village of Dresden

PHASE II & III