

53-20-04-08

DILED DESCRIPTION

FOR

WILLIAM PYLE

Situated in the Township of Rich Hill, County of Muskingum, State of Ohio and being 0.384 acres more or less in the Northeast Quarter of Section # 4, Township # 13 North, Range # 11 West of the Congress Lands part of the Scioto River Survey and being more particularly described as follows:

Commencing at a stone found at the southwest corner of the Northeast ~~East~~ Quarter of Section # 4, Thence with the south line of the Northwest ~~East~~ Quarter of Section # 4 S 83° 39' 42" E a distance of 2475.60 feet to a railroad spike set the BEGINNING, Thence with the lands of ^{now or formerly} Harrison Leasing Company as found in Volume 600 Page 13 of the Deed records of Muskingum County, Ohio N 07° 35' 25" W a distance of 99.00 feet to an iron pin set, Thence with the lands of now or formerly William Pyle as found in Volume 702 Page 53 of the deed records of Muskingum County, Ohio S 83° 39' 42" E a distance of 169.00 feet to the east line of the Northeast ~~East~~ Quarter of Section # 4, Thence with the east line of the Northeast ~~East~~ Quarter of Section # 4 S 07° 35' 25" W a distance of 99.00 feet to a P. K. Rail set at the Southeast corner of the Northeast ~~East~~ Quarter of Section # 4, Thence with the south line of the Northeast ~~East~~ Quarter of Section # 4 N 83° 39' 42" W a distance of 169.00 feet to the beginning and containing 0.384 acres more or less and being all the property conveyed of William Pyle in Volume 722 Page 64 of the deed records of Muskingum County, Ohio.

Being Aut. Parcel # 53-53-20-04-08-000.

Subject to all easements or leases of public record.

Iron pins set are 5/8 inch rebar 30 inches long, capped SPILKER 10-58n2. Bearings are magnetic and are for angle purposes only.

A survey of the above described property was made by Joseph T. Spilker, Registered Surveyor # S-58n2 on October 9, 1987.

OFFICE COPY
NOT RECORDABLE

DESCRIPTION APPROVED
FOR AUDITOR'S TRANSFER


BY J. T. Spilker
10-19-87

Legend ?

- Stone Found
- Iron Pin Set
- △ P.K. Nail Set
- ▲ Railroad Spike Set


50 25 0 50

Scale: 1" = 50'

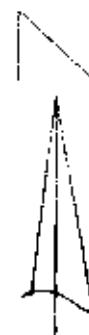

William Pyle

v. 702 p. 52

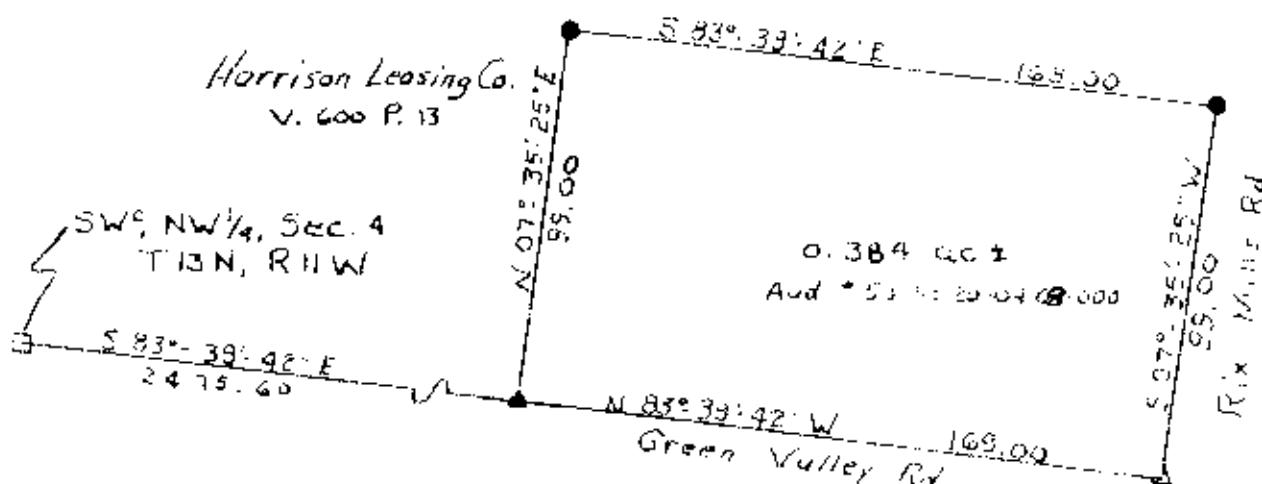

Survey Plot of 0.384 acres ±
William Pyle
NE 1/4, Sec. 4
Twp 13 N, Range 11 W
Rich Hill Twp. Muskingum Co. Ohio
Ref.: Vol. 722 Page 64
October 5, 1987



10-14-87

OFFICE COPY
NOT RECORDABLE
Joseph F. Springer
Registered Surveyor #S-802
DESCRIPTION APPROVED
FOR AUDITOR'S TRANSFER
BY J. F. Springer
10-14-87