
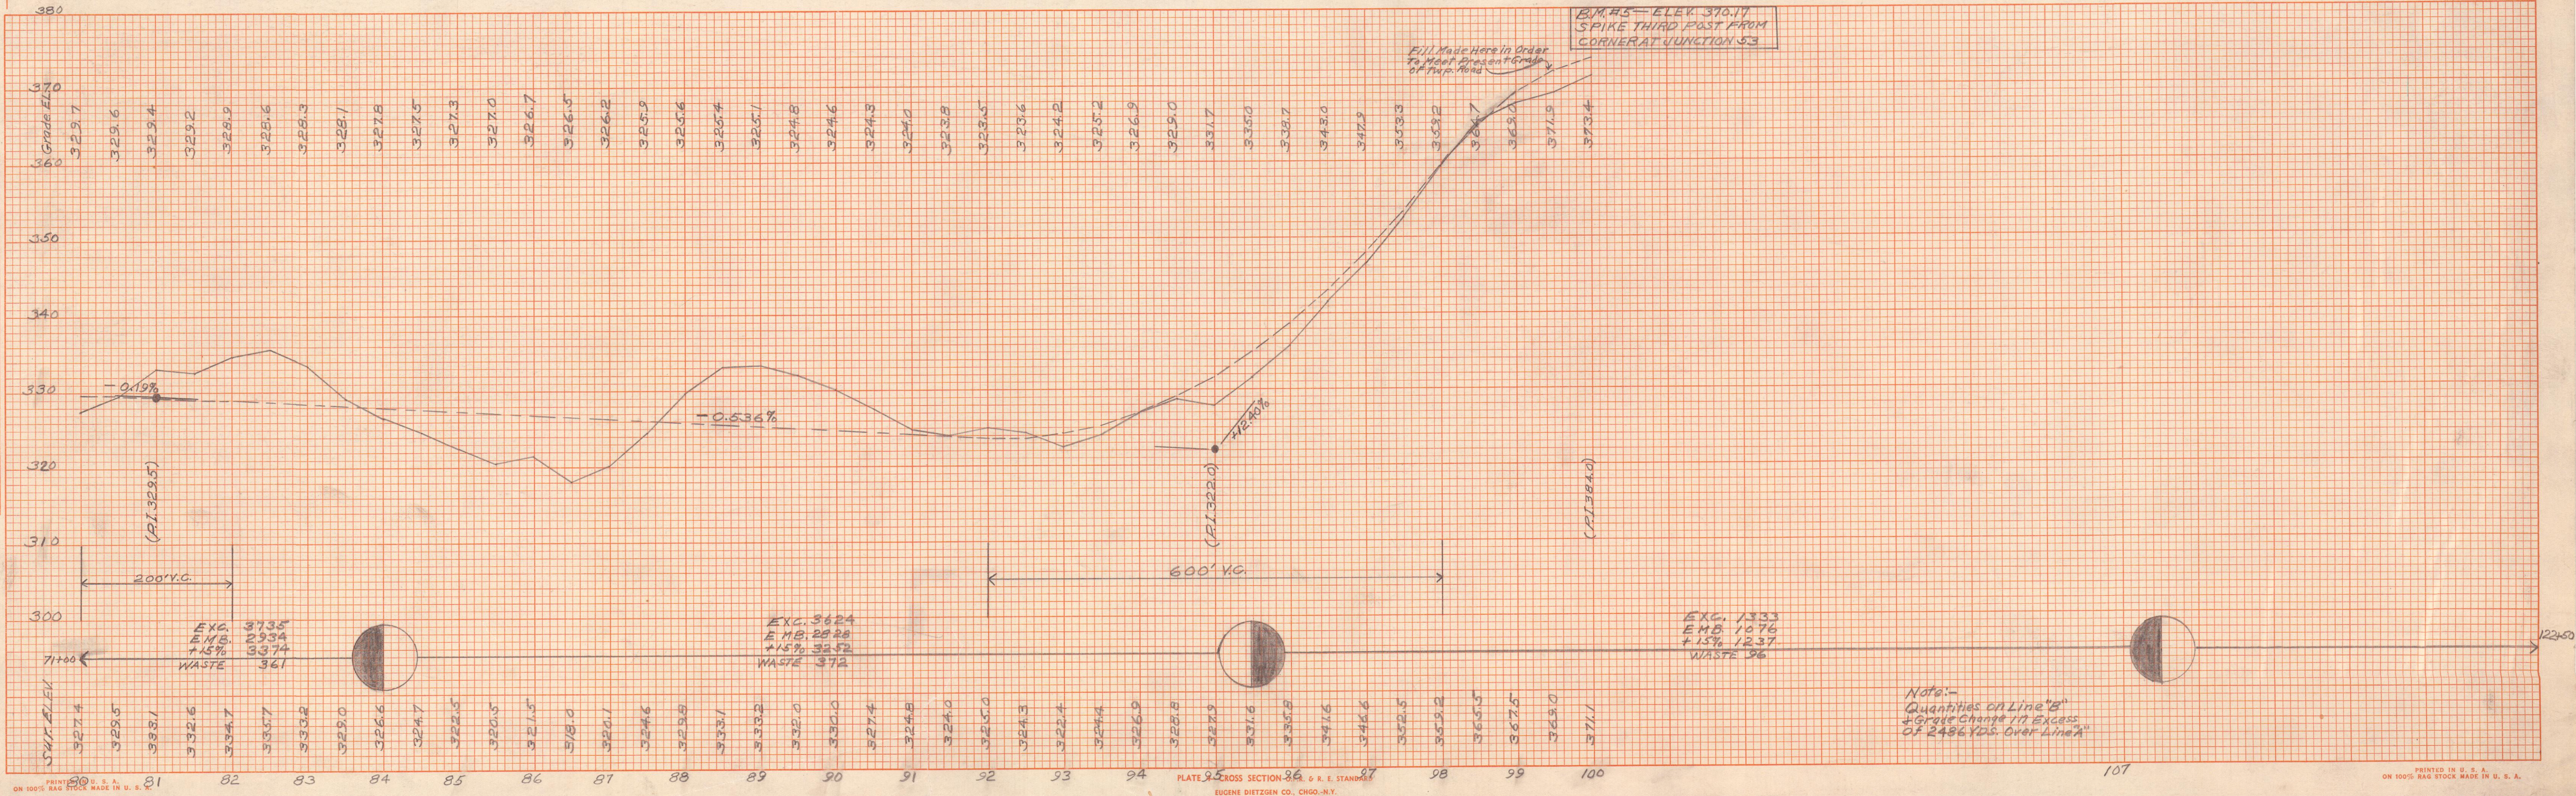


FINAL SURVEY	DATE
SURVEYED	BY
PLOTTED	JOHN J. JONES
NOTE BOOK	DATE
AREAS CHECKED	NO. 2-57

ORIGINAL SURVEY	DATE
SURVEYED	BY
PLOTTED	JOHN J. JONES
NOTE BOOK	DATE
AREAS CHECKED	NO. 2-57

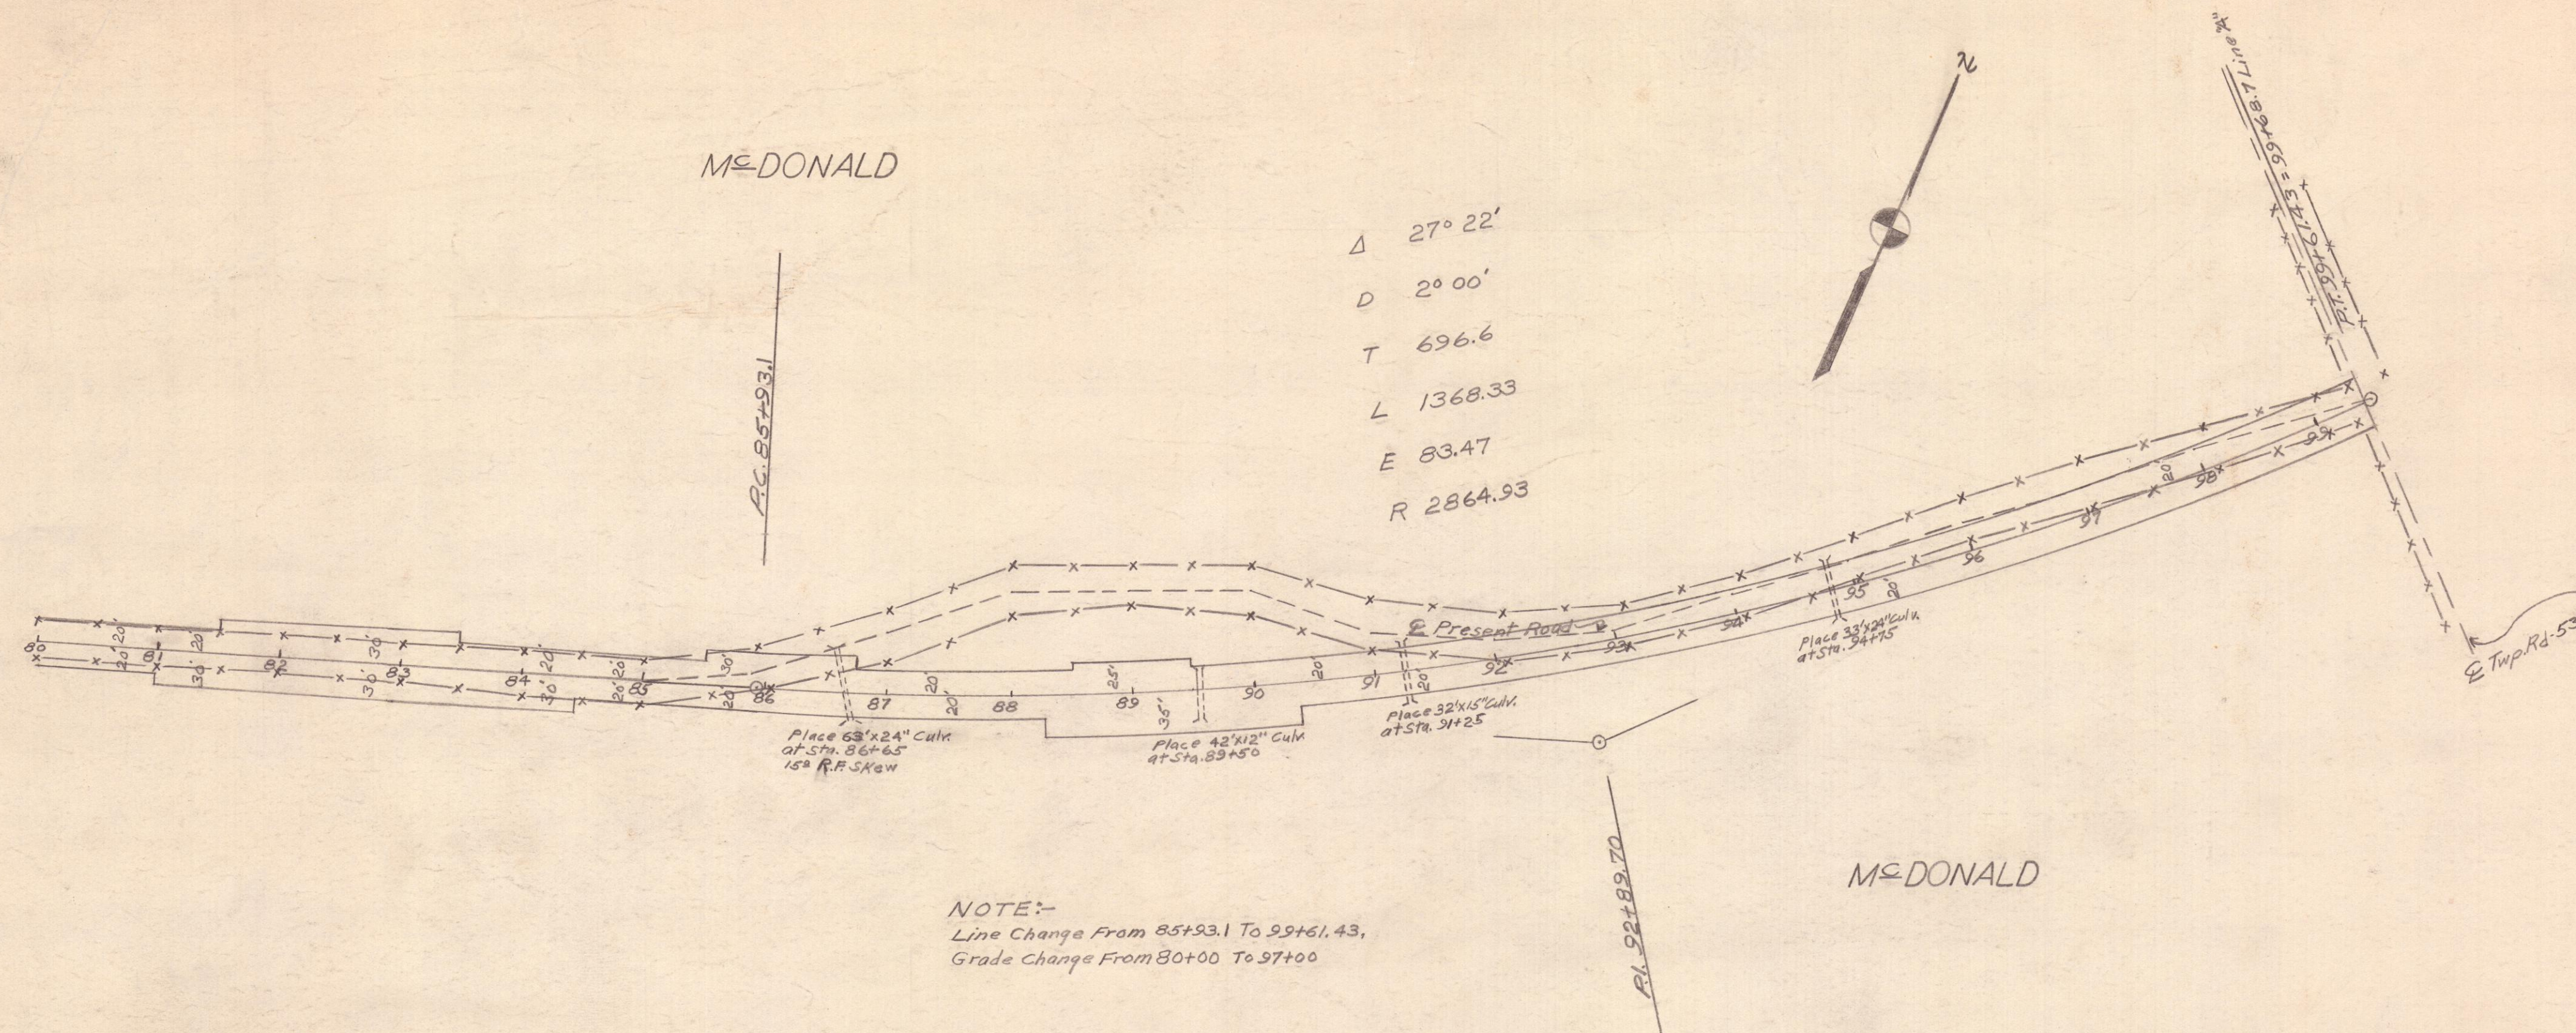

0-101