


MUSKINGUM COUNTY
ENGINEERING DEPT.

TWP RD.No.117 CASS TWP.

SCALES: HOR. 1"=100'
VER. 1"=10'

BOOK No. B-59

APPROVED	APPROVED
MUSKINGUM CO. COMMISSIONER	MUSKINGUM COUNTY ENGINEER

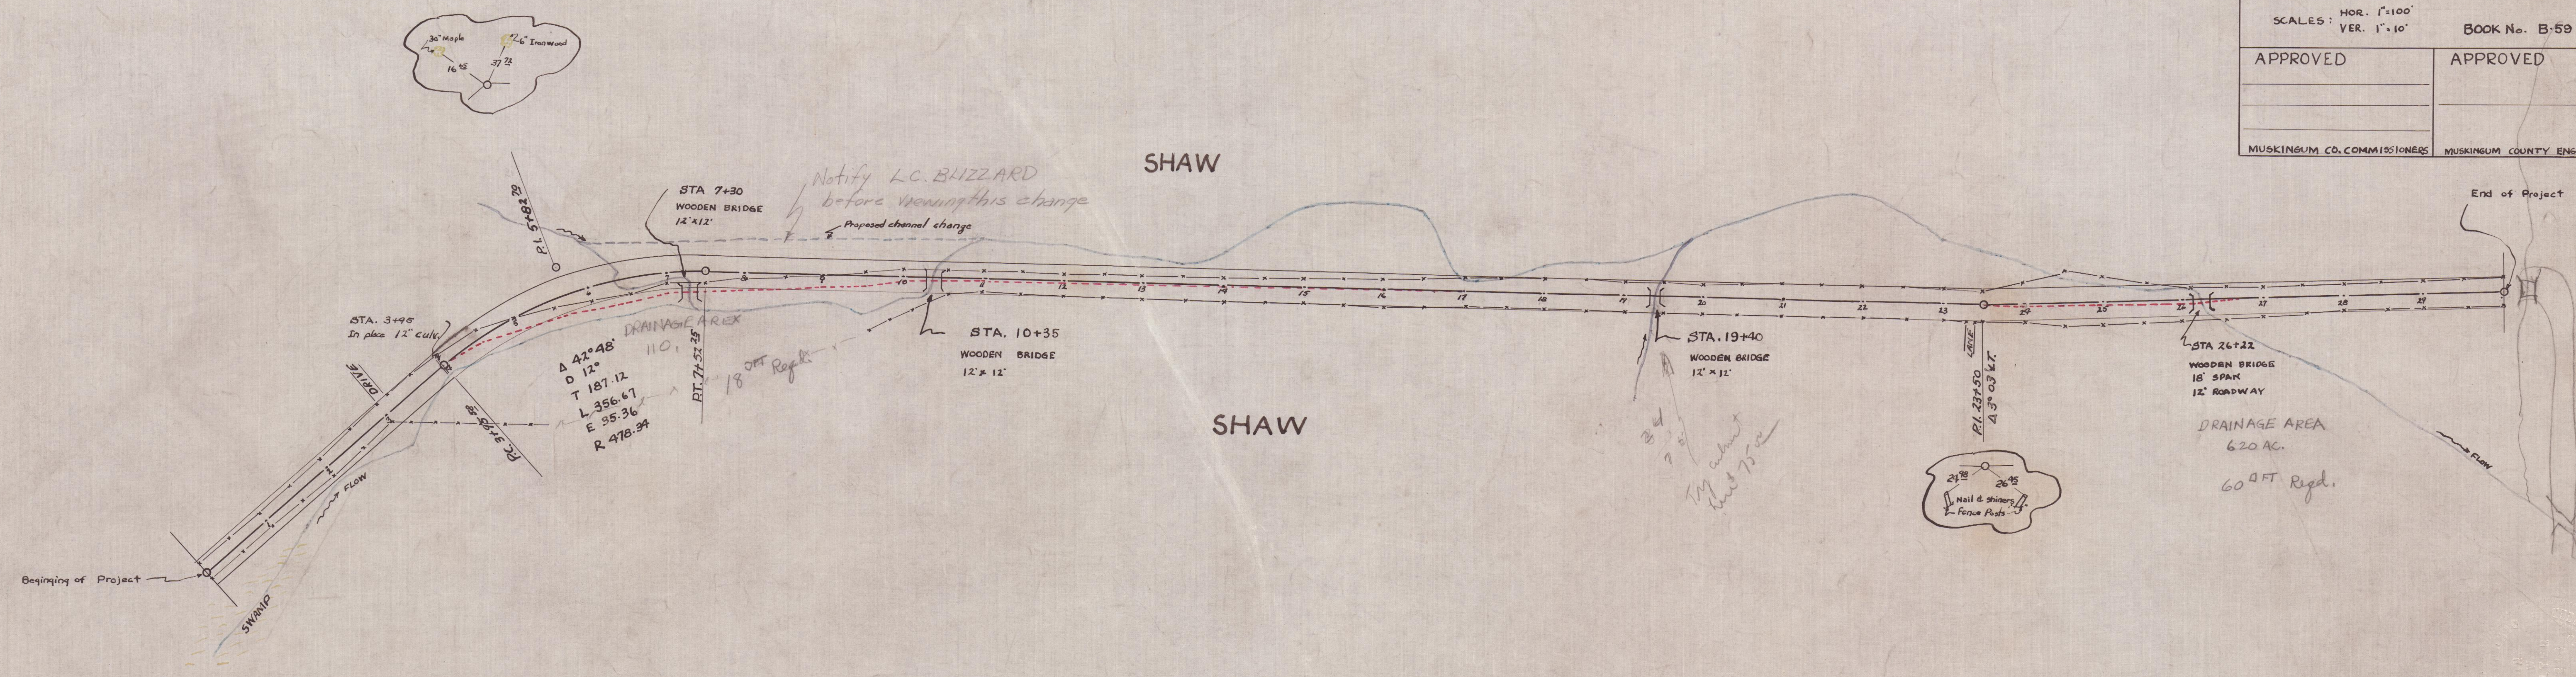

BM.#1 ELEV. 100.00
2 nails in 14" twin Locust
30' left Sta. 2+55

BM.#2 ELEV. 82.28
2 nails in Tel. pole No. 50
opposite Sta. 9+20

BM.#3 ELEV. 65.14
2 nails in Tel. pole left of
Sta. 18+44

BM.#4 ELEV. 57.25
2 nails in Tel. pole left
of Sta. 29+60

