


- | | | |
|--|---|--|
| ① 416°35' RT.
D 9°
T 92.78'
L 184.26'
EX 6.72' | ⑥ 461°20' LT.
D 36°
T 94.38'
L 170.38'
EX 25.88' | ⑪ 440°10' RT.
D 30°
T 59.77'
L 114.35'
EX 10.87' |
| ② 48°30' RT.
D 5°
T 85.16'
L 170.0'
EX 3.16' | ⑦ 427°14' RT.
D 14°
T 99.2'
L 194.52'
EX 11.99' | ⑫ 428°30' RT.
D 15°
T 97.0'
L 190.0'
EX 12.14' |
| ③ 426°25' LT.
D 14°
T 96.06'
L 188.69'
EX 10.84' | ⑧ 48°30' LT.
D 5°
T 85.16'
L 170.0'
EX 3.16' | ⑬ 49°61' LT.
D 5°
T 92.87'
L 185.33'
EX 3.76' |
| ④ 425°05' RT.
D 13°
T 98.04'
L 192.95'
EX 10.75' | ⑨ 428°40' RT.
D 15°
T 97.6'
L 191.1'
EX 12.27' | ⑭ 422°40' LT.
D 12°
T 95.7'
L 188.99'
EX 9.66' |
| ⑤ 420°15' LT.
D 11°
T 93.01'
L 184.1'
EX 8.1' | ⑩ 467°50' LT.
D 37°
T 104.12'
L 183.33'
EX 31.77' | |

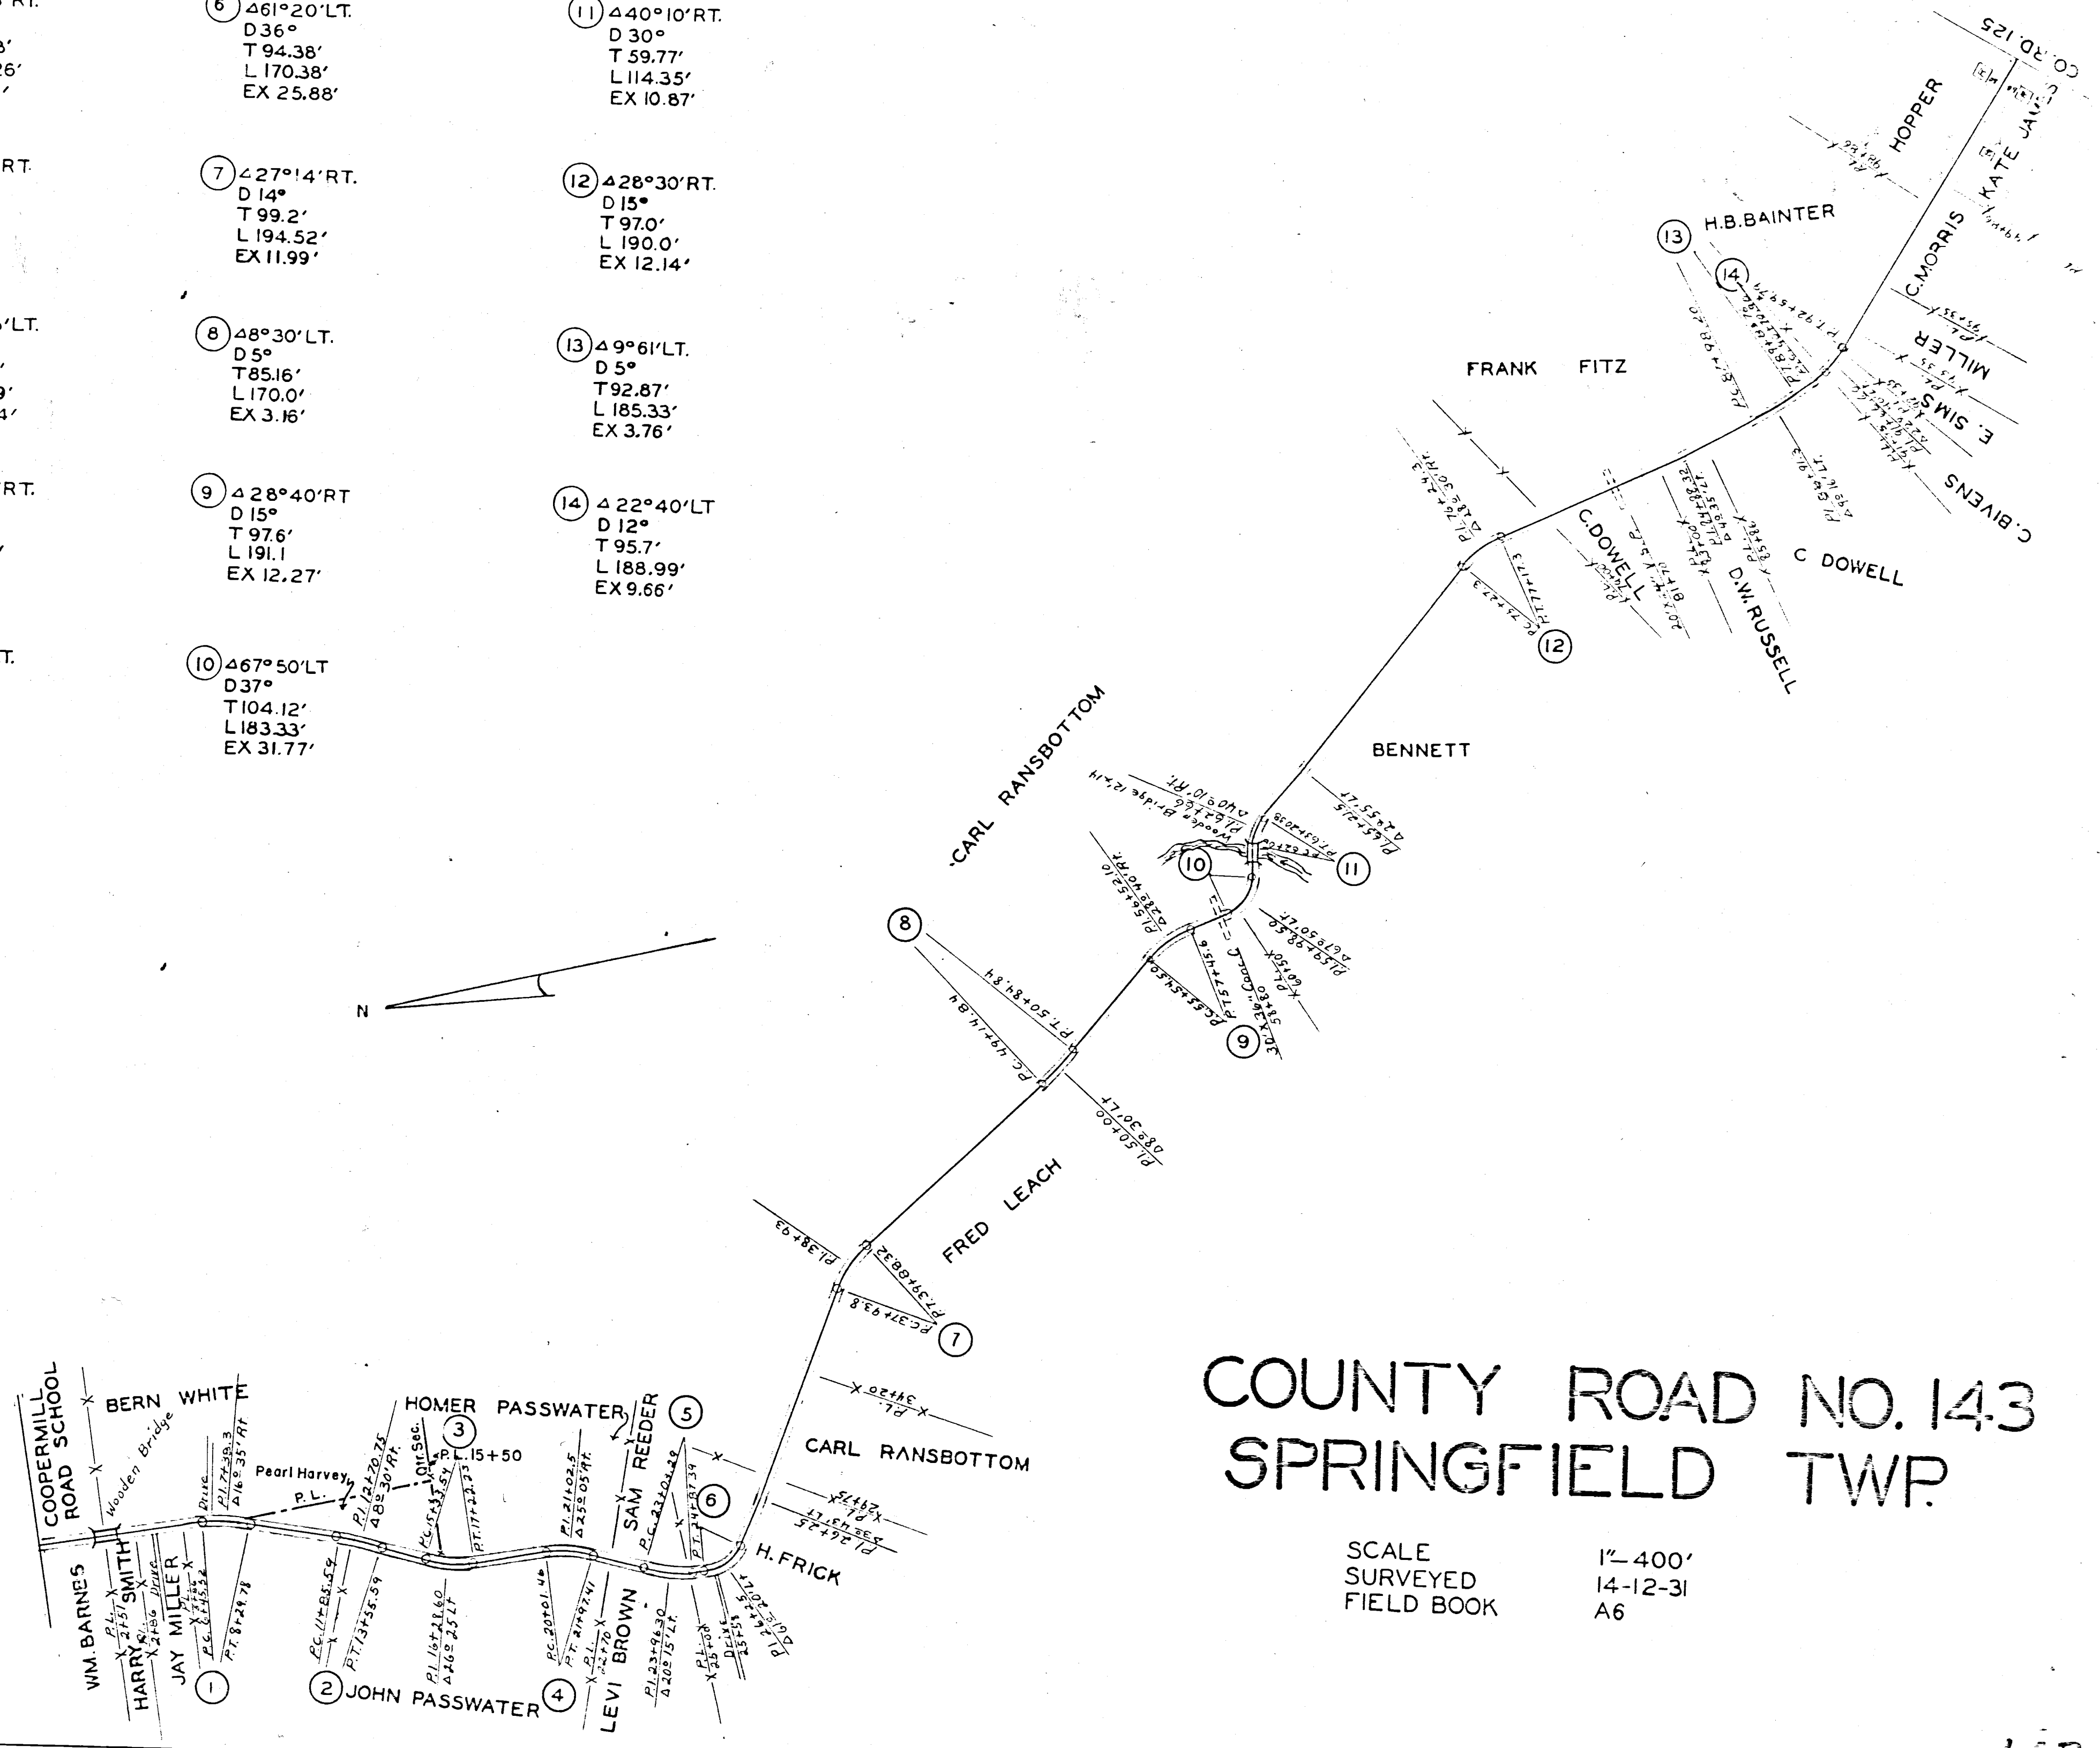

COUNTY ROAD NO. 143 SPRINGFIELD TWP.

SCALE
SURVEYED
FIELD BOOK
1"=400'
14-12-31
A6