

Received June 1964 Time 1:00 PM
Recorded Page
Plat Book Recorder, Muskingum Co., Ohio
Signed Paid
Fee 1.00

LOCATION PLAN


MUS-146-8.13 MUSKINGUM CO.

NEWARK-ZANESVILLE ROAD

FED. RD. DIVISION	STATE	PROJECT
2	OHIO	

1/7


Note:- This Instrument Prepared by the Ohio
Dept. of Hwys., under the Supervision
of Harry P. Brannon, P.E. No. 15394.
Signed: Harry P. Brannon
Registered Surveyor No. 2694
Resident Division Deputy Director
Date: 1-11-63

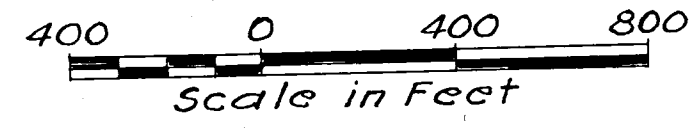

MUSKINGUM CO. FALLS TWP.
QTRS. 1 & 2 T. 1 R. 8 U.S.M.L.

Existing & S.R. 146 (1959 Survey)
See Plans for MUS-146-6.09

Note:-
For the 1958 & of Survey of S.R. 146 see
Location Plan for MUS-146-10.31
recorded in Book 9, Page 63 of the
Muskingum Co. Plat Records.

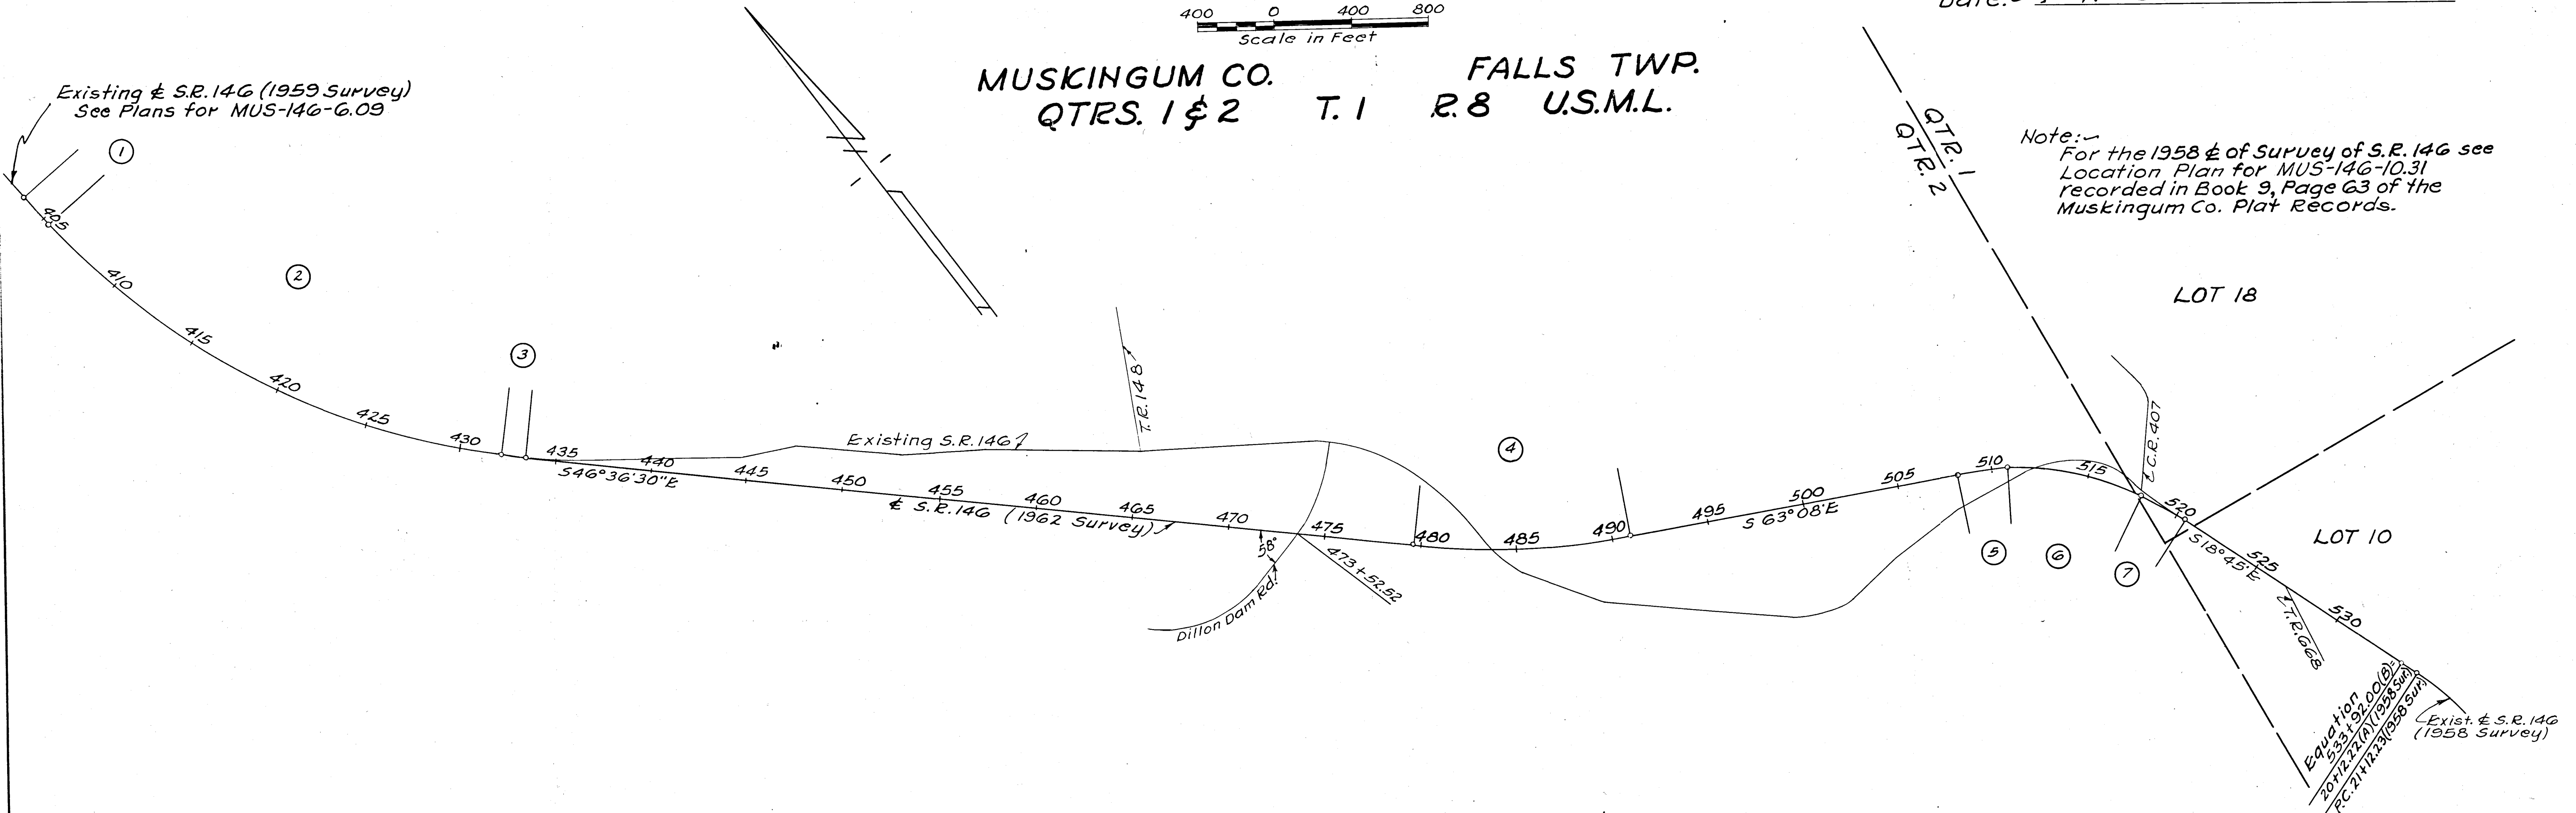

S.R. 146 Curve Data

①	②	③	④	⑤	⑥	⑦
T.S. 403+48.05 S.C. 405+48.05 Ls 200' Cs 1°30' Xc 199.99' Yc 1.75'	S.C. 405+48.05 P.C.C. 432+15.00 Δ 40°00'45" Lt. D 1°30' R 3819.72' T 1390.26' L 2666.95'	P.C.C. 432+15.00 P.T. 433+48.34(B)= 433+48.33(A) Δ 1°30' Lt. D 1.12455° R 5093.20' T 66.67' L 133.34'	P.C. 479+69.07 P.T. 490+95.77 Δ 16°31'30" Lt. D 1°28' R 3906.53' T 567.31' L 1126.70' E 40.98'	P.C. 508+15.50 P.C.C. 510+82.21(B)= 510+82.14(A) Δ 8°00' Rt. D 2.999466° R 1910.20' T 133.58' L 266.71'	P.C.C. 510+82.21(B)= 510+82.14(A) P.C.C. 517+91.72 Δ 28°23' Rt. D 4°00' R 1432.39' T 362.23' L 709.58'	P.C.C. 517+91.72 P.T. 520+58.43(B)= 520+58.36(A) Δ 8°00' Rt. D 2.999466° R 1910.20' T 133.58' L 266.71'

Note:
Centerline Reference Monuments
Consisting of 1" Iron Pins Set by
Richard Kern in Oct., 1964.

CENTER LINE REFERENCE MONUMENTS WILL BE SET AFTER CONSTRUCTION

