

Indicates U.S.A. Dillon Dam Project Fee Tract;
Flowage Easement or Highway Easement.


Existing Curve Data
P.I. = 34+70.14 Ls = 400.00'
Δ = 13°43' Lt. @s = 4°00'
Δc = 5°43' Ts = 544.81'
Dc = 2°00' Xc = 399.80'
Rc = 286.479' Yc = 9.30'
Lc = 285.83' Es = 22.98'

Carl H. McKee &
Maybelle L. McKee
Cont. 1.43 Ac.±
P.R.O. 1.66 Ac.±

FED. RD. DIVISION	STATE	PROJECT
2	OHIO	S-703(3)


MUS-146-0.72
R/W PLAN

3
5

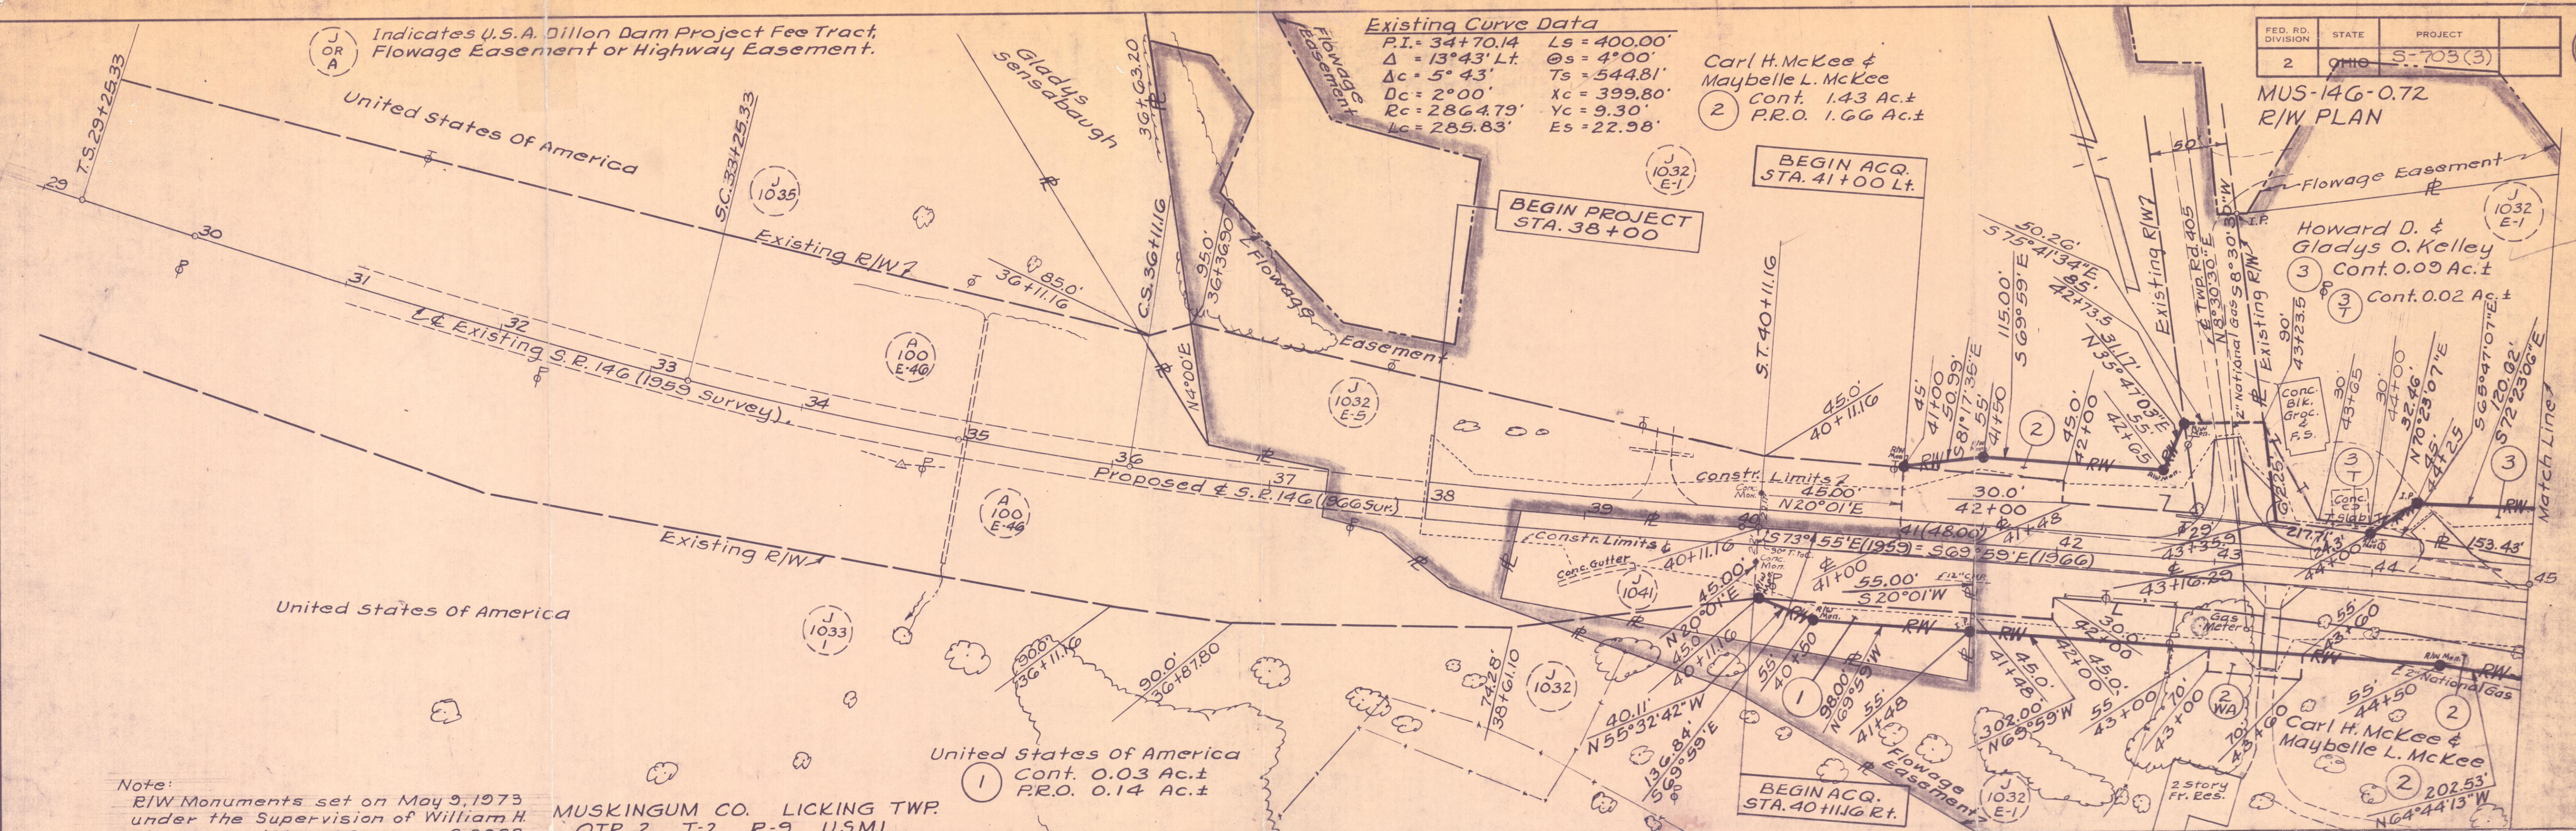

Note:
R/W Monuments set on May 9, 1973
under the Supervision of William H. Nichols
Registered Surveyor S-3982.

MUSKINGUM CO. LICKING TWP.
QTR. 2 T-2 R-9 U.S.M.L.

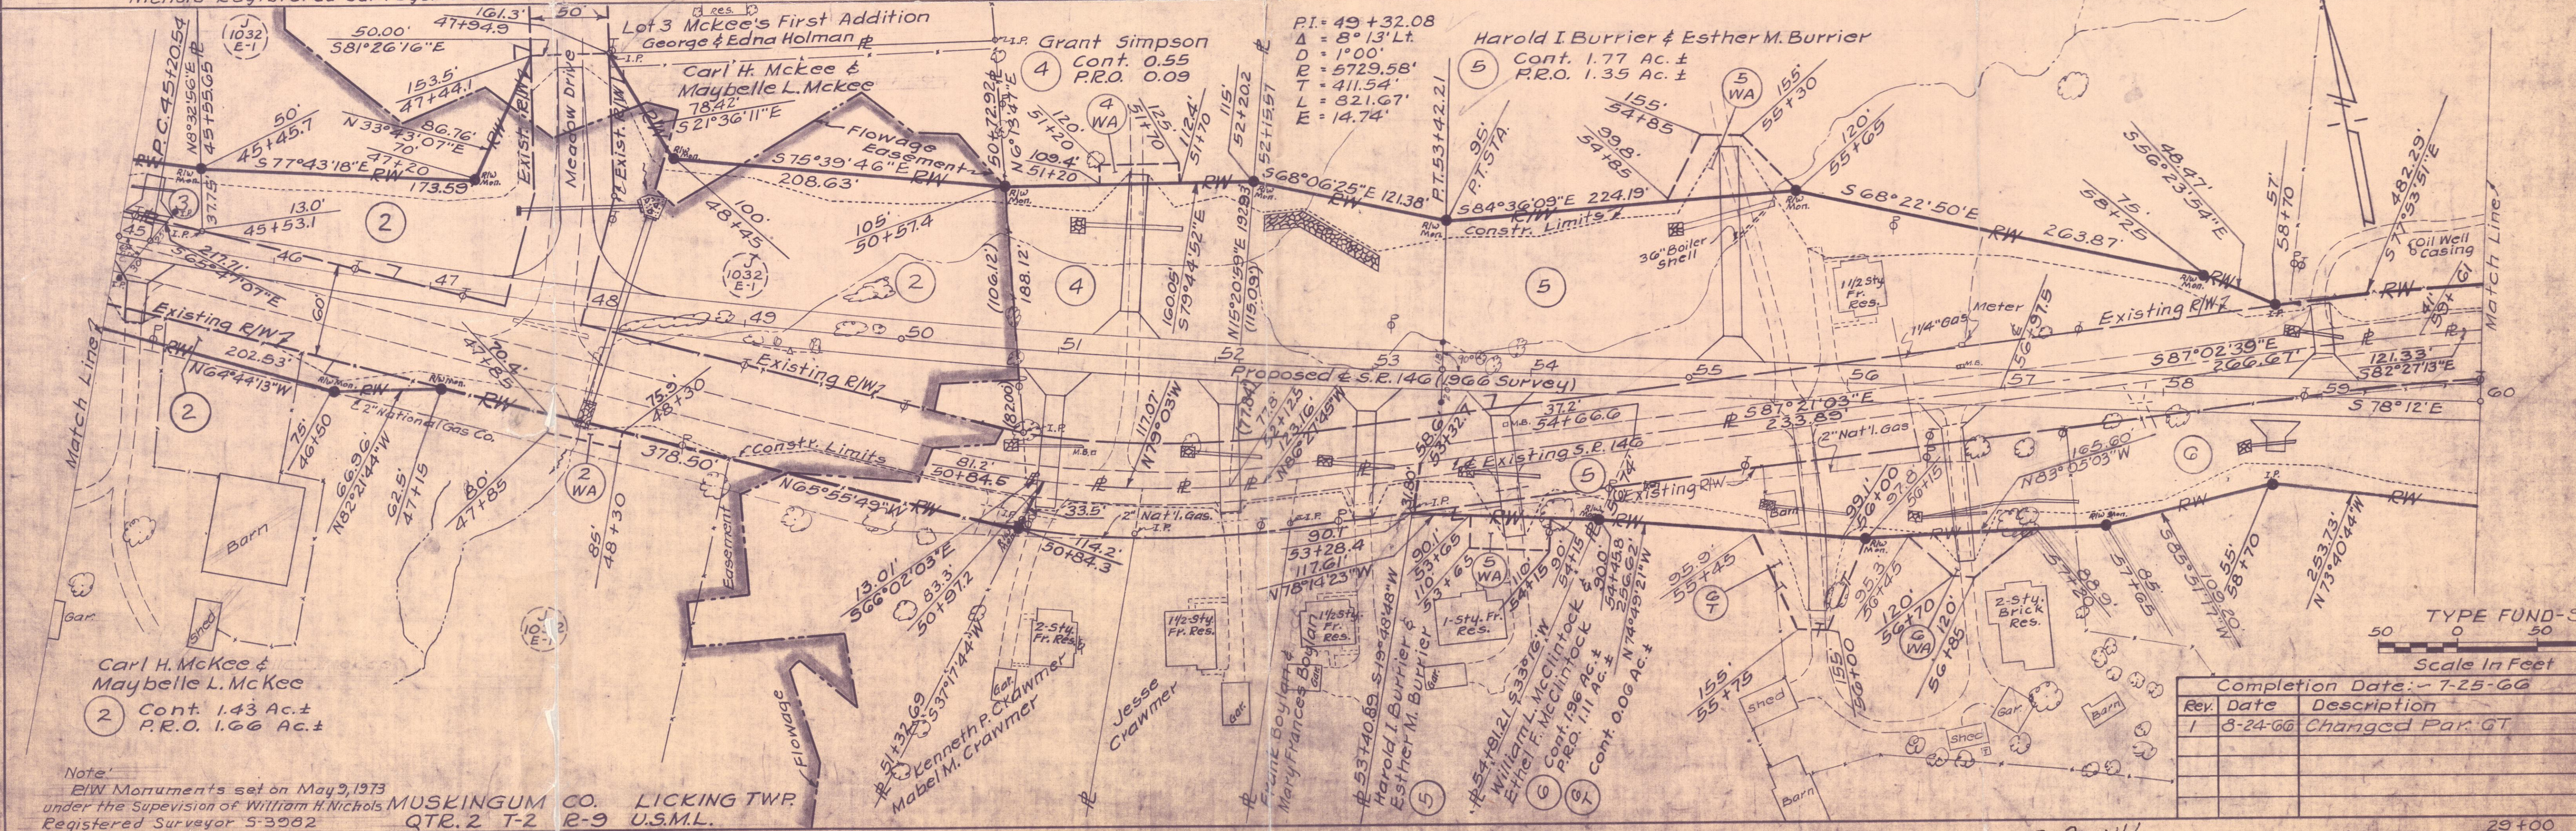

Carl H. McKee &
Maybelle L. McKee
Cont. 1.43 Ac.±
P.R.O. 1.66 Ac.±

Note:
R/W Monuments set on May 9, 1973
under the Supervision of William H. Nichols
Registered Surveyor S-3982.

MUSKINGUM CO. LICKING TWP.
QTR. 2 T-2 R-9 U.S.M.L.

TYPE FUND-5
Scale In Feet
0 50 100

Rev.	Date	Description
1	8-24-66	Changed Par. 6T

S.R. 146

MUS-146-0.72

29+00
60+00

3