
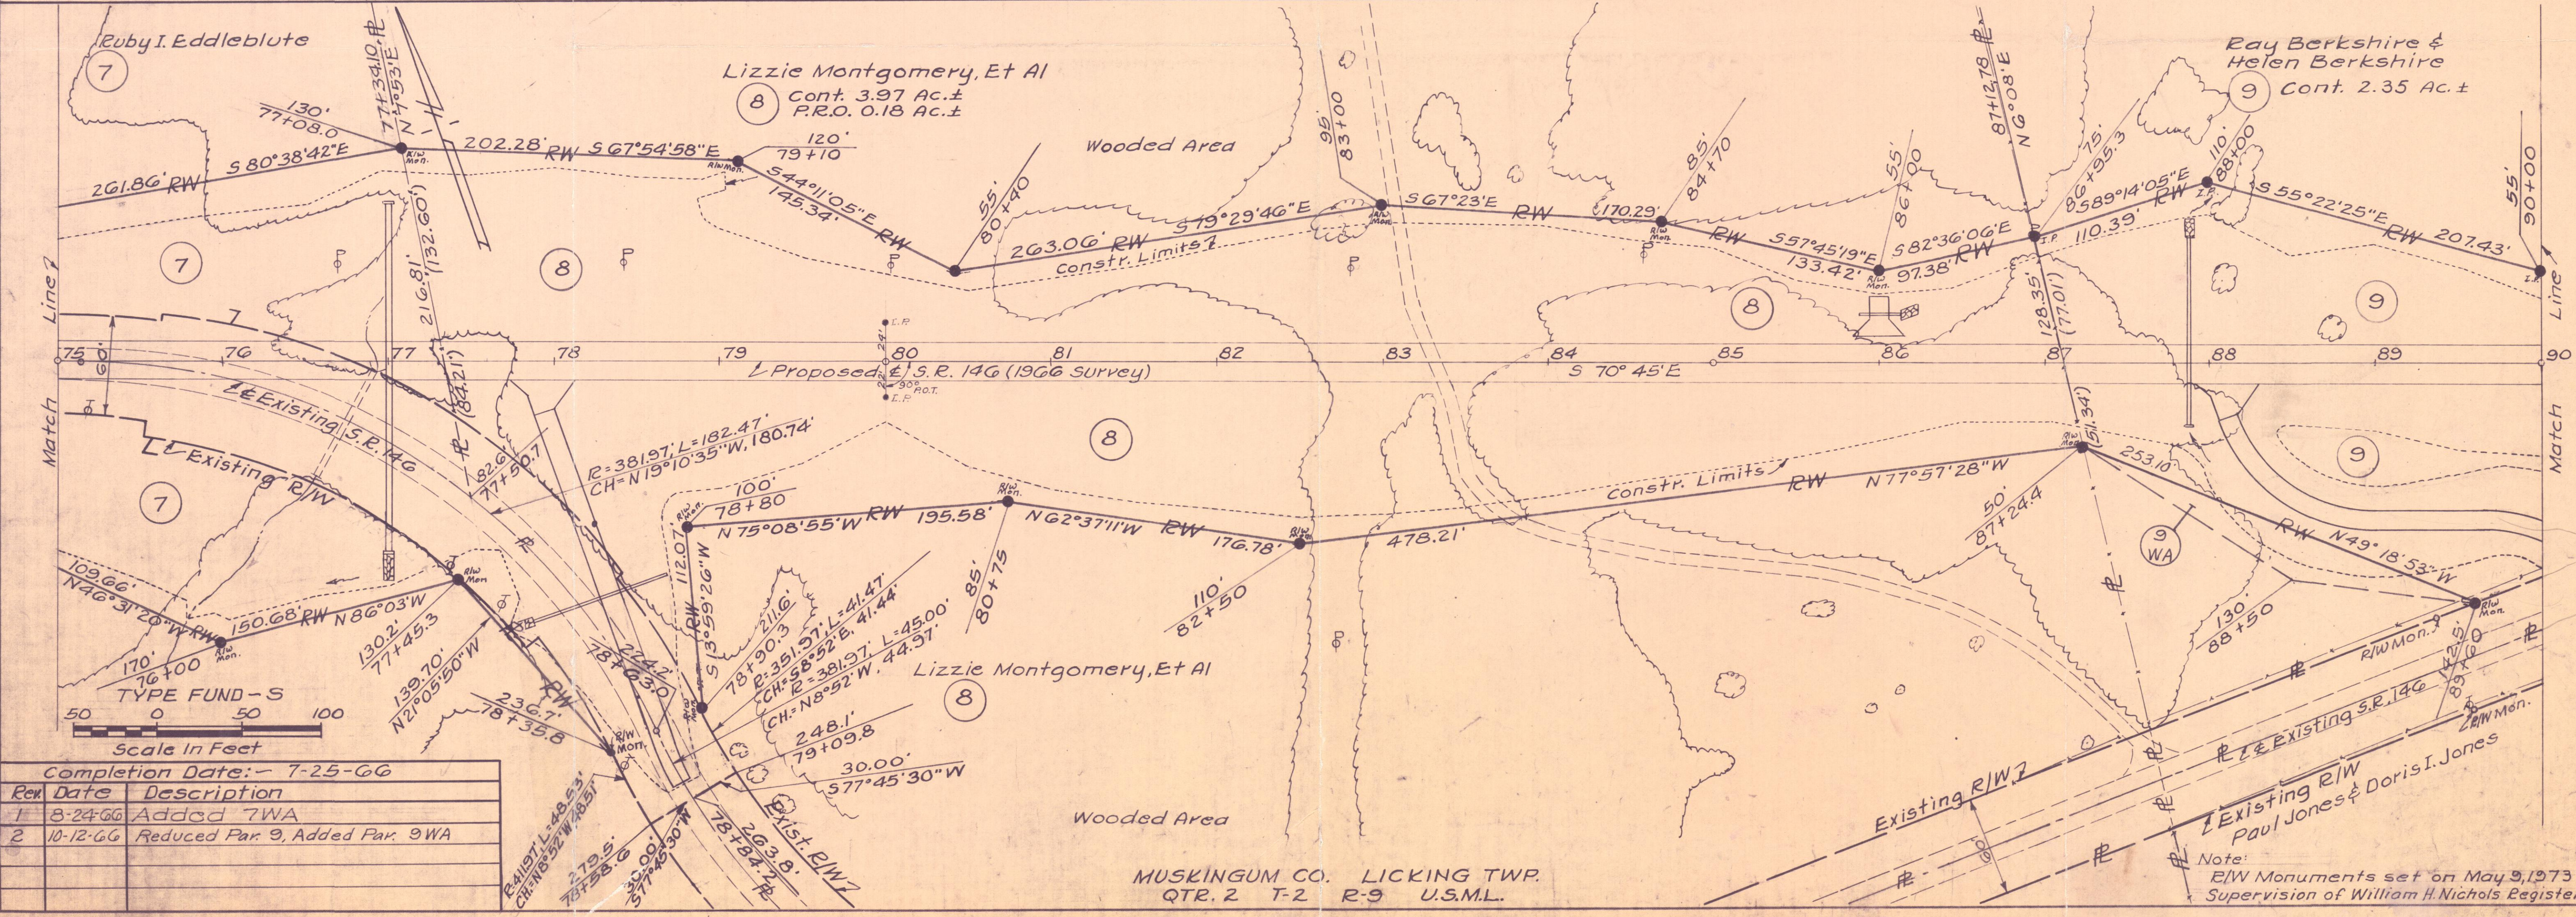


Harold I. Burrier & Esther M. Burrier
 Cont. 1.77 Ac. ±
 P.R.O. 1.35 Ac. ±

FED. RD. DIVISION	STATE	PROJECT
2	OHIO	S-703(3)

MUS-146-0.72
 R/W PLAN

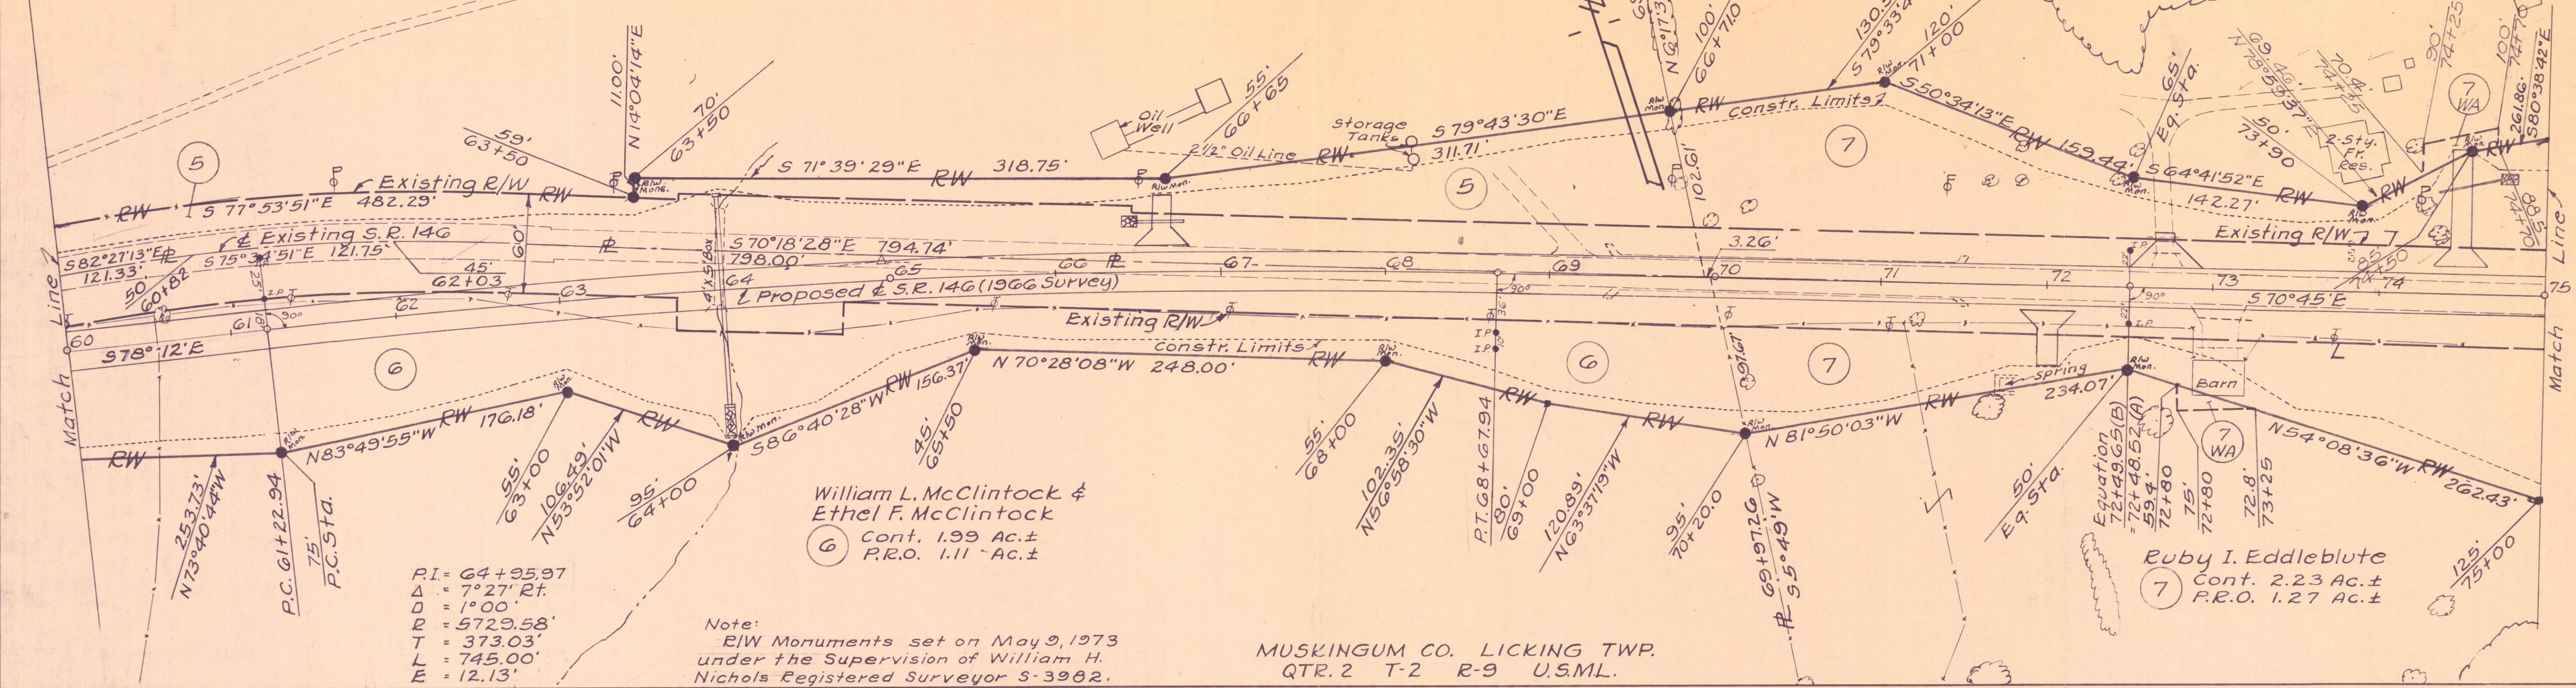

Scale in Feet

Rev	Date	Description
1	8-24-66	Added 7WA
2	10-12-66	Reduced Par. 9, Added Par. 9WA

Completion Date: 7-25-66