


FINAL SURVEY
DATE WHEN MADE
BY

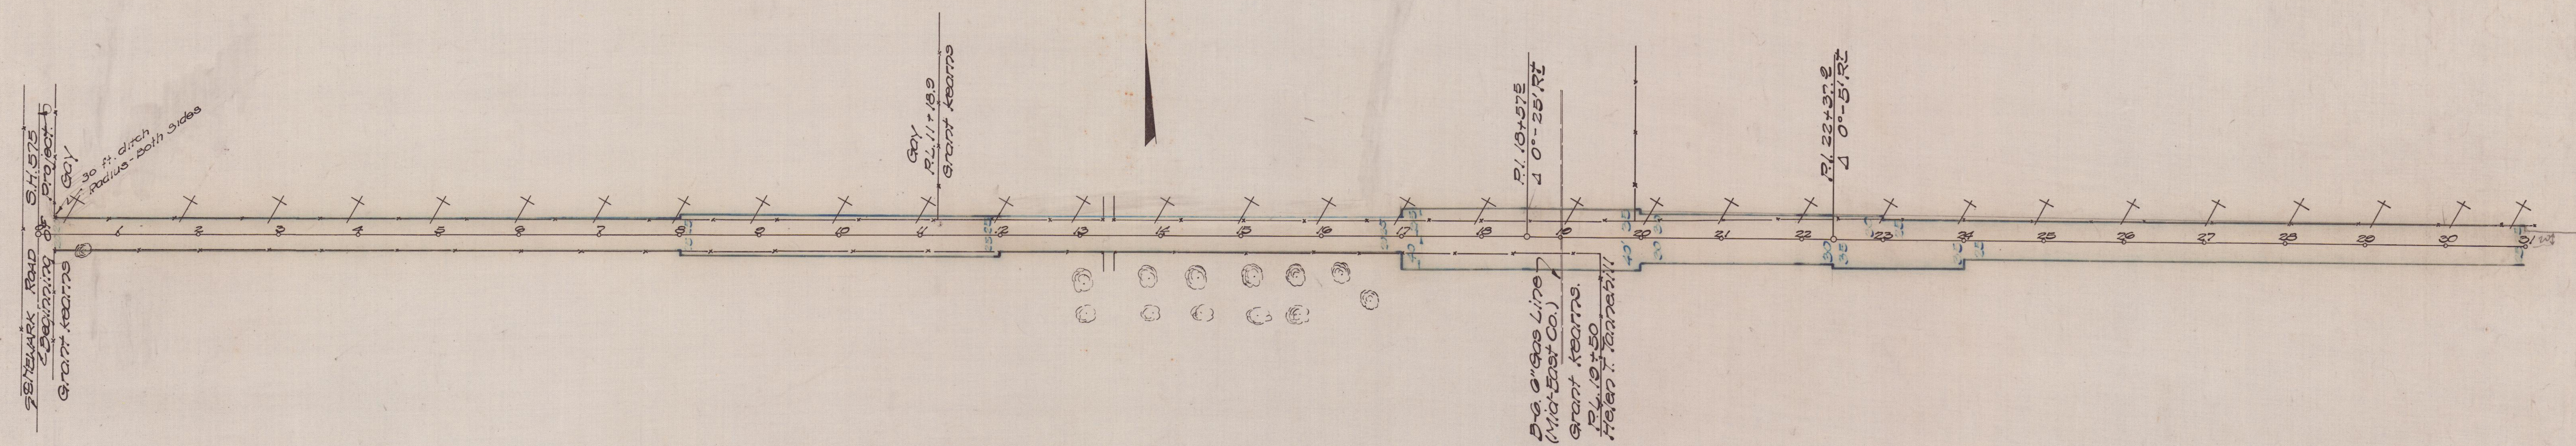

State Hwy. S.M. No. 33. 50' L. in 4" picture
Sta. 5+4+40 (State Survey S.H. 575.
Elevation 717.13.

S.M. No. 3. Spike in twin ticky
Rt. 9 Sta. 13+75. Elev. 825.99

S.M. No. 3. 2 horizontal spikes in T.P.
15' L. Sta. 23+50. Elev. 816.18.

