
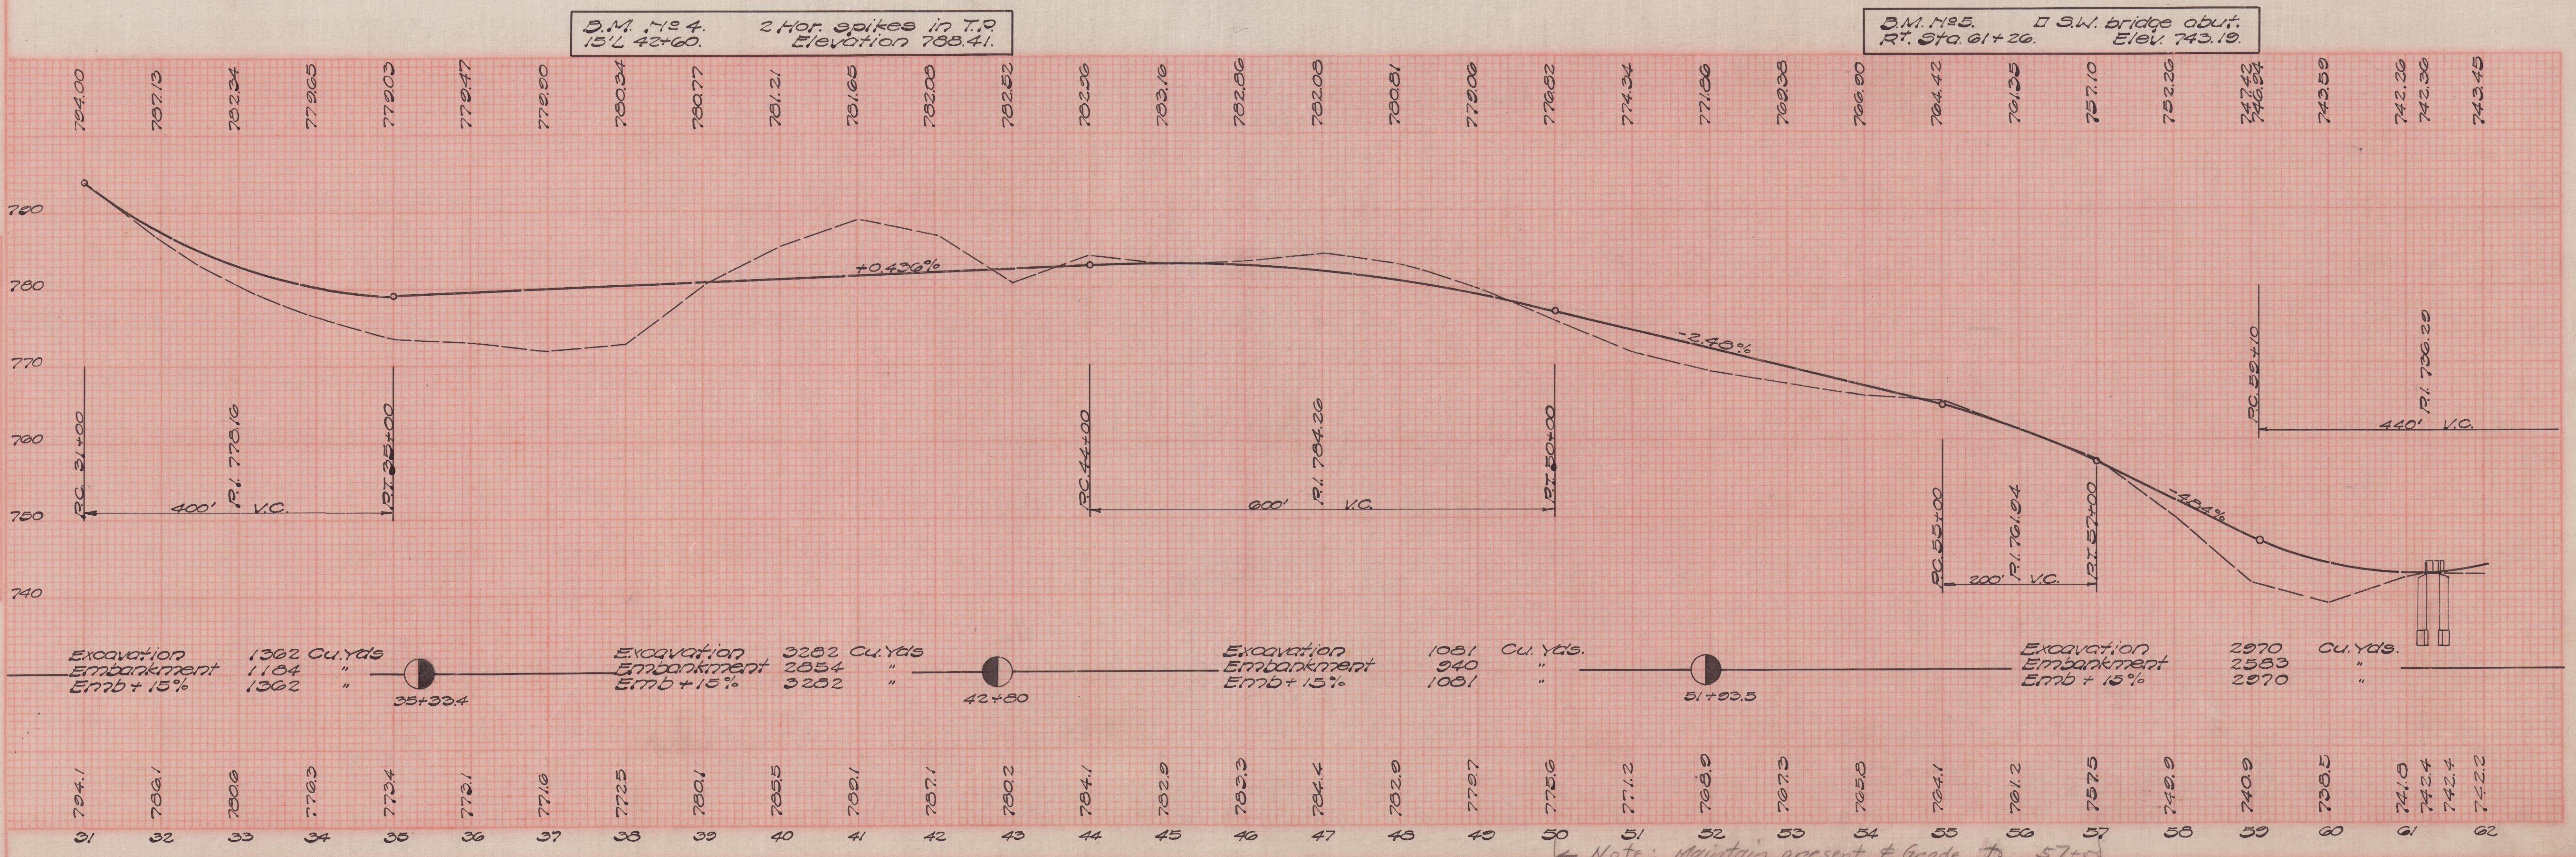


County Road No. 146
Falls Township
Muskingum County.

PLAN
SHEET NO. 4
DATE
BY
CHECKED
NOTED
BY

PROFILE
SHEET NO. 4
DATE
BY
CHECKED
NOTED
BY

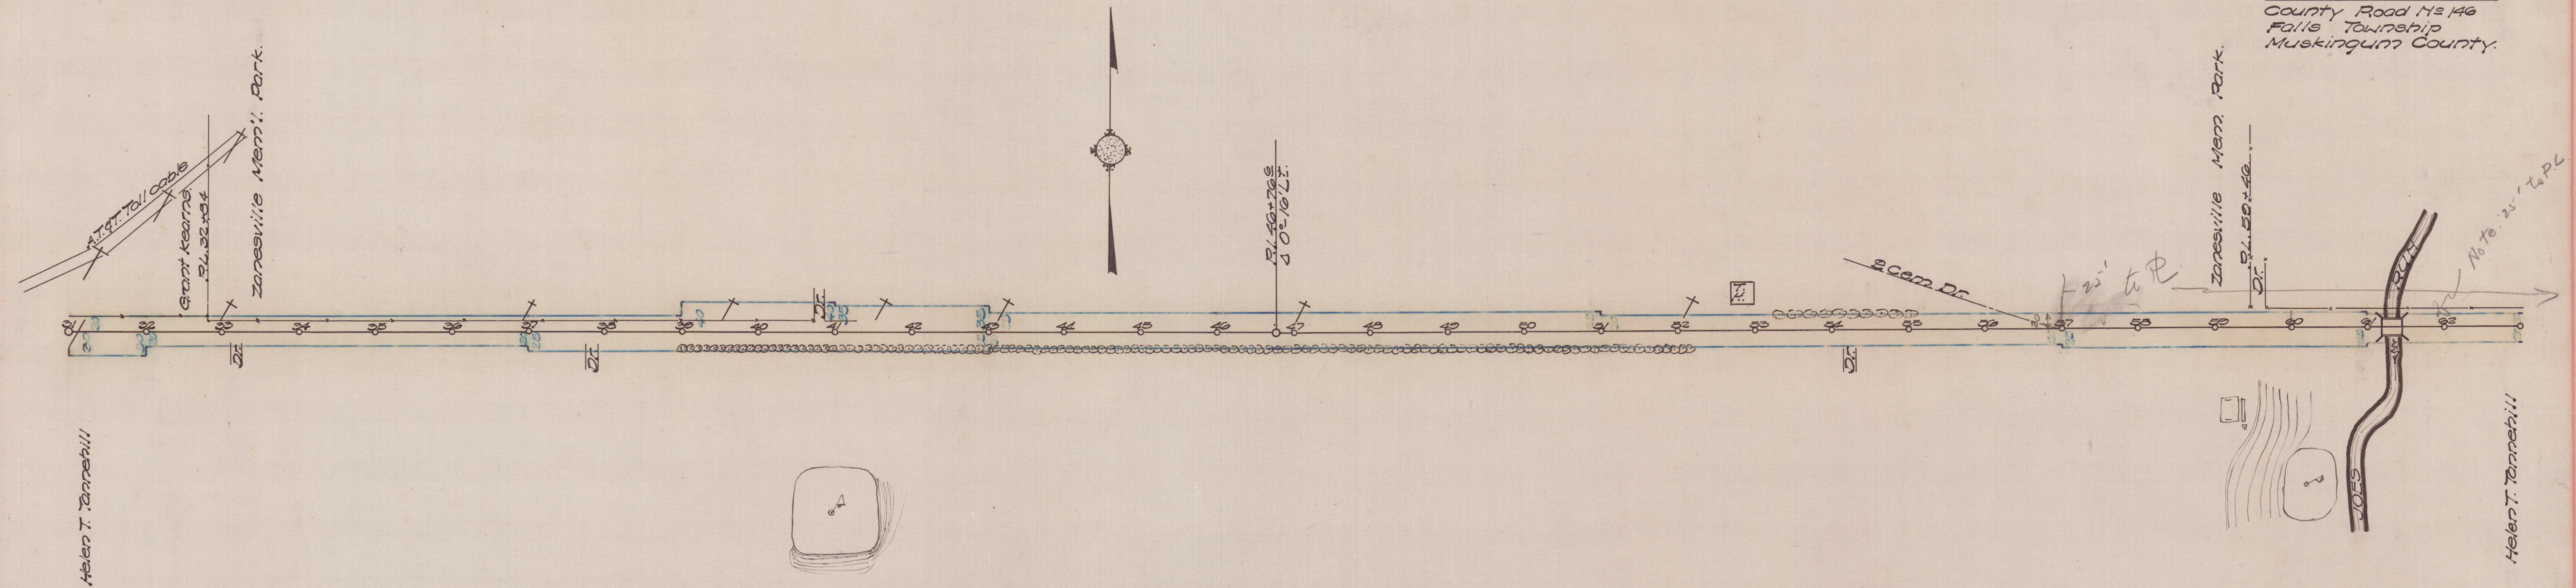

Note: Maintain present E. Grade to 57+00