



County Road 146
Falls Township
Muskingum Co.

PLAN
SURVEYED
PLATTED
DATE 8/20/00
BY J. H. COLE, JR.
CHECKED
DATE 8/20/00
BY J. H. COLE, JR.

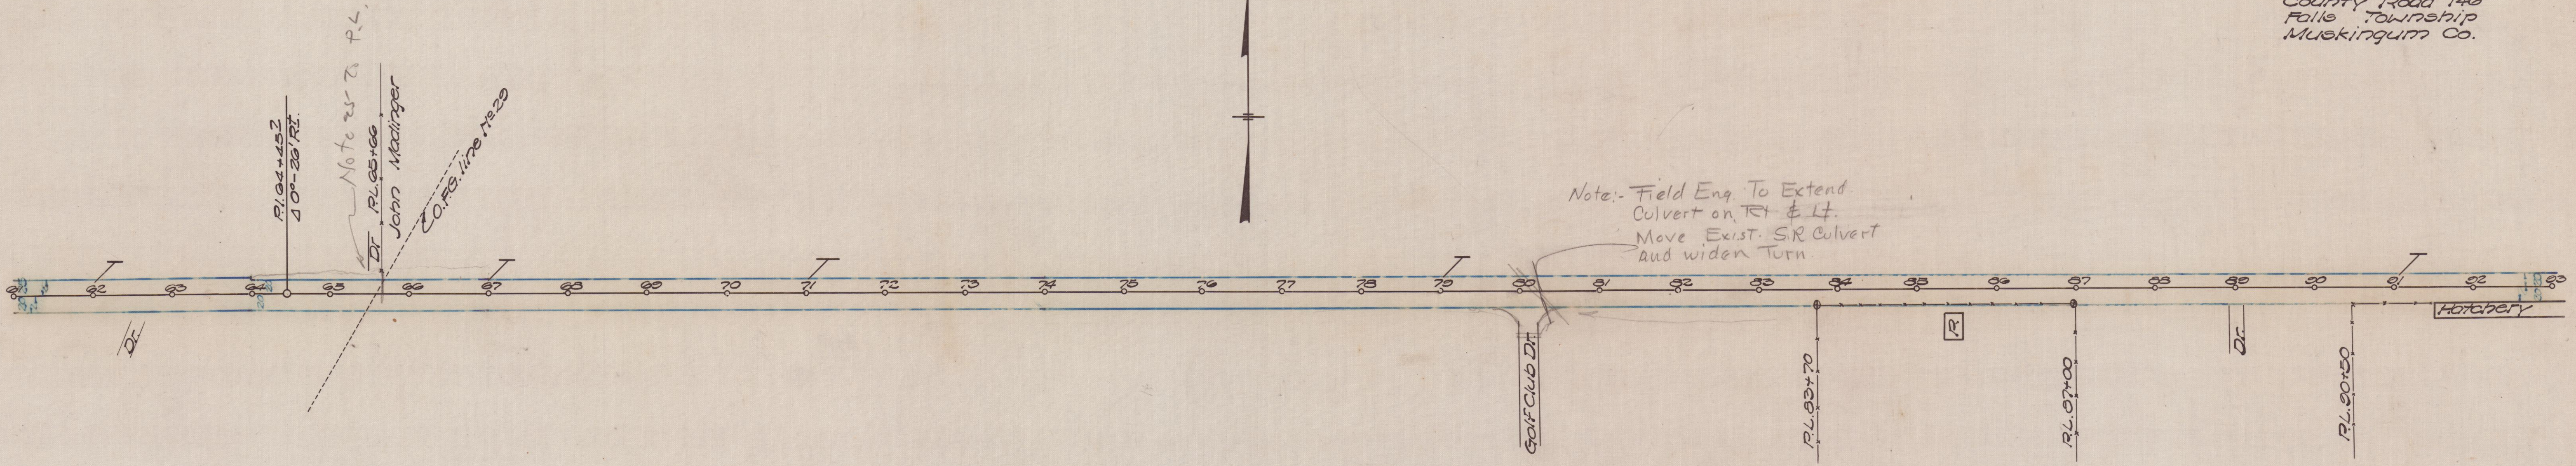

PROFILE
SURVEYED
PLATTED
DATE 8/20/00
BY J. H. COLE, JR.
CHECKED
DATE 8/20/00
BY J. H. COLE, JR.

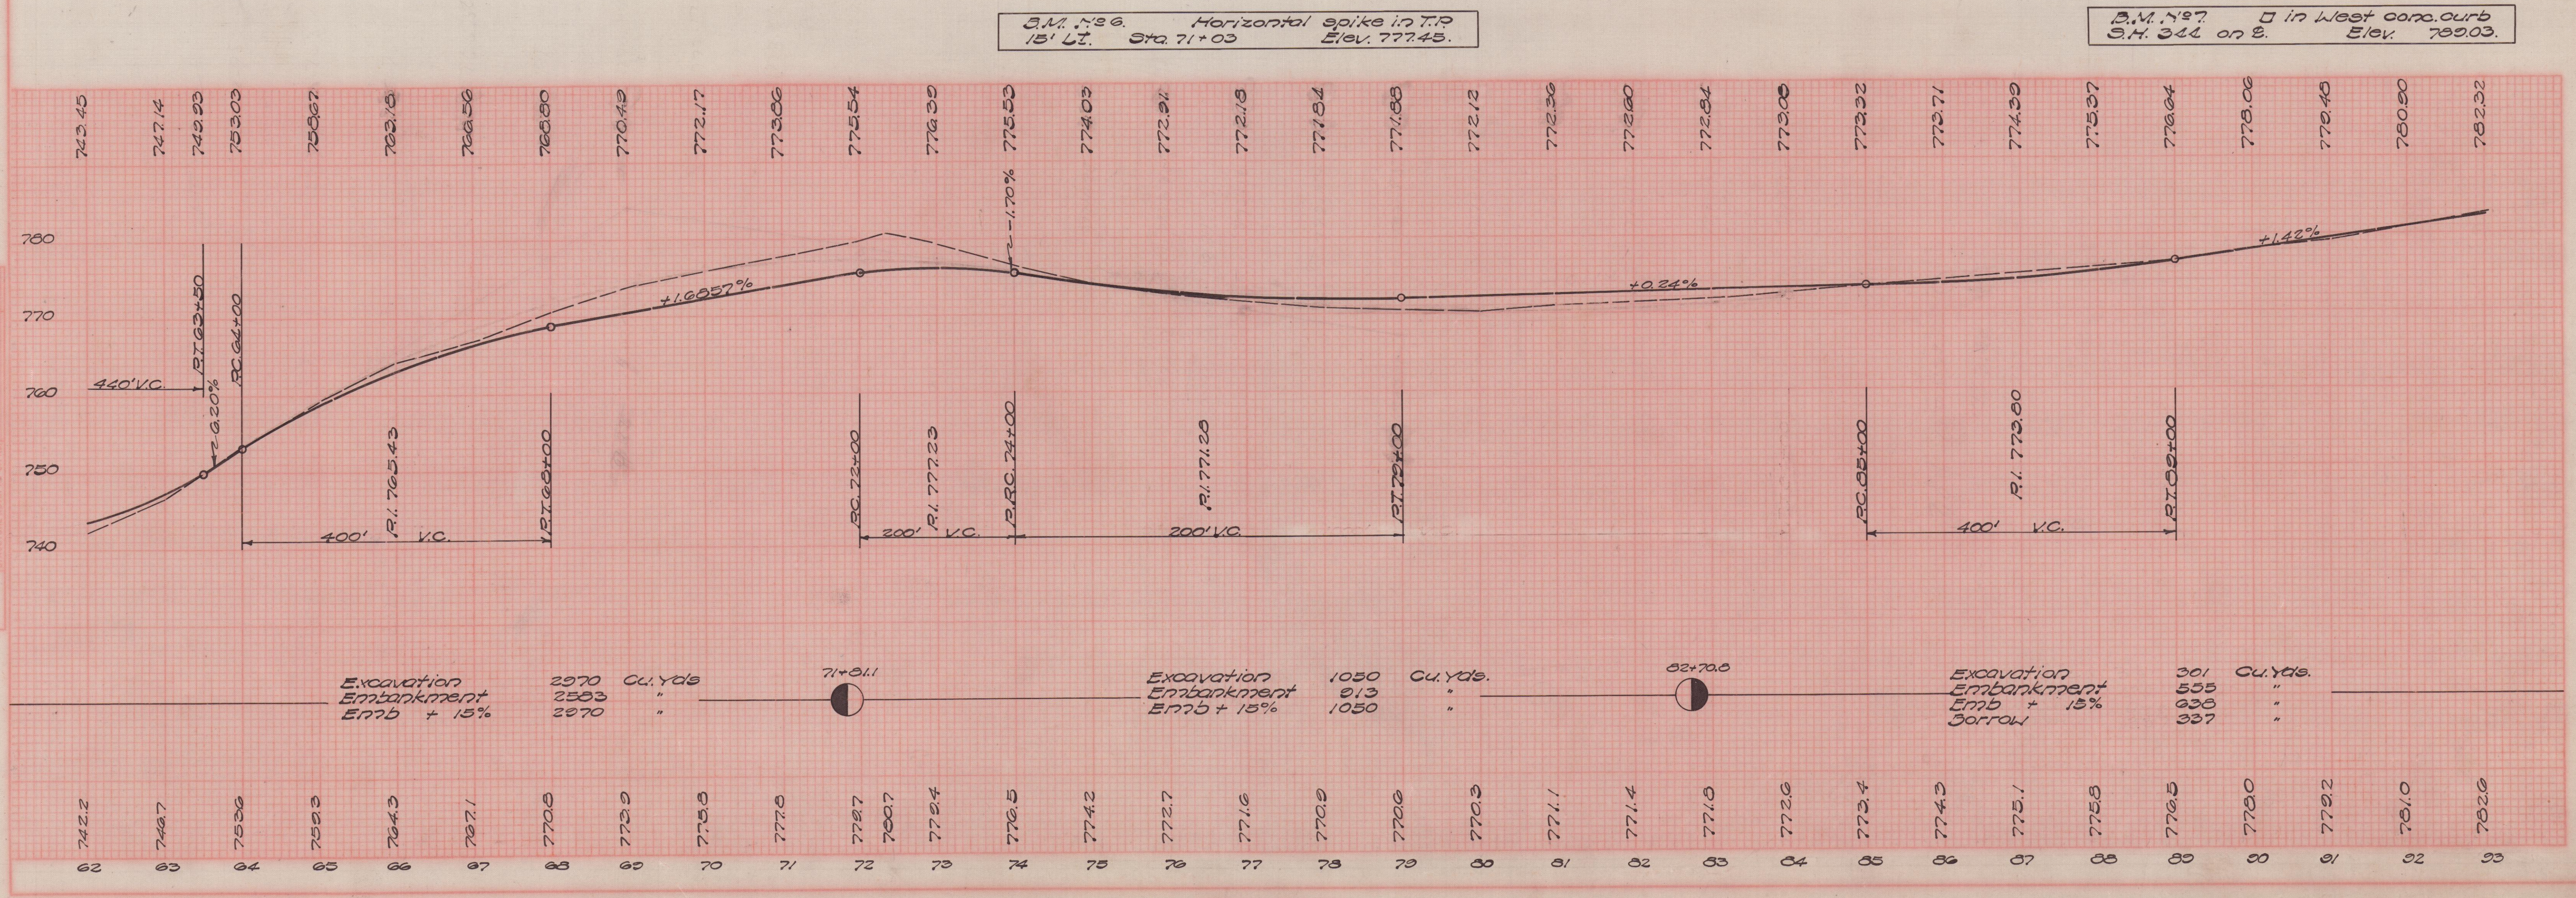

Excavation
Embankment
Emb + 15%
2970 Cu. Yds
2583
2970

Excavation
Embankment
Emb + 15%
1050 Cu. Yds.
913
1050

Excavation
Embankment
Emb + 15%
301 Cu. Yds.
555
337