

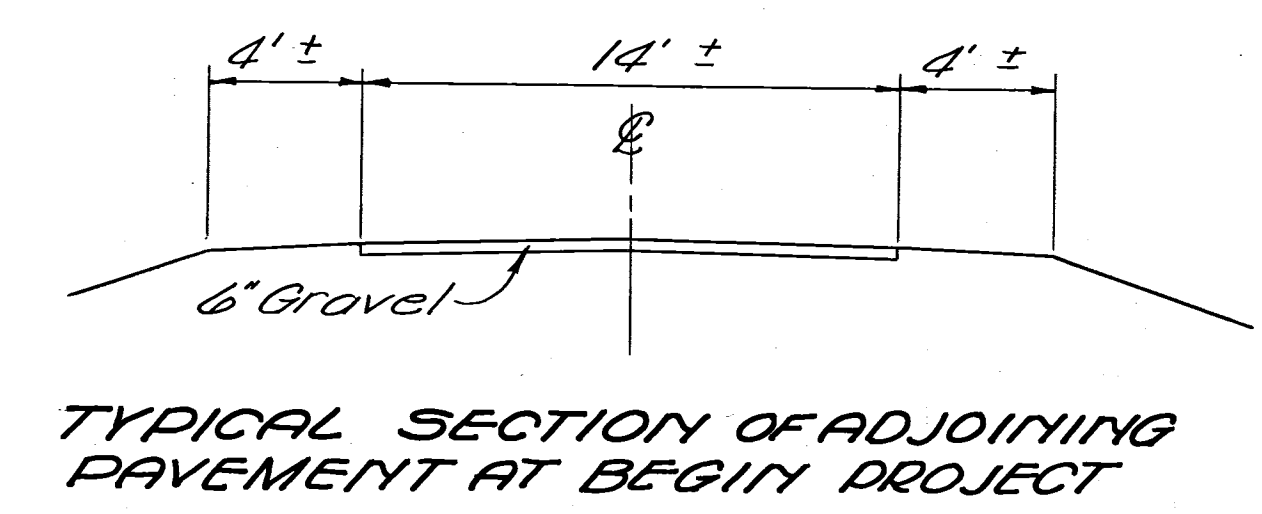


**MUSKINGUM COUNTY
 COUNTY ROAD NO. 8**

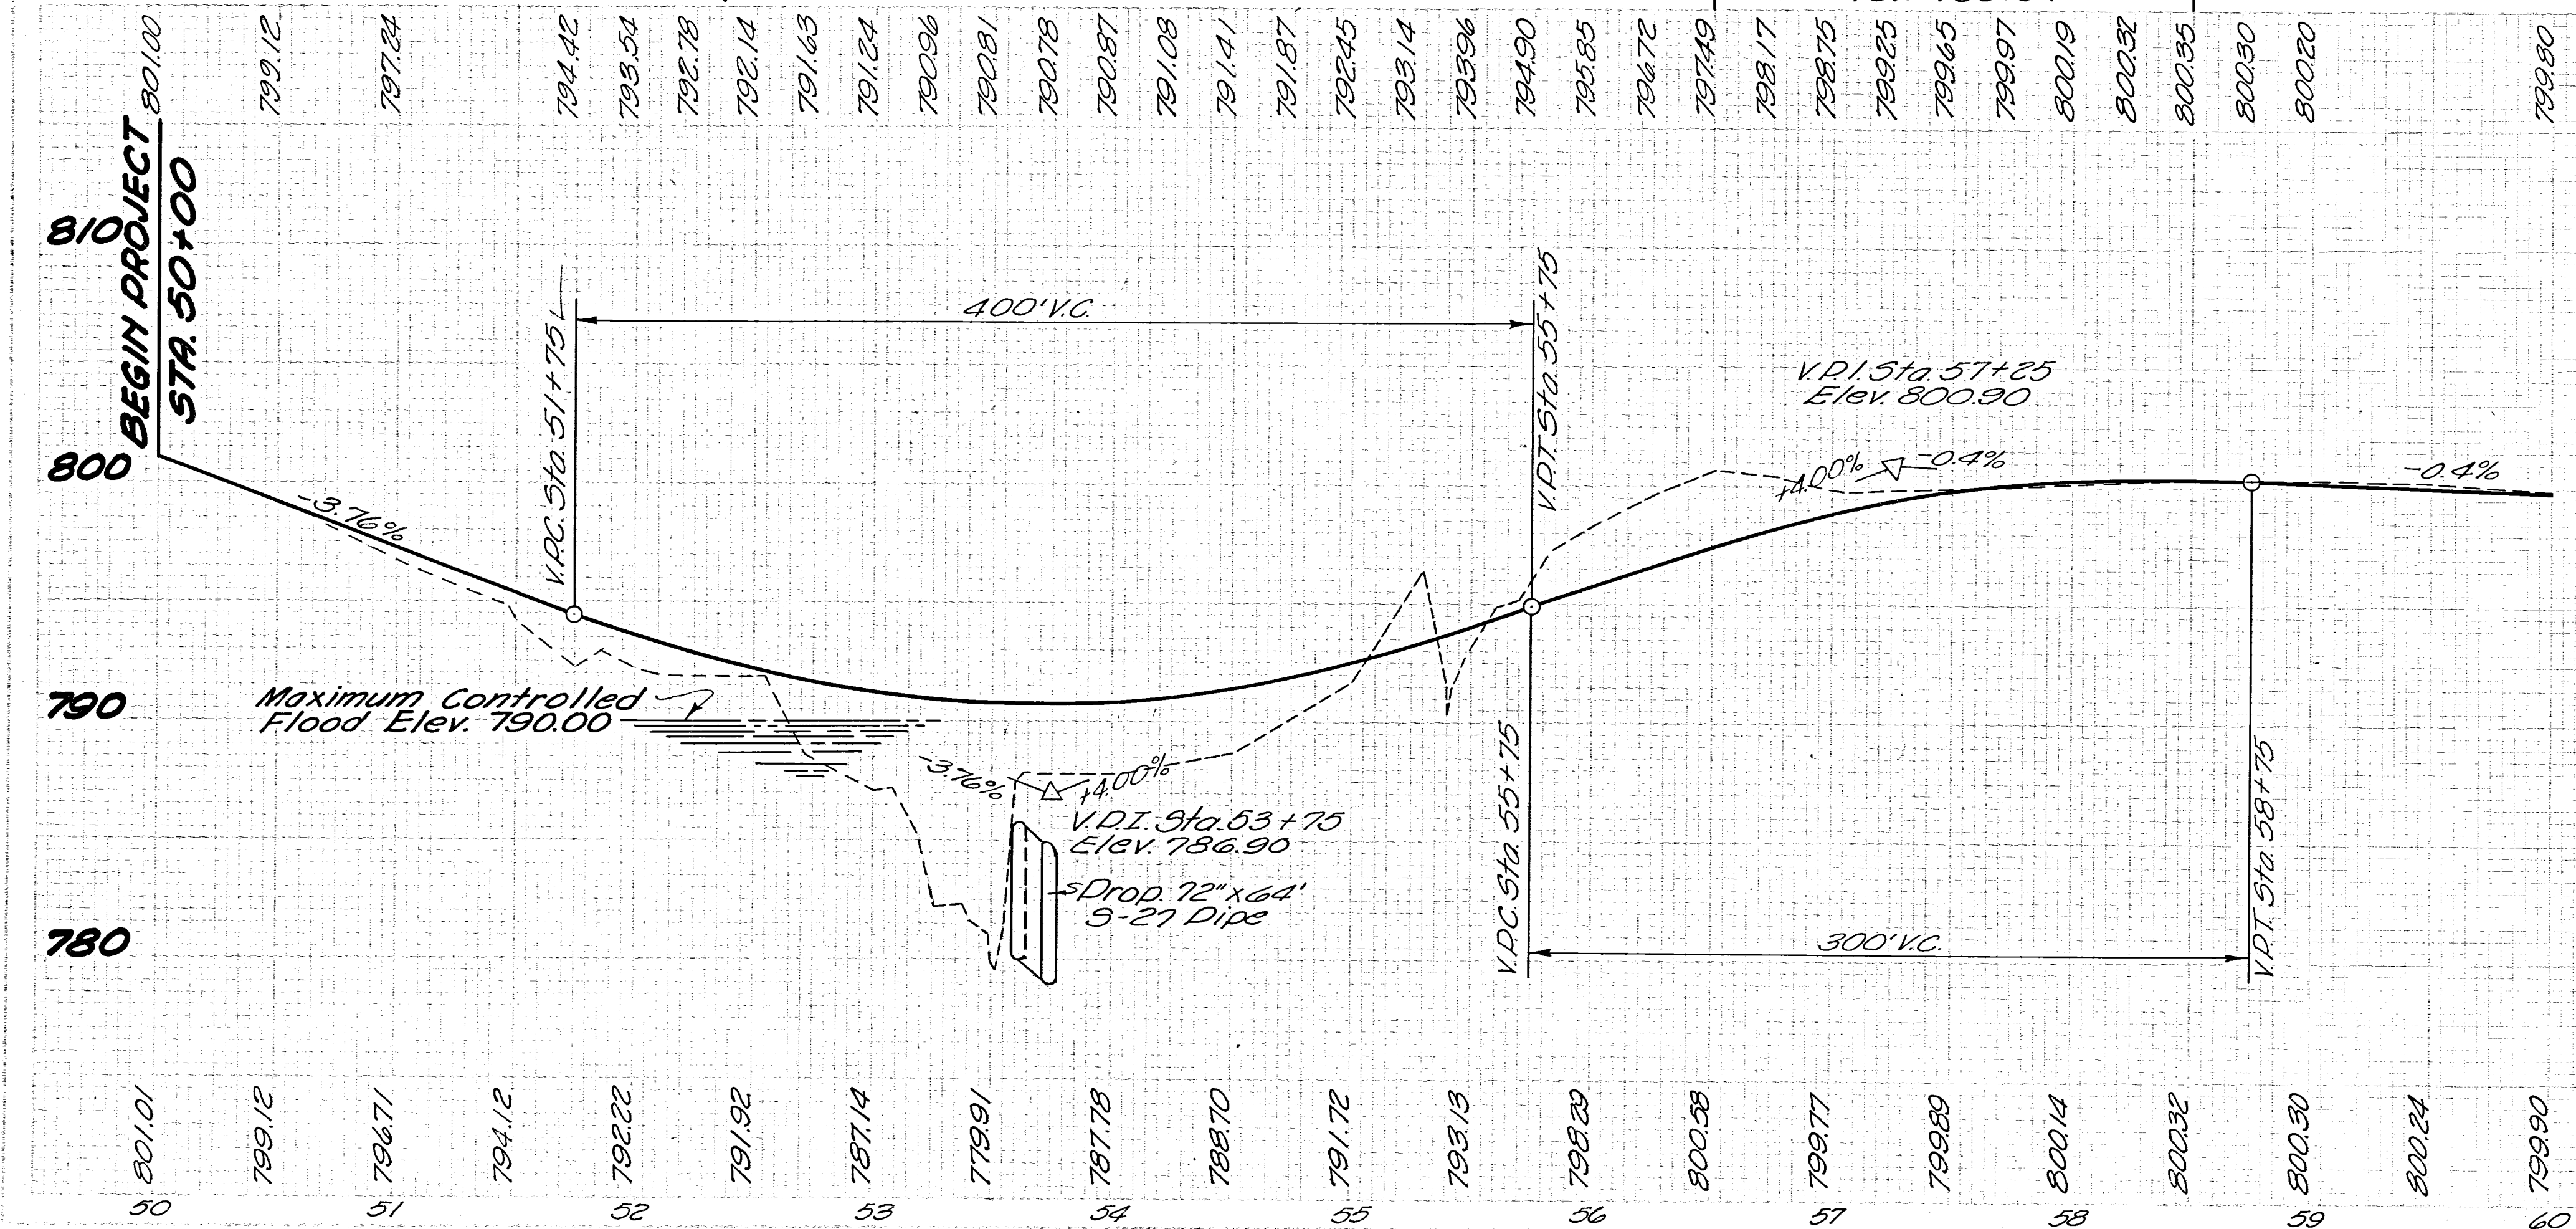

Reference Number	Station to Station	Side	QUANTITIES						
			E-12	I-15	I-18	3-84	Special	Special	I-1
			Pipe Removed	12" x 15" Wire Cable Type (2 Cable)	12" x 15" Wire Cable Type (2 Cable)	Removal of Existing Structures	Relocating Existing Telephone Lines	Relocating Existing Power Lines	Pipe for Driveways
			8" 10" 12" 15" Lin. Ft.	Lin. Ft.	Cu. Yd.	Lump	Lump	Lump	12" 24" Lin. Ft.
1-R	50+10	Lt.							
2-R	50+10	Lt.	15						
3-R	50+10 to 52+15.5	Rt.					Lump		
4-R	53+62.5	Rt.						Lump	
5-R	52+09.9 to 53+85.9	Rt.		176					
6-R	53+20 to 54+16	Lt.		96					
7-R	54+75	Lt.			9.59				
8-R	54+79.5	Rt.	13						
9-R	55+62.76	Lt.		305					
10-R	57+62.50	Lt.	19.5						
11-R	52+82	Rt.				Lump			
12-R	53+63	Rt.						Lump	
1-D	50+10	Lt.							32
2-D	54+75	Lt.							36
①	See Sheet No. 62								
②	See Sheet No. 63								
TOTALS			15 19.5 13 305	272	20.57	Lump	Lump	Lump	32 36

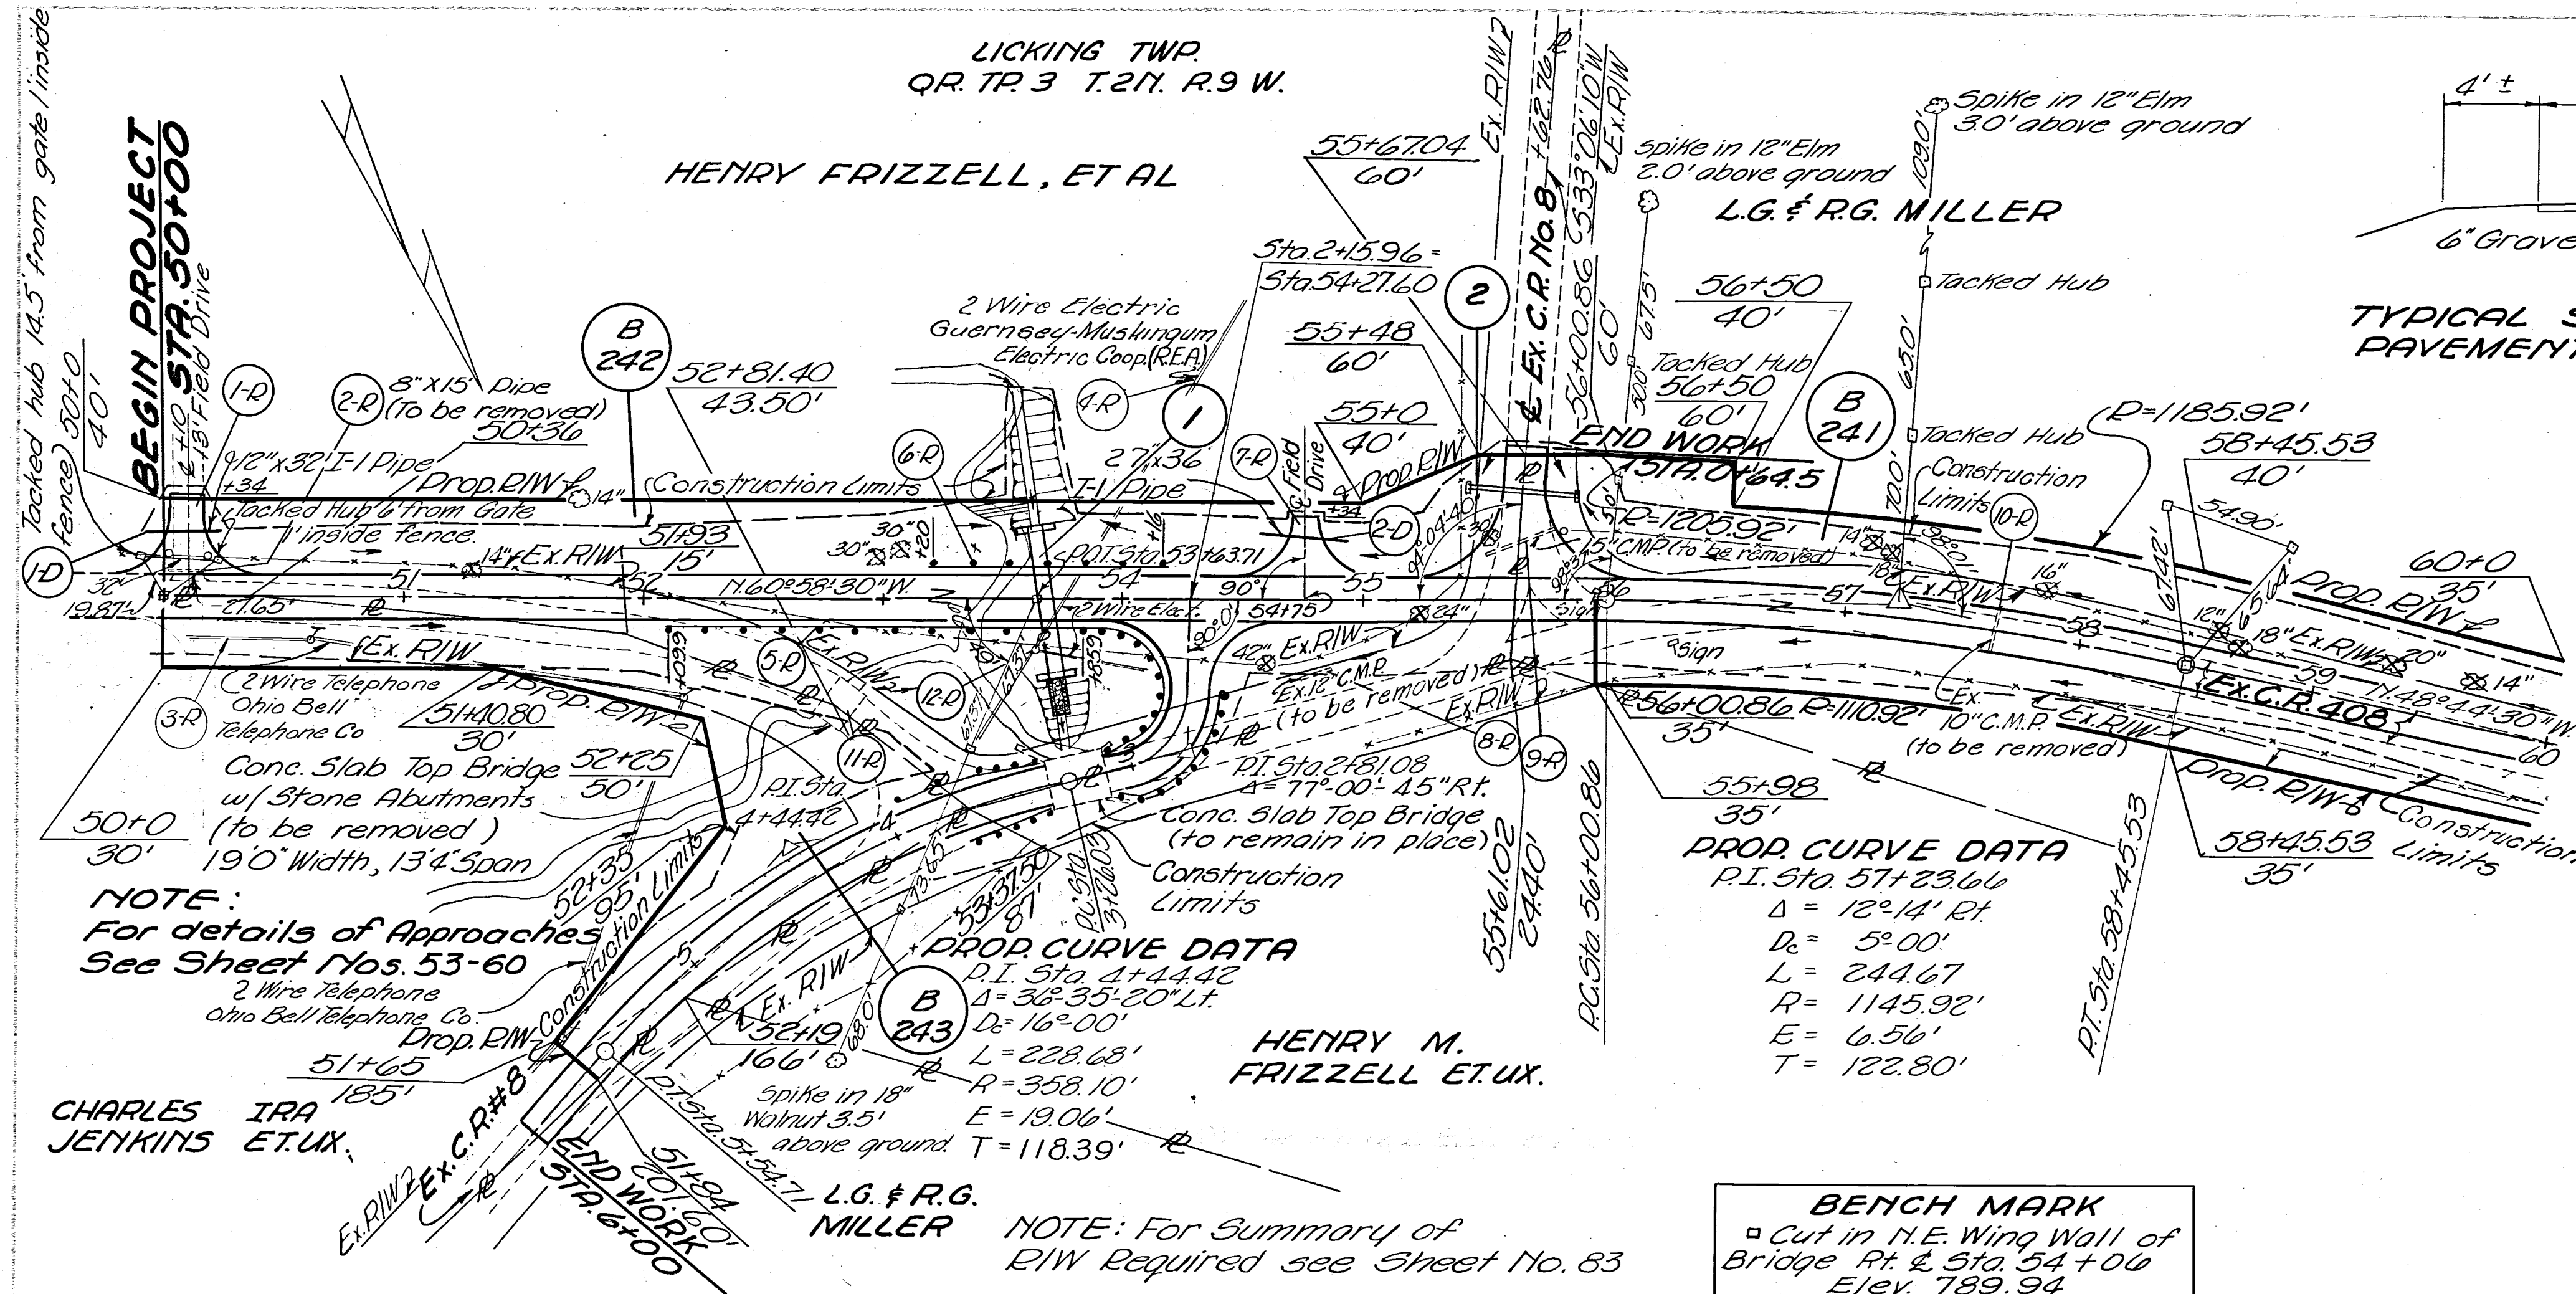

REVISION	DATE	DESCRIPTION	BY
3/23/62	AS	CONSTRUCTED	H.F.K.
U. S. ARMY ENGINEER DISTRICT, HUNTINGTON CORPS OF ENGINEERS HUNTINGTON, W. VA.			
DRAWN BY: WIC		LICKING RIVER DILLON RESERVOIR PROJECT	
CHECKED BY: F.H.S.		RELOCATION OF MUSKINGUM COUNTY ROAD NO. 8 MC-8-4 & MT-408-1 MC-8-1 & MC-408-1	
SUBMITTED BY: Elmer S. Barrett		APPROVED: Steven Malovich	
RECOMMENDED: James J. Barrett		DATE: NOVEMBER 1959	
CHIEF ENG. DIV.		COL. C.E. DISTRICT ENGINEER	
ELMER S. BARRETT ASSOCIATES CONSULTING ENGINEERS CHILLICOTHE, OHIO		SCALE: HORIZ. 1"=50' VERT. 1"=5' SPEC. NO. DRAWING NUMBER 0271-UD14-68/ 9 SHEET 9 OF 83	