


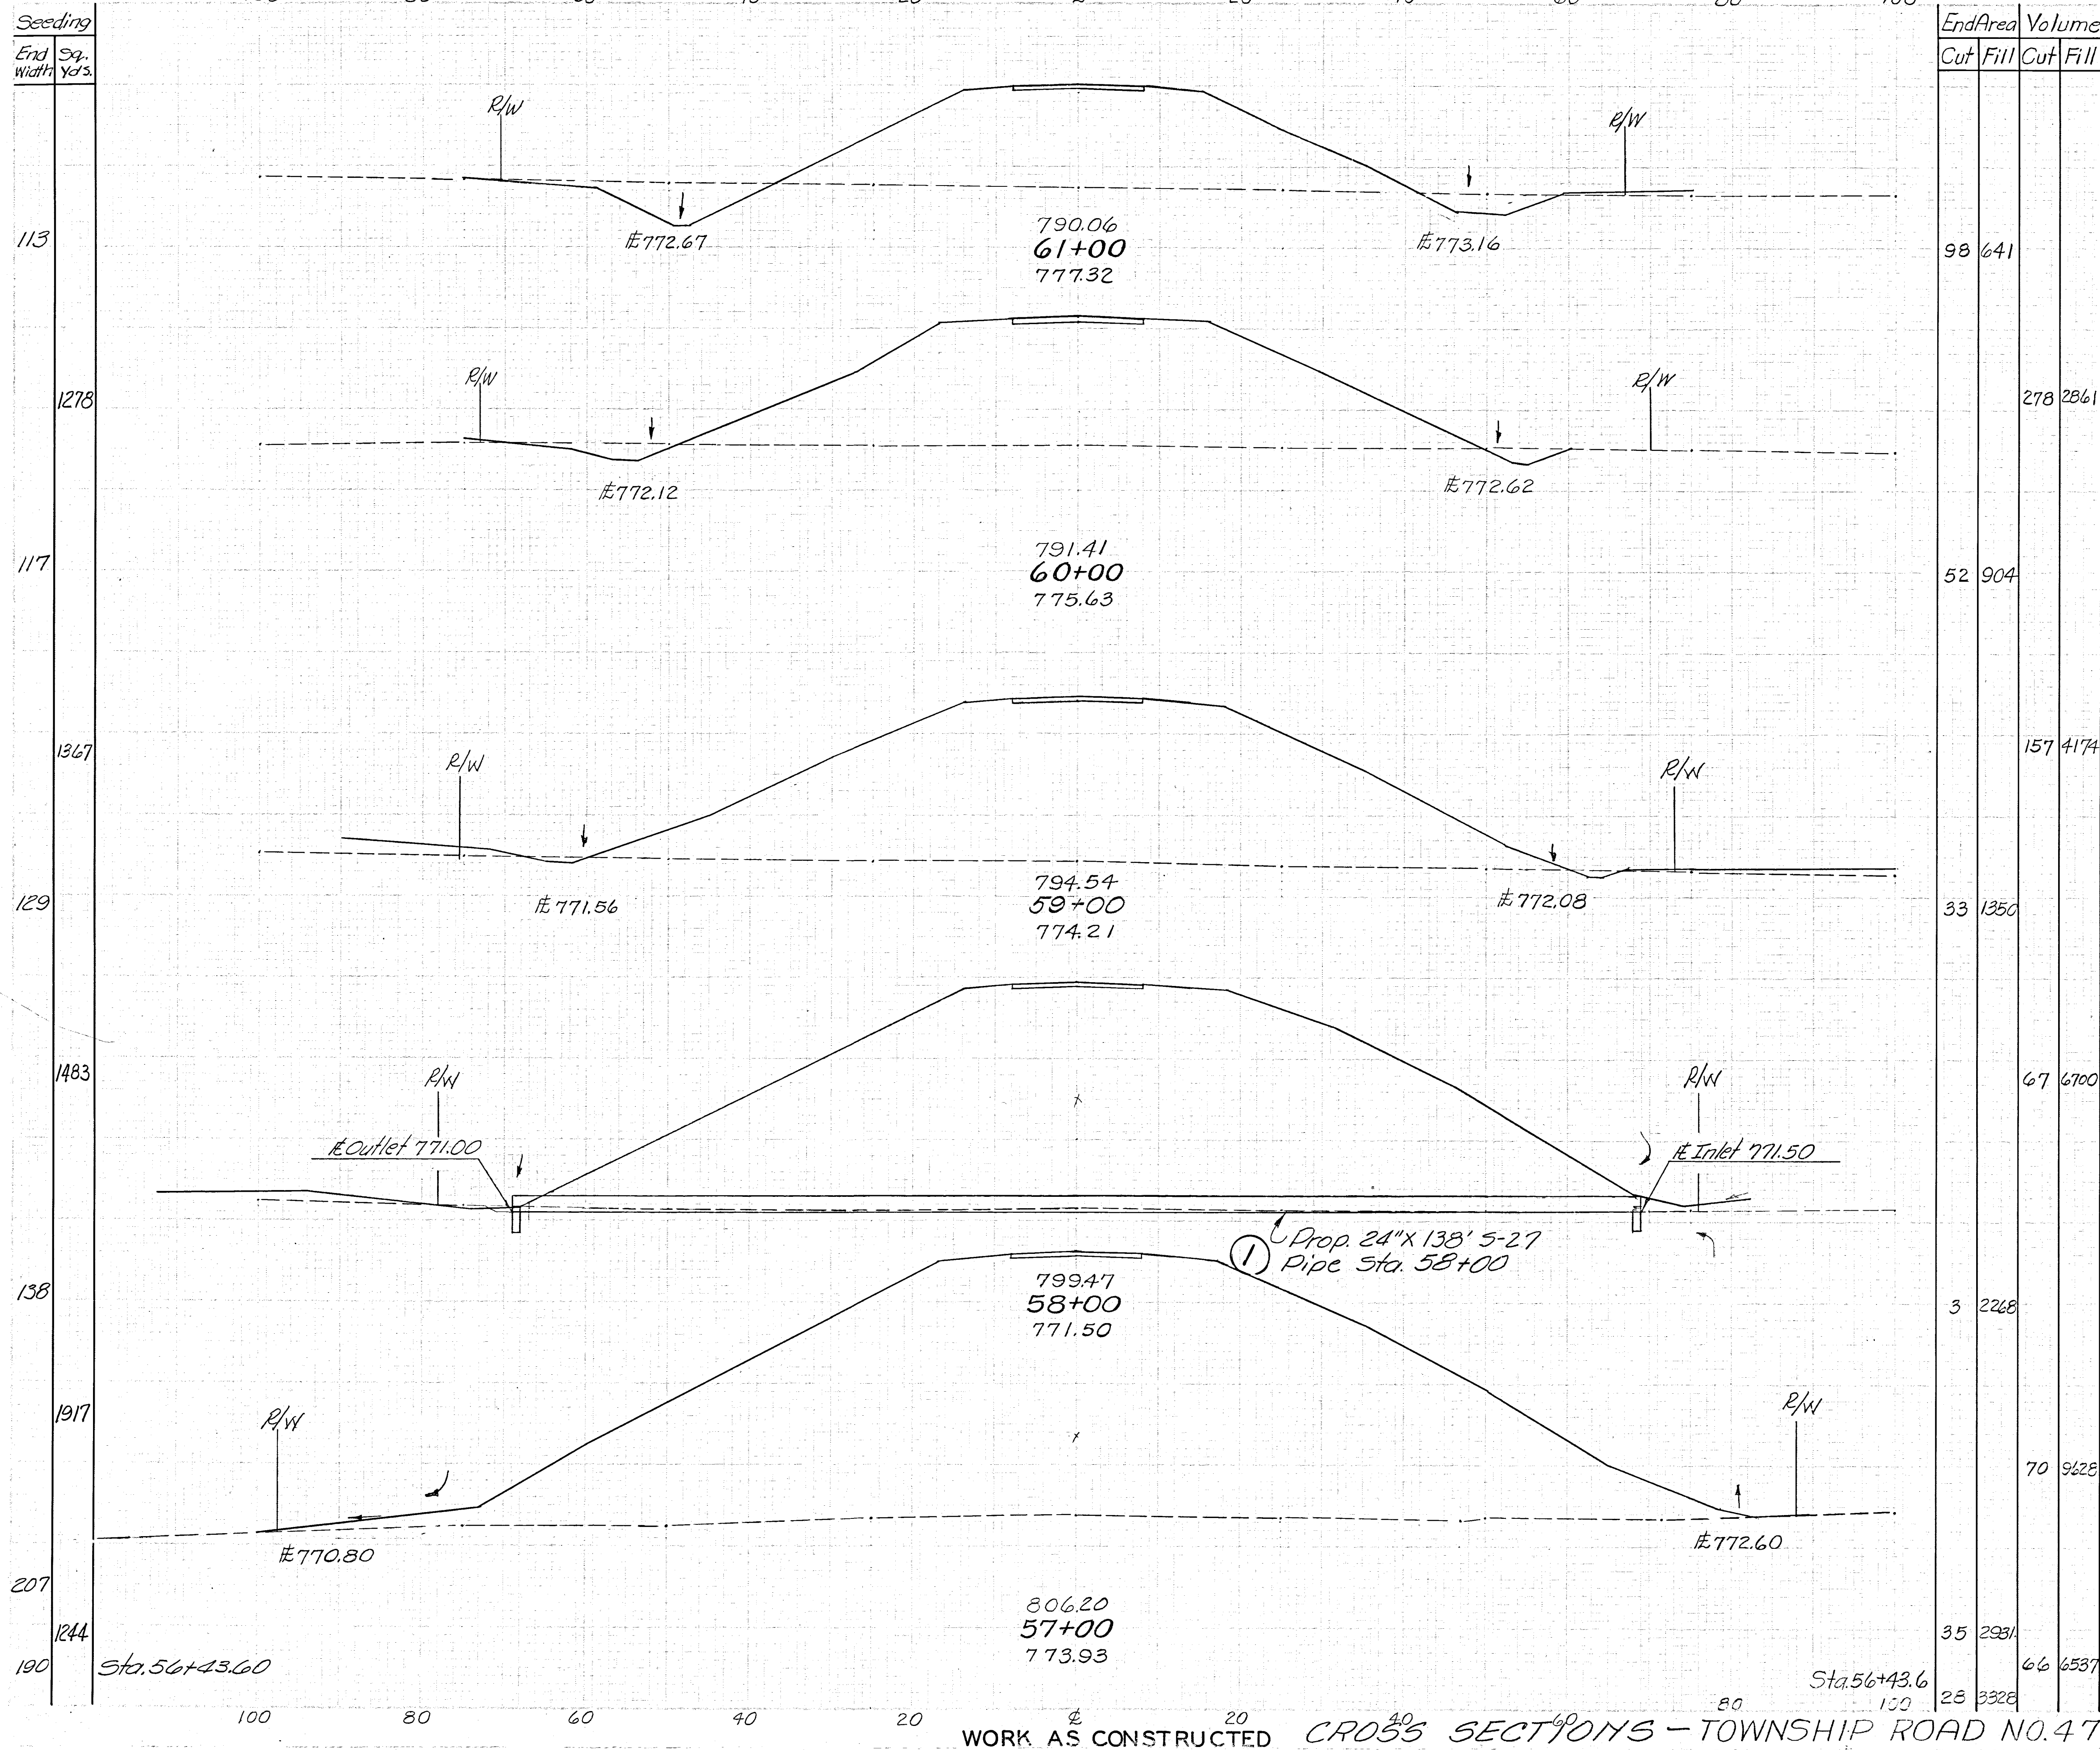

End Area		Volume	
Cut	Fill	Cut	Fill
98	641		
	278	2861	
52	904		
	157	4174	
33	1350		
	67	6700	
3	2268		
	70	9628	
35	2931		
	66	6537	
28	3328		

15
26

MUSKINGUM COUNTY
TOWNSHIP ROADS NO. 47 & 60

REVISION	DATE	DESCRIPTION	BY
U. S. ARMY ENGINEER DISTRICT, HUNTINGTON CORPS OF ENGINEERS HUNTINGTON, W. VA.			
DRAWN BY:		LICKING RIVER DILLON RESERVOIR PROJECT RELOCATION OF TOWNSHIP ROAD NO. 47 SECTION I (MT-47-1) READJUSTMENT OF TOWNSHIP ROAD NO. 60 SECTION I (MT-60-1)	
TRACED BY:		DATE: AUGUST 1959	
CHECKED BY: SEW		APPROVED: J. J. [Signature] COL. C. E. DISTRICT ENGINEER	
SUBMITTED BY: [Signature] ELMER S. BARRETT ASSOCIATES		RECOMMENDED: [Signature] CHIEF ENG. DIV.	
ELMER S. BARRETT ASSOCIATES CONSULTING ENGINEERS CHILLICOTHE, OHIO		SCALE: 1" = 10' SPEC. NO. DRAWING NUMBER 027f-UD10-68/15 SHEET 15 OF 26	