


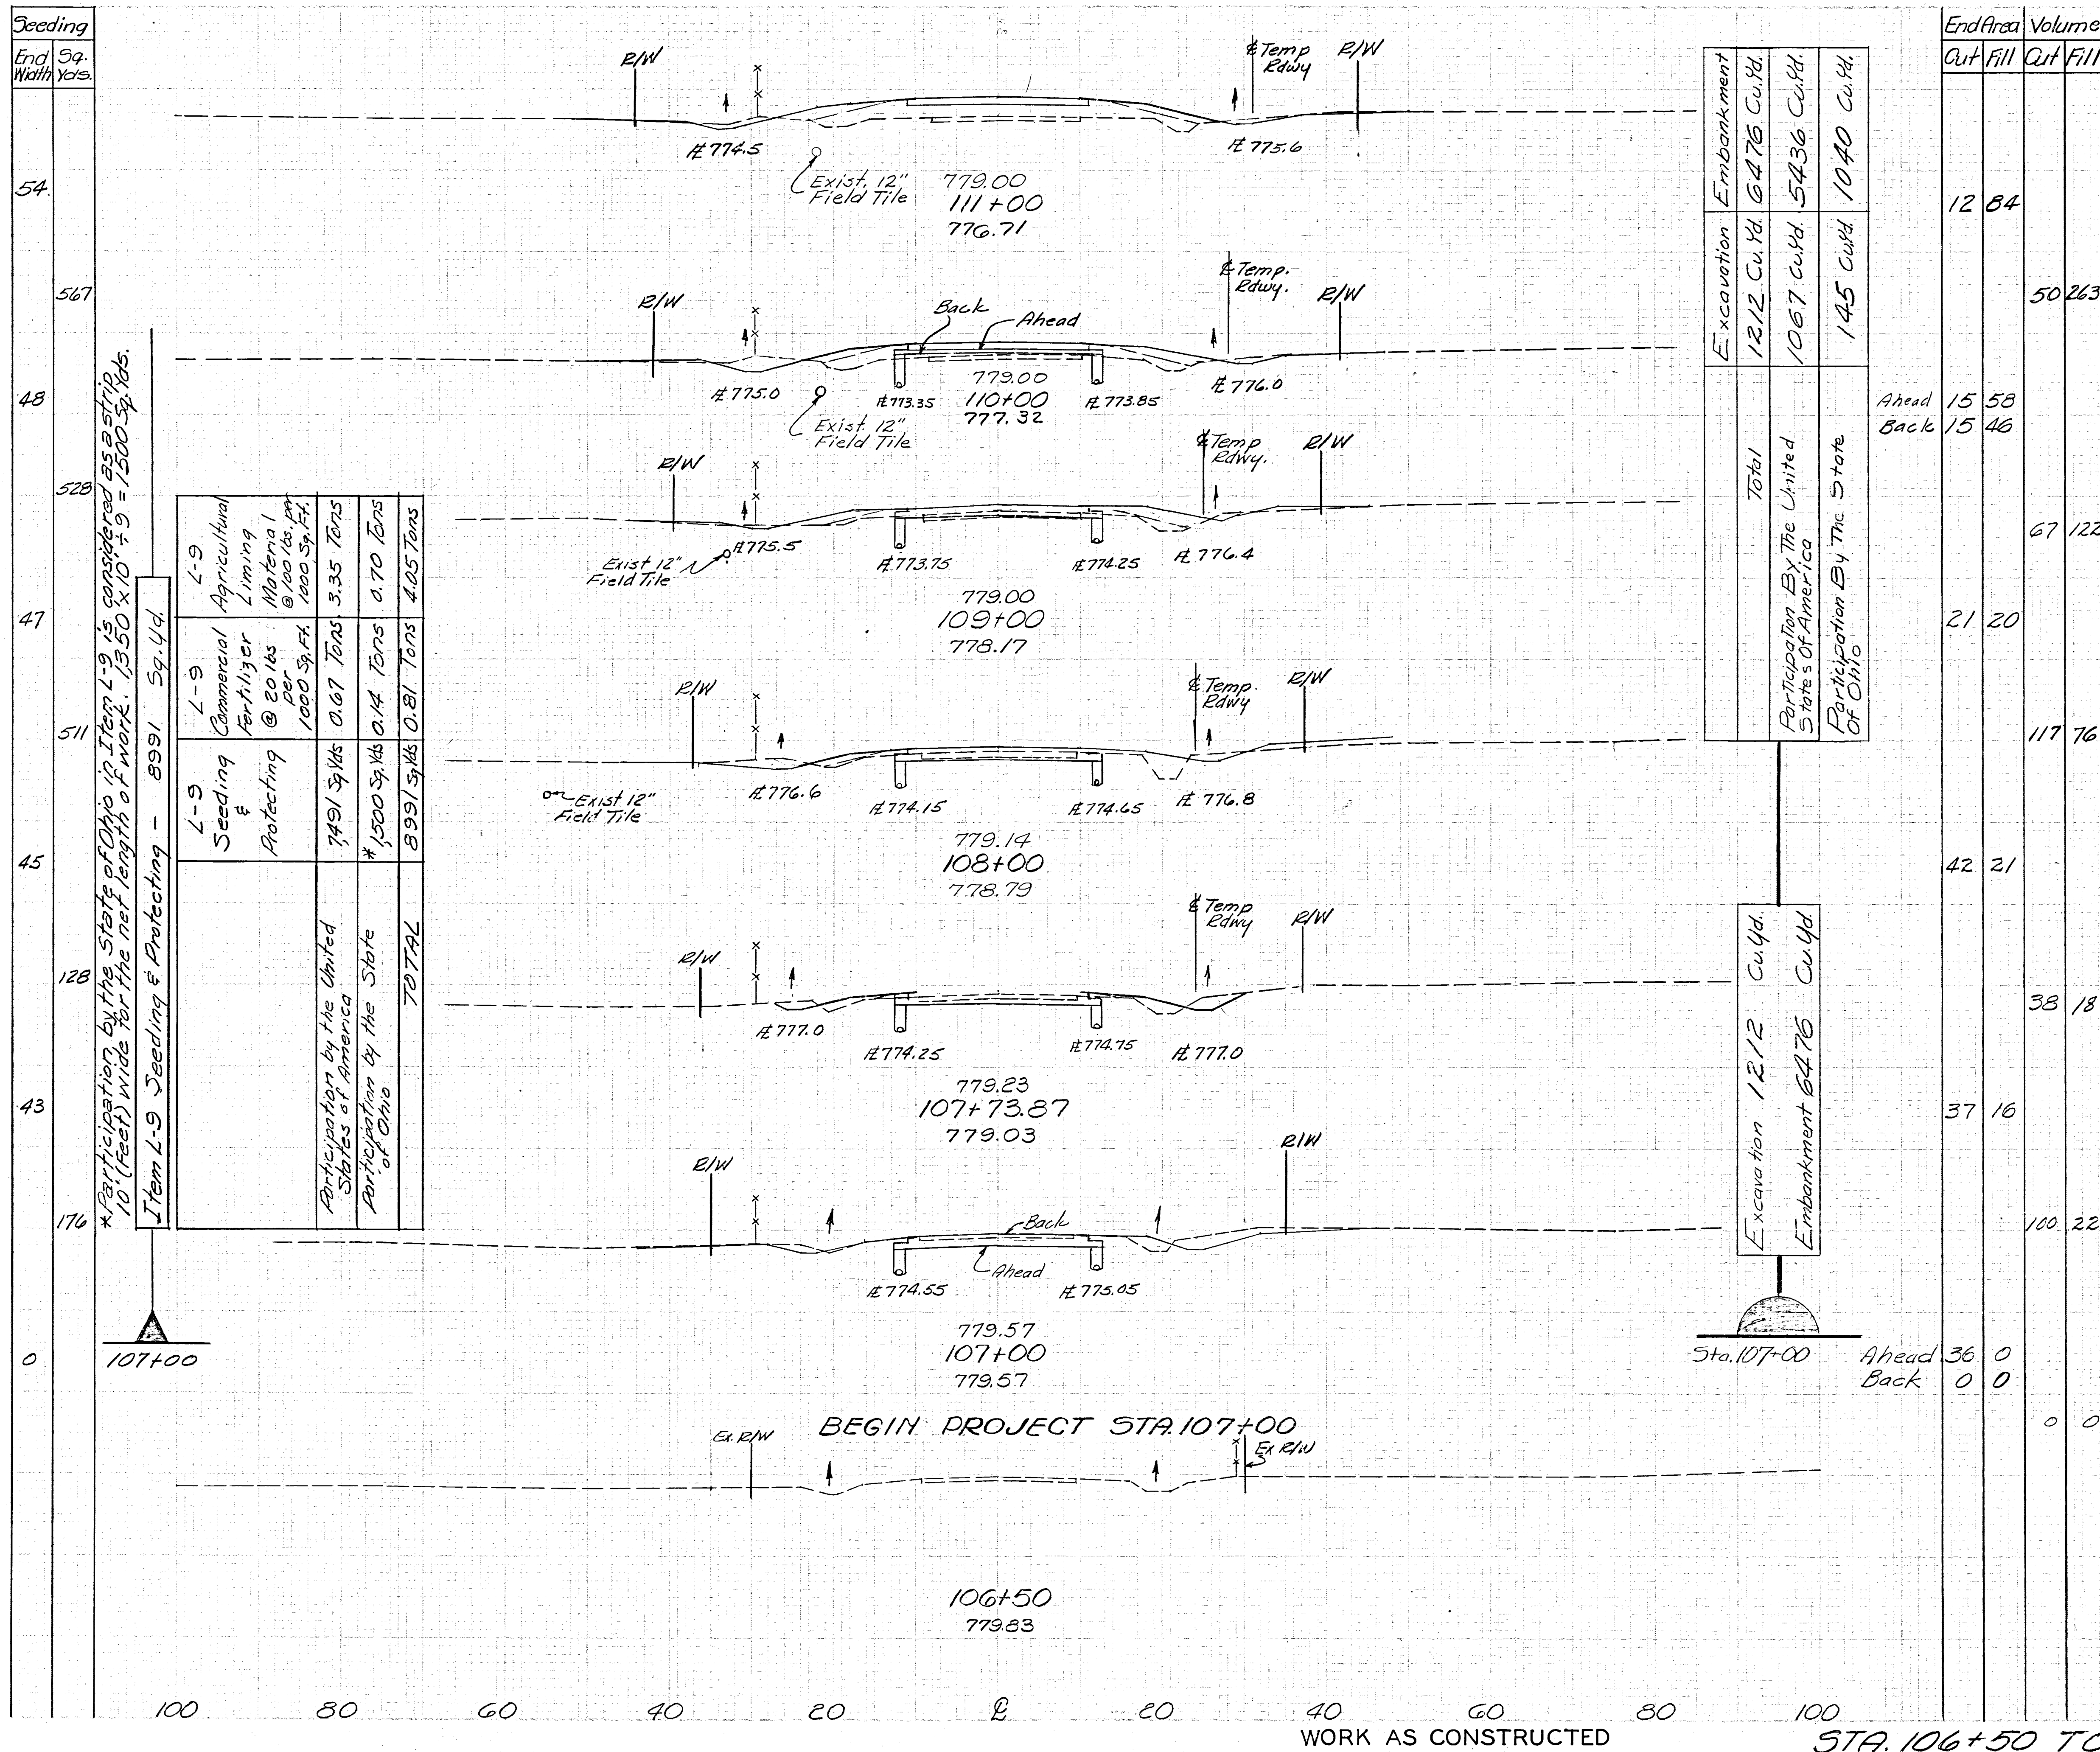

MUSKINGUM COUNTY MUS-156-2.02			
PARTICIPATION BY THE UNITED STATES OF AMERICA			
Stations	Earthwork		
	End Area		Volume
	Cut	Fill	
	12	84	
			50 263
Sta. 107+00	36	0	
Ahead	36	0	
Back	0	0	
			0 0

REVISION	DATE	DESCRIPTION	BY
U. S. ARMY ENGINEER DISTRICT, HUNTINGTON CORPS OF ENGINEERS HUNTINGTON, W. VA.			
DRAWN BY: F.H.S.		LICKING RIVER DILLON RESERVOIR PROJECT	
TRACED BY:		READJUSTMENT OF OHIO STATE ROUTE NO. 156 (Section 2)	
CHECKED BY: SEW		DATE: September 1959	
SUBMITTED BY: Elmer S. Barrett Associates		APPROVED: Steven Malachuk COL. C.E. DISTRICT ENGINEER	
RECOMMENDED: James H. Barnum CHIEF ENG. DIV.		ELMER S. BARRETT ASSOCIATES CONSULTING ENGINEERS CHILLICOTHE, OHIO	
SCALE: 1" = 10'		SPEC. NO. DRAWING NUMBER 027f-UD12-68/9	
SHEET 9 OF 14			