


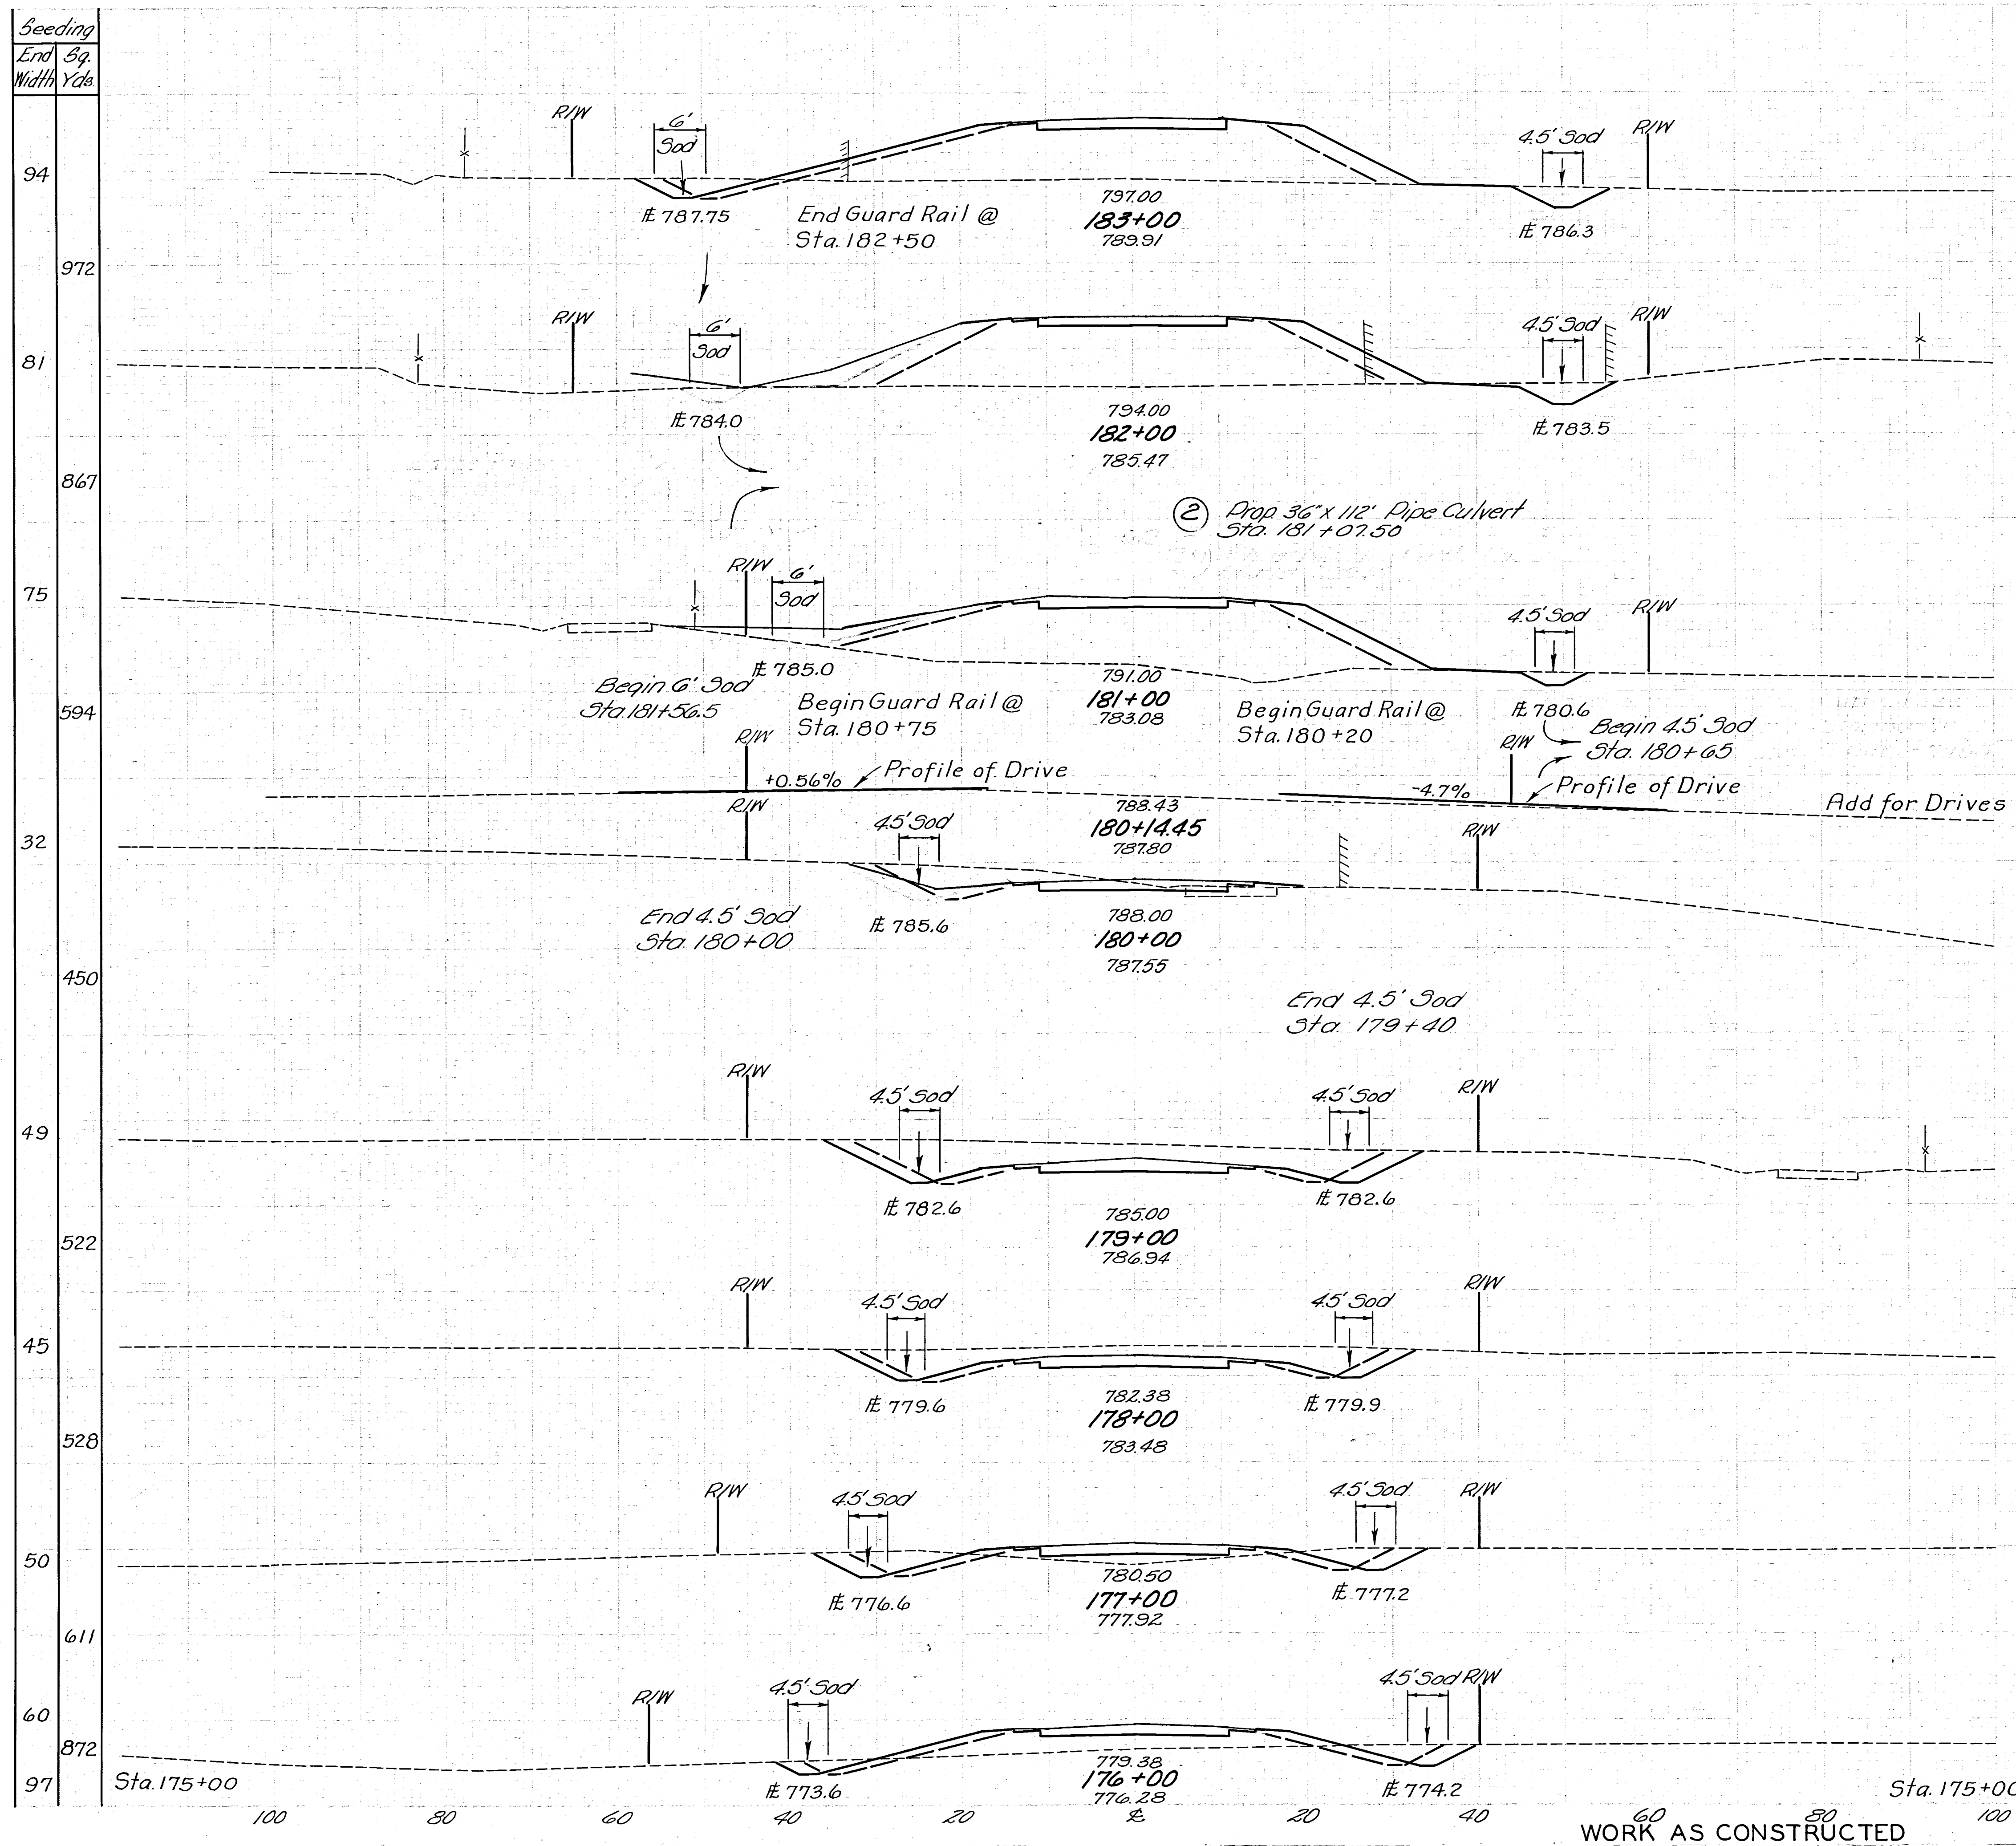

End Area		Volume	
Cut	Fill	Cut	Fill
40	349		
		124	1361
27	386		
		70	1461
11	403		
		15	174
83	3		
		533	6
205	0		
		669	0
156	0		
		381	52
50	28		
		148	226
30	94		
		120	757
35	315		

MUSKINGUM COUNTY
MUS-156-2.85

PARTICIPATION BY THE UNITED STATES OF AMERICA			
Stations	Earthwork		
	End Area	Volume	
	Cut	Fill	
Sta. 183+00	40	303	
			124 1165
Sta. 182+00	27	326	
			70 1246
Sta. 181+00	11	347	
			152 648
Add for Drives			15
Sta. 180+00	71	3	
			487 6
Sta. 179+00	192	0	
			630 0
Sta. 178+00	148	0	
			354 43
Sta. 177+00	43	23	
			120 178
Sta. 176+00	22	73	
			102 648
Sta. 175+00	33	277	

