


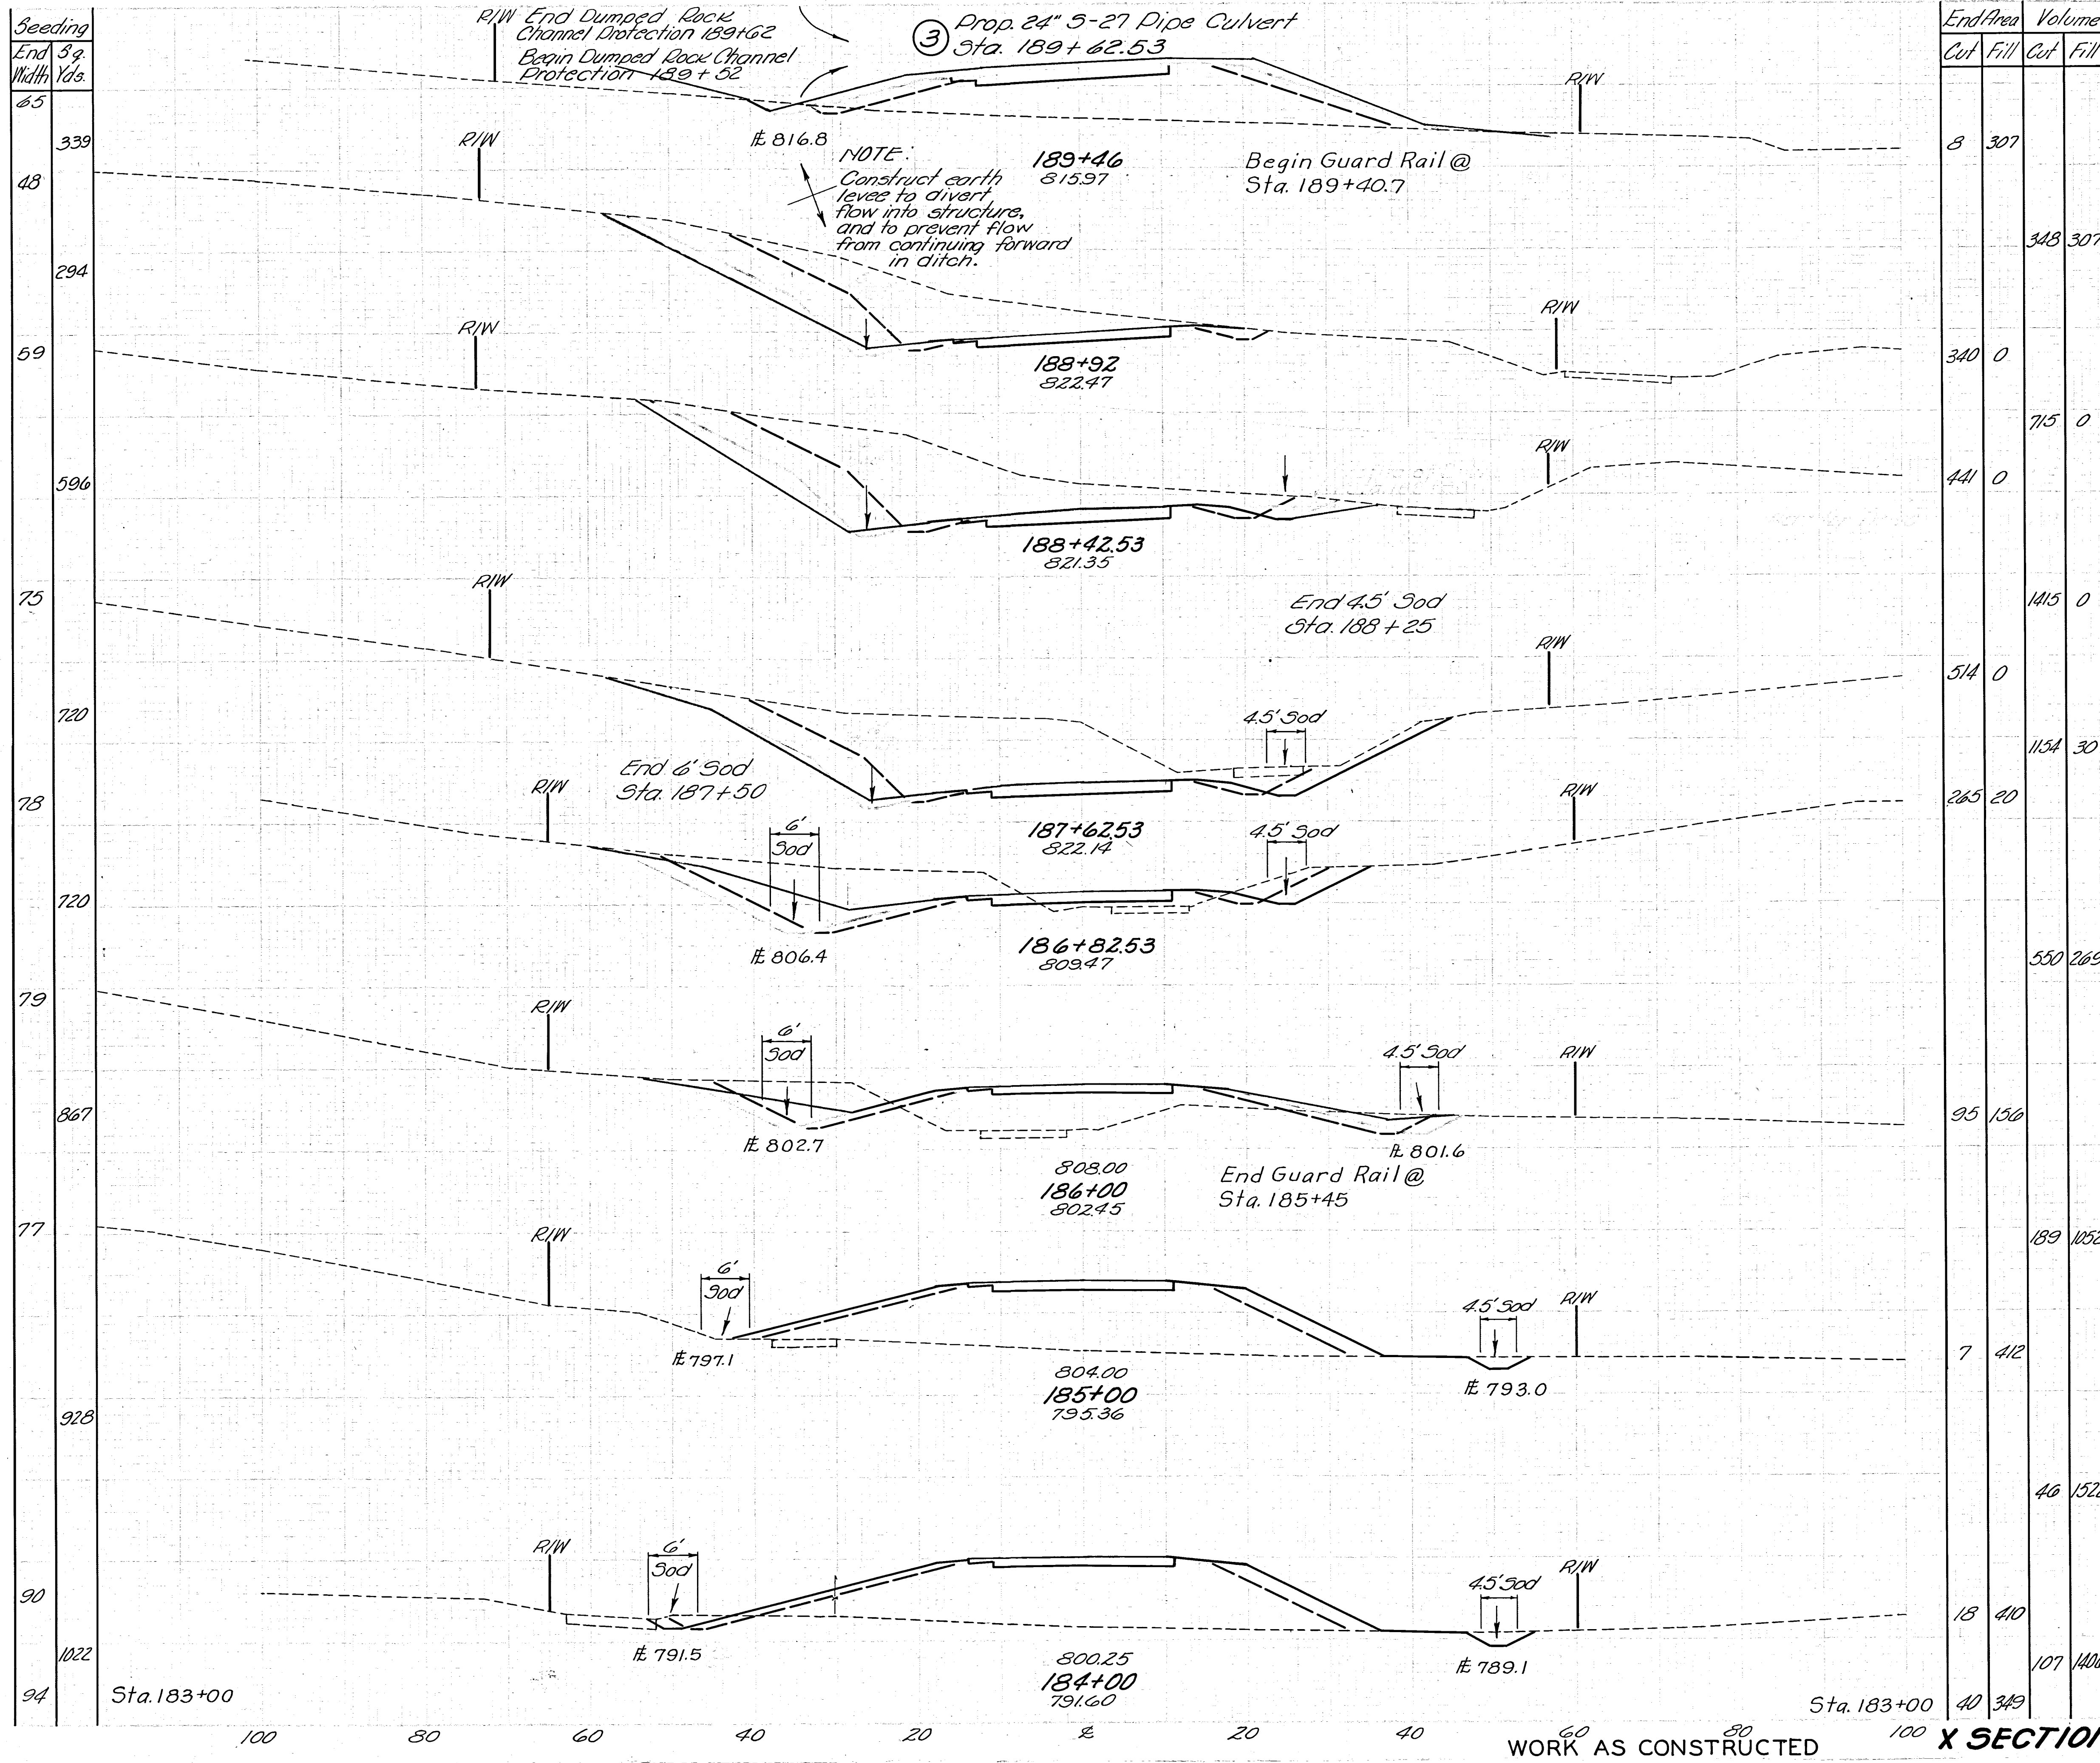

End Area		Volume	
Cut	Fill	Cut	Fill
8	307		
		348	307
340	0		
		715	0
441	0		
		1415	0
514	0		
		1154	30
265	20		
		550	269
95	156		
		189	1052
7	412		
		46	1522
18	410		
		107	1406
40	349		

PARTICIPATION BY THE UNITED STATES OF AMERICA					
Stations	Earthwork				
	End Area		Volume		
	Cut	Fill	Cut	Fill	
Sta. 189+46	8	260			
			246	260	
Sta. 188+92	238	0			
			533	0	
Sta. 188+42.53	344	0			
			1083	0	
Sta. 187+62.53	387	0			
			947	27	
Sta. 186+82.53	252	18			
			527	246	
Sta. 186+00	93	143			
			185	933	
Sta. 185+00	7	361			
			50	1341	
Sta. 184+00	20	363			
			111	1233	
Sta. 183+00	40	303			

REVISION	DATE	DESCRIPTION	BY
U. S. ARMY ENGINEER DISTRICT, HUNTINGTON CORPS OF ENGINEERS HUNTINGTON, W. VA.			
DRAWN BY: EEP		LICKING RIVER DILLON RESERVOIR PROJECT	
TRACED BY: EEW		RELOCATION OF OHIO STATE ROUTE NO. 156 (Section 3 & 4)	
CHECKED BY: EEW		DATE: JULY 1959	
SUBMITTED BY: E. S. Barrett		APPROVED: [Signature]	
ELMER S. BARRETT ASSOCIATES		COL. C. E. DISTRICT ENGINEER	
RECOMMENDED: [Signature]		CHIEF ENG. DIV.	
ELMER S. BARRETT ASSOCIATES CONSULTING ENGINEERS CHILLICOTHE, OHIO		SCALE: 1" = 10'-0" DRAWING NUMBER 0271-UD6-68/32 SHEET 32 OF 62	