


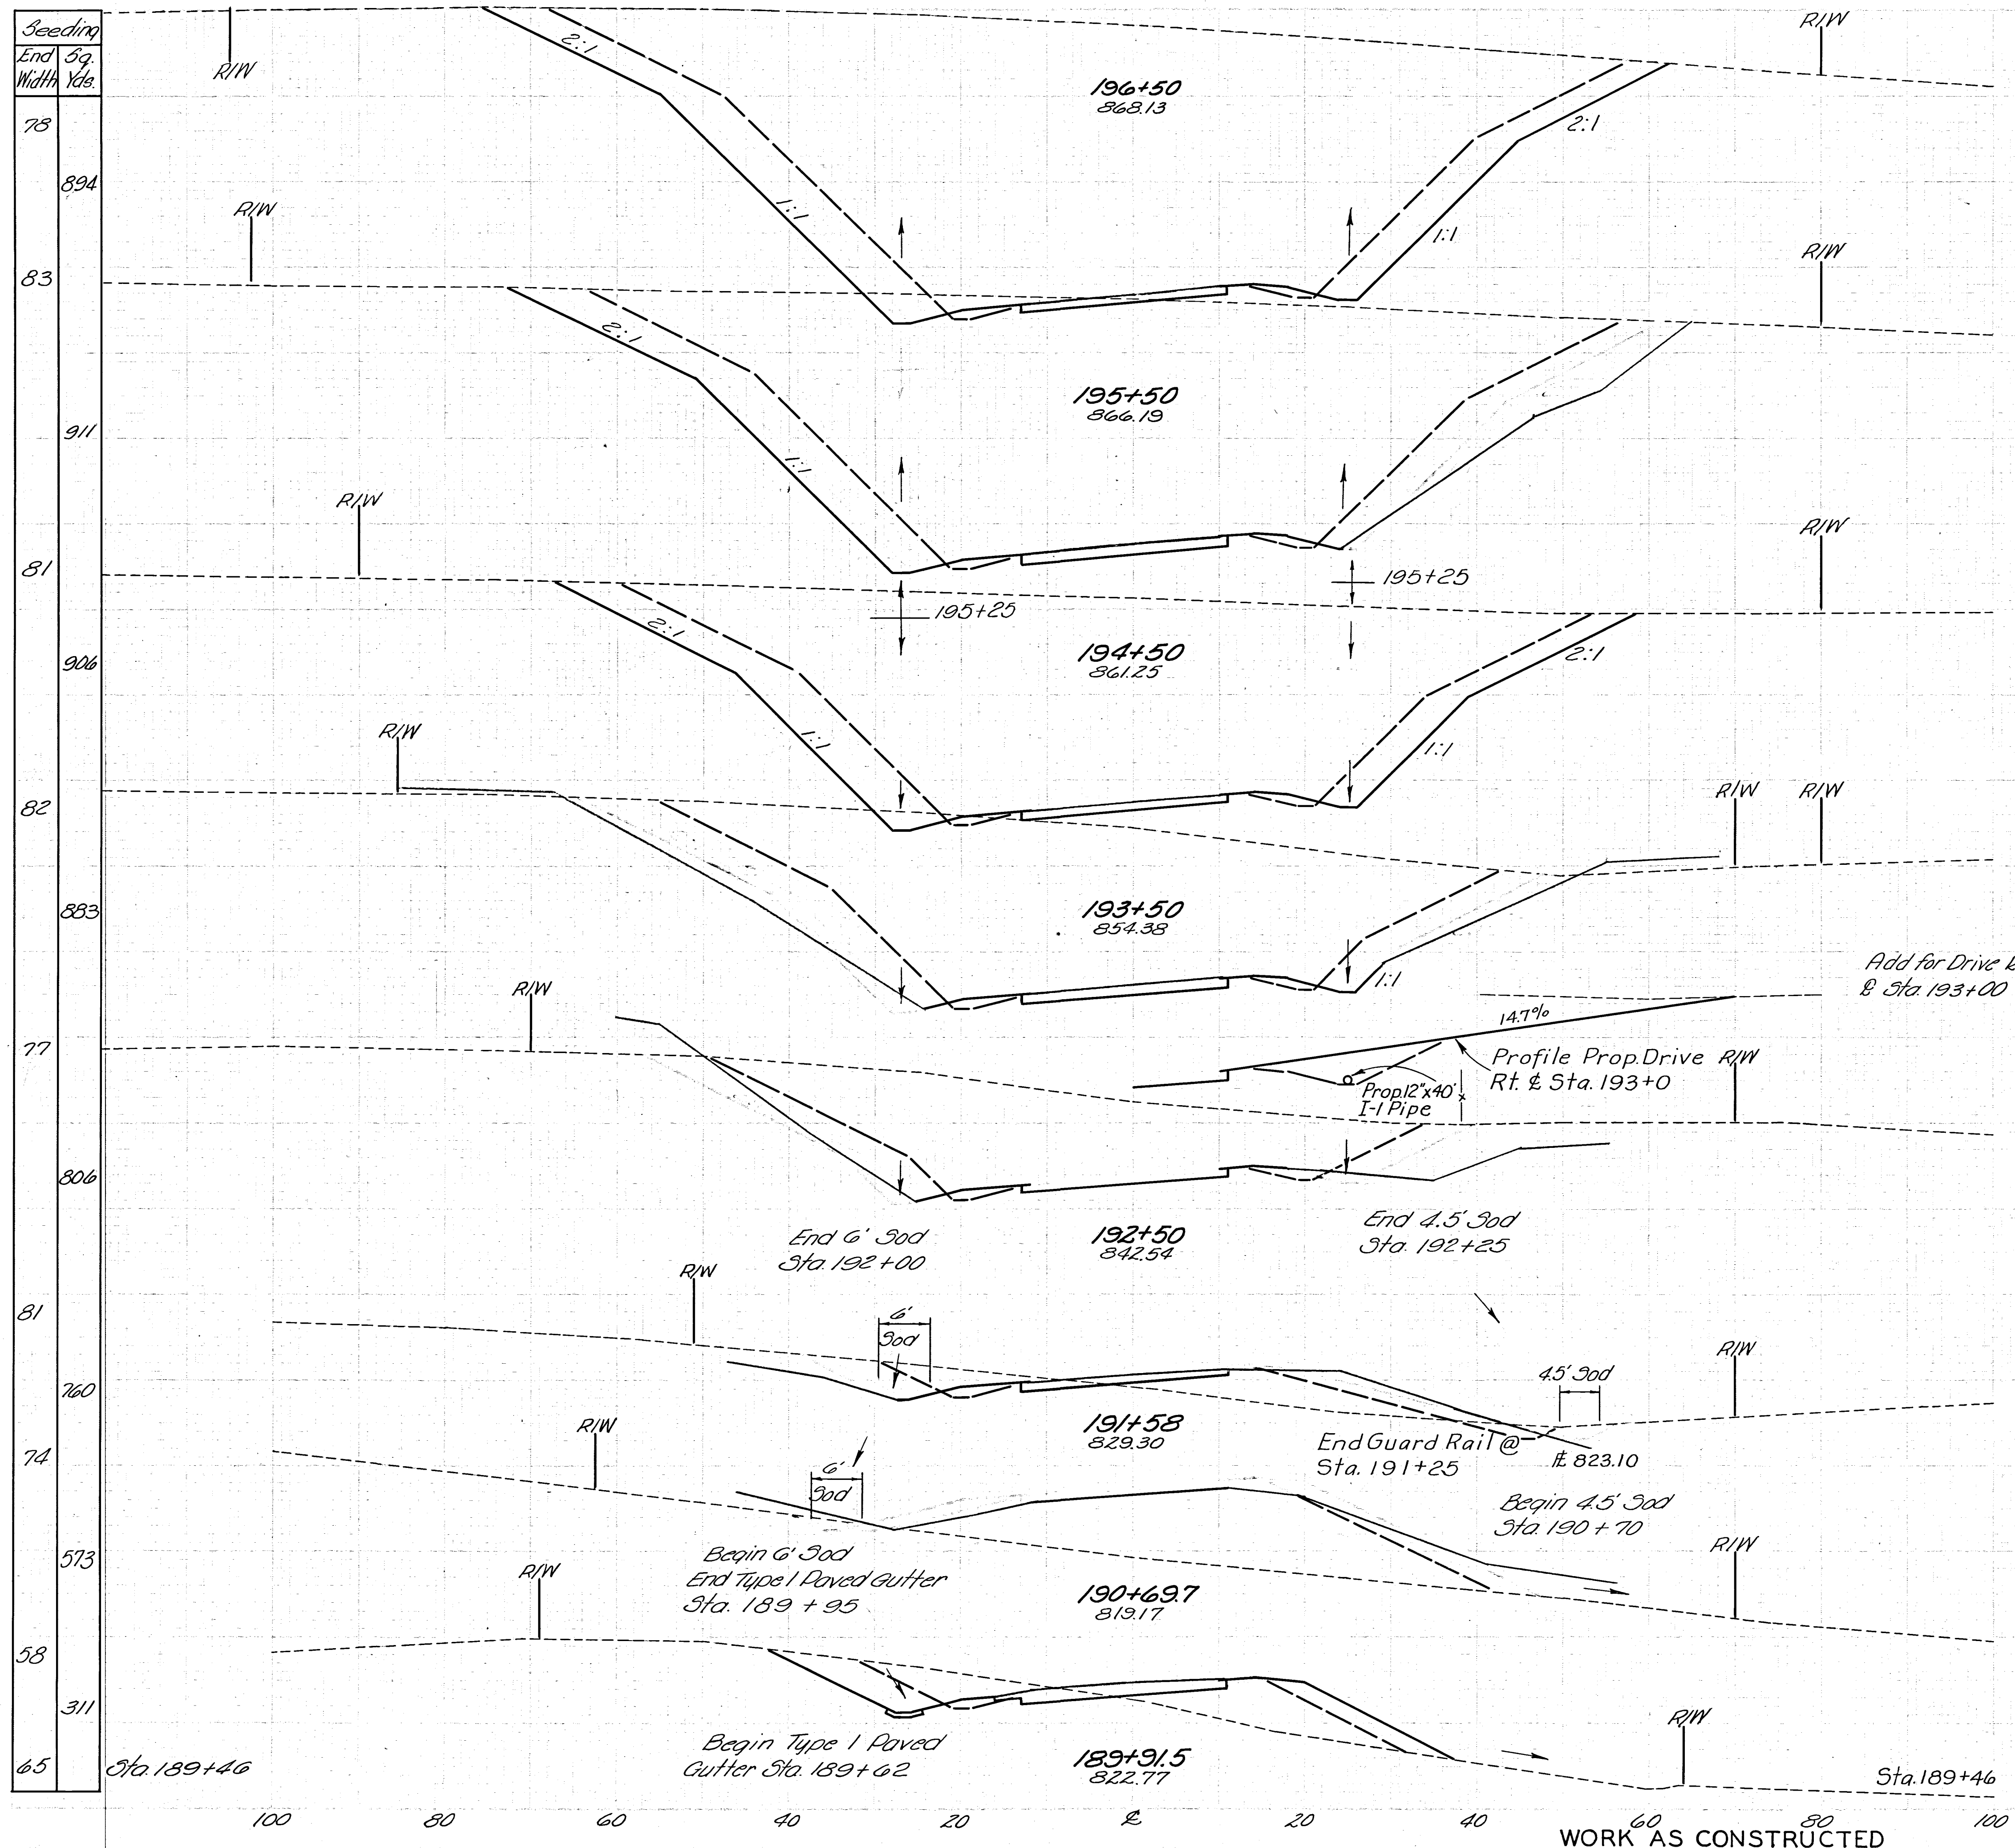

End Area		Volume	
Cut	Fill	Cut	Fill
2966	0		
		12354	0
2625	0		
		8800	0
2127	0		
		6780	0
1534	0		
		110	
		4283	0
779	0		
		1460	184
78	108		
		139	953
7	475		
		162	866
105	123		
		95	362
8	307		

33
62

MUSKINGUM COUNTY MUS-156 - 2.85

PARTICIPATION BY THE UNITED STATES OF AMERICA

Stations	Earthwork			
	End Area		Volume	
	Cut	Fill	Cut	Fill
Sta. 196+50	2553	0		
			8872	0
Sta. 195+50	2238	0		
			7469	0
Sta. 194+50	1795	0		
			5715	0
Sta. 193+50	1291	0		
Drive Rt. 193+0			110	
			3581	0
Sta. 192+50	643	0		
			1199	135
Sta. 191+58	61	79		
			111	806
Sta. 190+69.7	7	414		
			113	740
Sta. 189+91.5	71	97		
			67	301
Sta. 189+46	8	260		

REVISION	DATE	DESCRIPTION	BY
U. S. ARMY ENGINEER DISTRICT, HUNTINGTON CORPS OF ENGINEERS HUNTINGTON, W. VA.			
DRAWN BY: <i>EEB</i>		LICKING RIVER DILLON RESERVOIR PROJECT RELOCATION OF OHIO STATE ROUTE NO. 156 (Section 3 & 4)	
TRACED BY:			
CHECKED BY: <i>SW</i>			
SUBMITTED BY: <i>James S. Barrett</i>			
RECOMMENDED: <i>James S. Barrett</i>		APPROVED: <i>[Signature]</i>	DATE: JULY 1959
CHIEF ENG. DIV.		COL. C. E. DISTRICT ENGINEER	
ELMER S. BARRETT ASSOCIATES CONSULTING ENGINEERS CHILLICOTHE, OHIO		SCALE: 1" = 10'-0" DRAWING NUMBER: 027f-UD6-68/33 SHEET 33 OF 62	