


RELOCATION OF SONORA ROAD

PERRY TOWNSHIP

LOREN C. CAMP
MUSKINGUM CO. ENGINEER

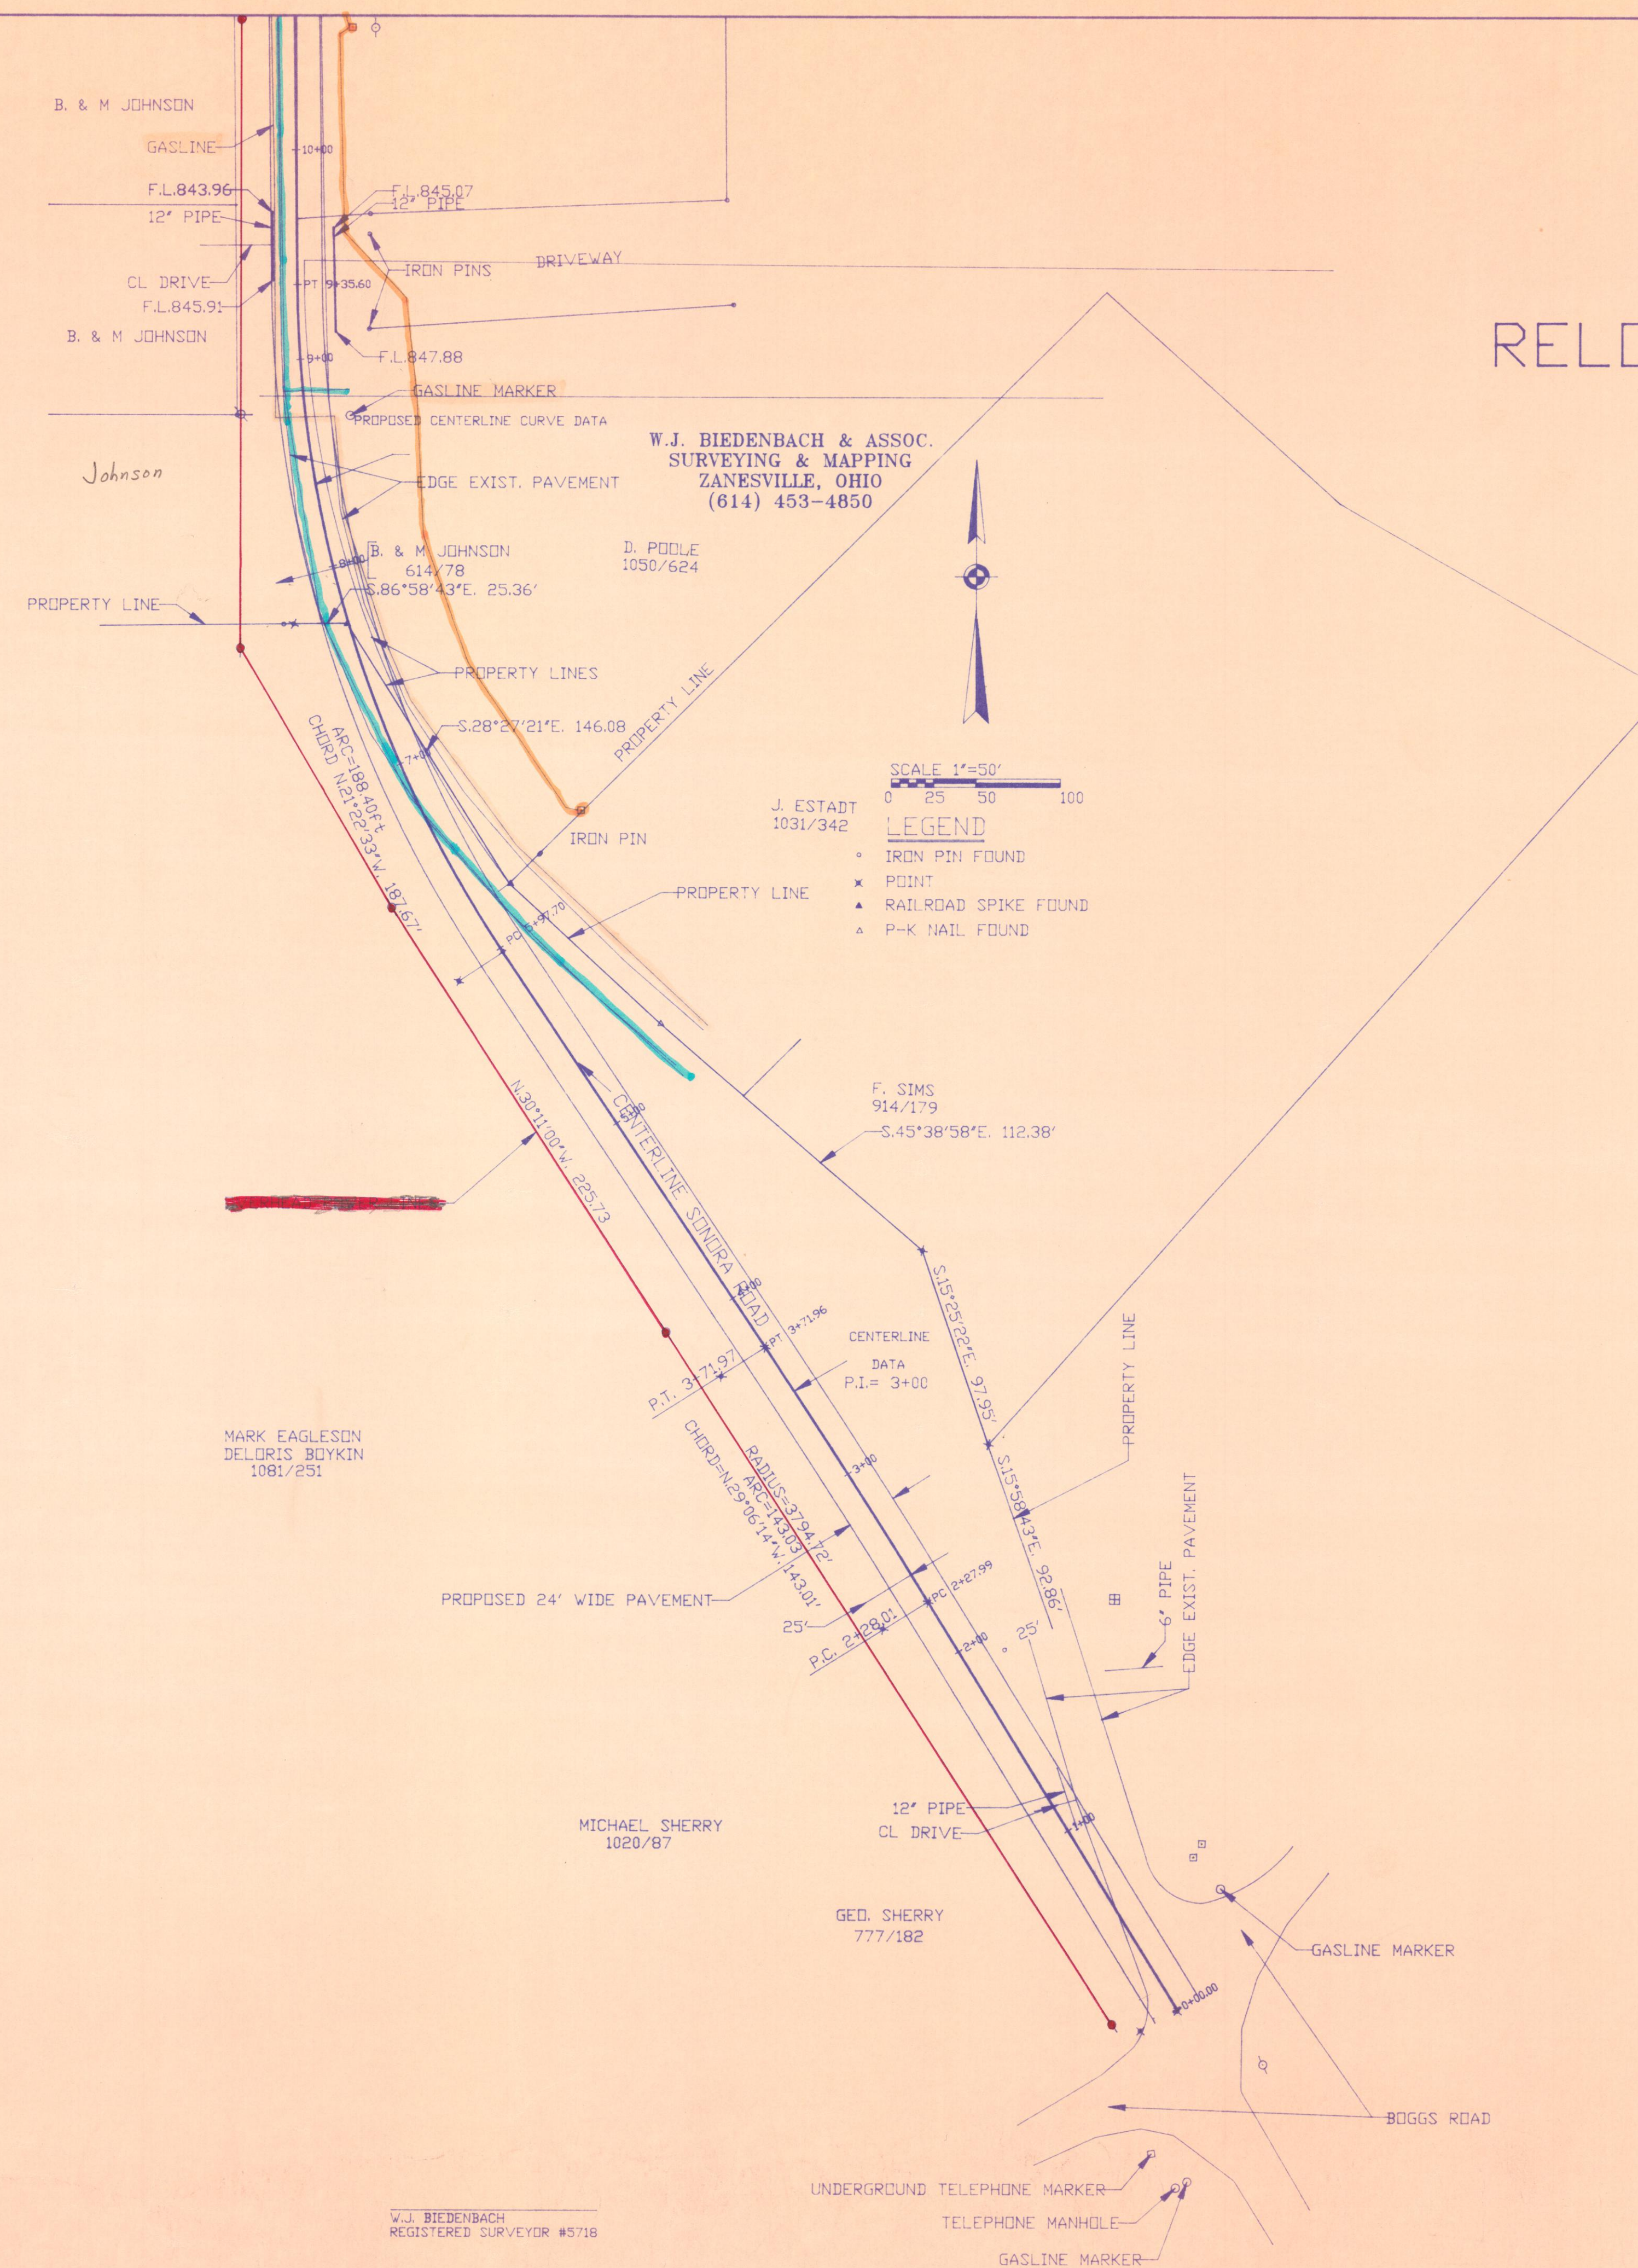

W.J. BIEDENBACH
REGISTERED SURVEYOR #5718

W.J. BIEDENBACH & ASSOC.
SURVEYING & MAPPING
ZANESVILLE, OHIO
(614) 453-4850

DRAWN BY: WJB MUSKINGUM CO.

SCALE: 1"=50' CHECKED BY: WJB

File name: D:\SONORA\SONORA
Plot date: 04/24/95 at 10:22