


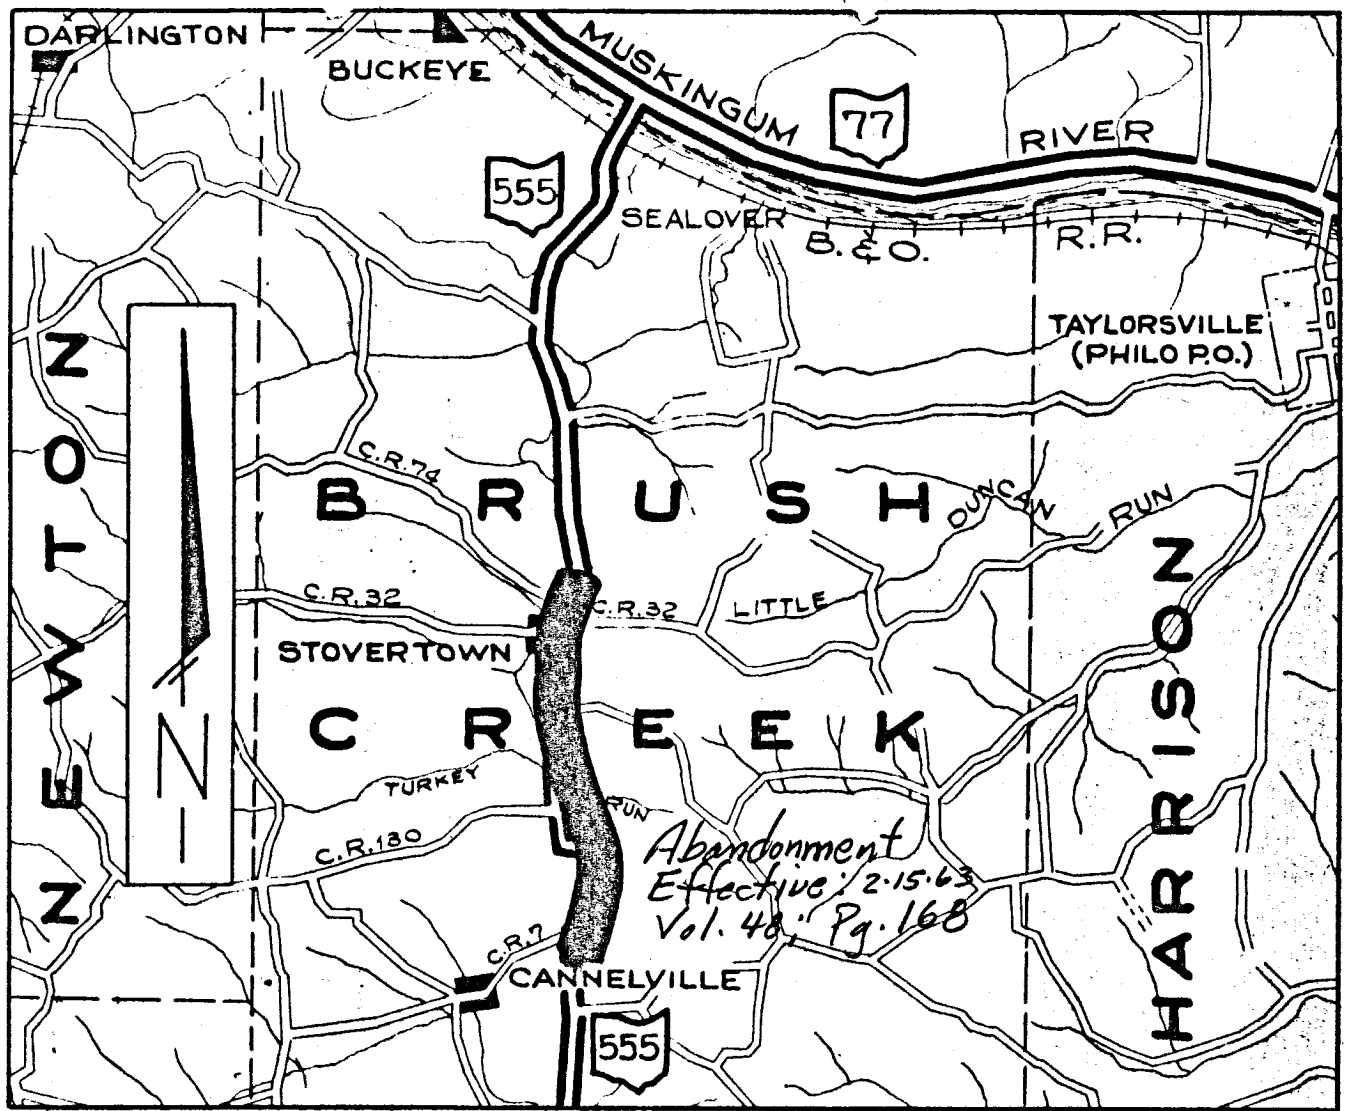


~ LOCATION MAP ~

Scale: 1"=1 Mile

MUS ~ 555 ~ 4.02

LEGEND

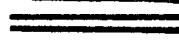Proposed Relocation 
 State Routes 
 Other Routes 