


PROPERTY MAP

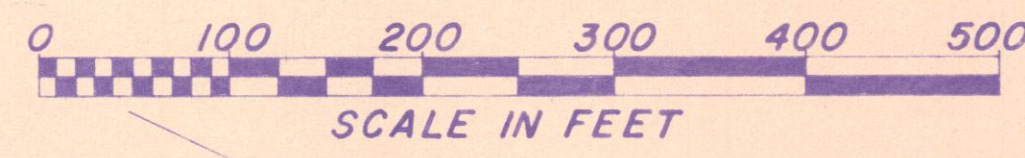


STATE JOB NO.	F.R.D.	STATE	PROJECT
05044(2)	2	OHIO	U-400(14)

77
86

MUSKINGUM COUNTY MUS-60-1741 PROPERTY MAP

4
13

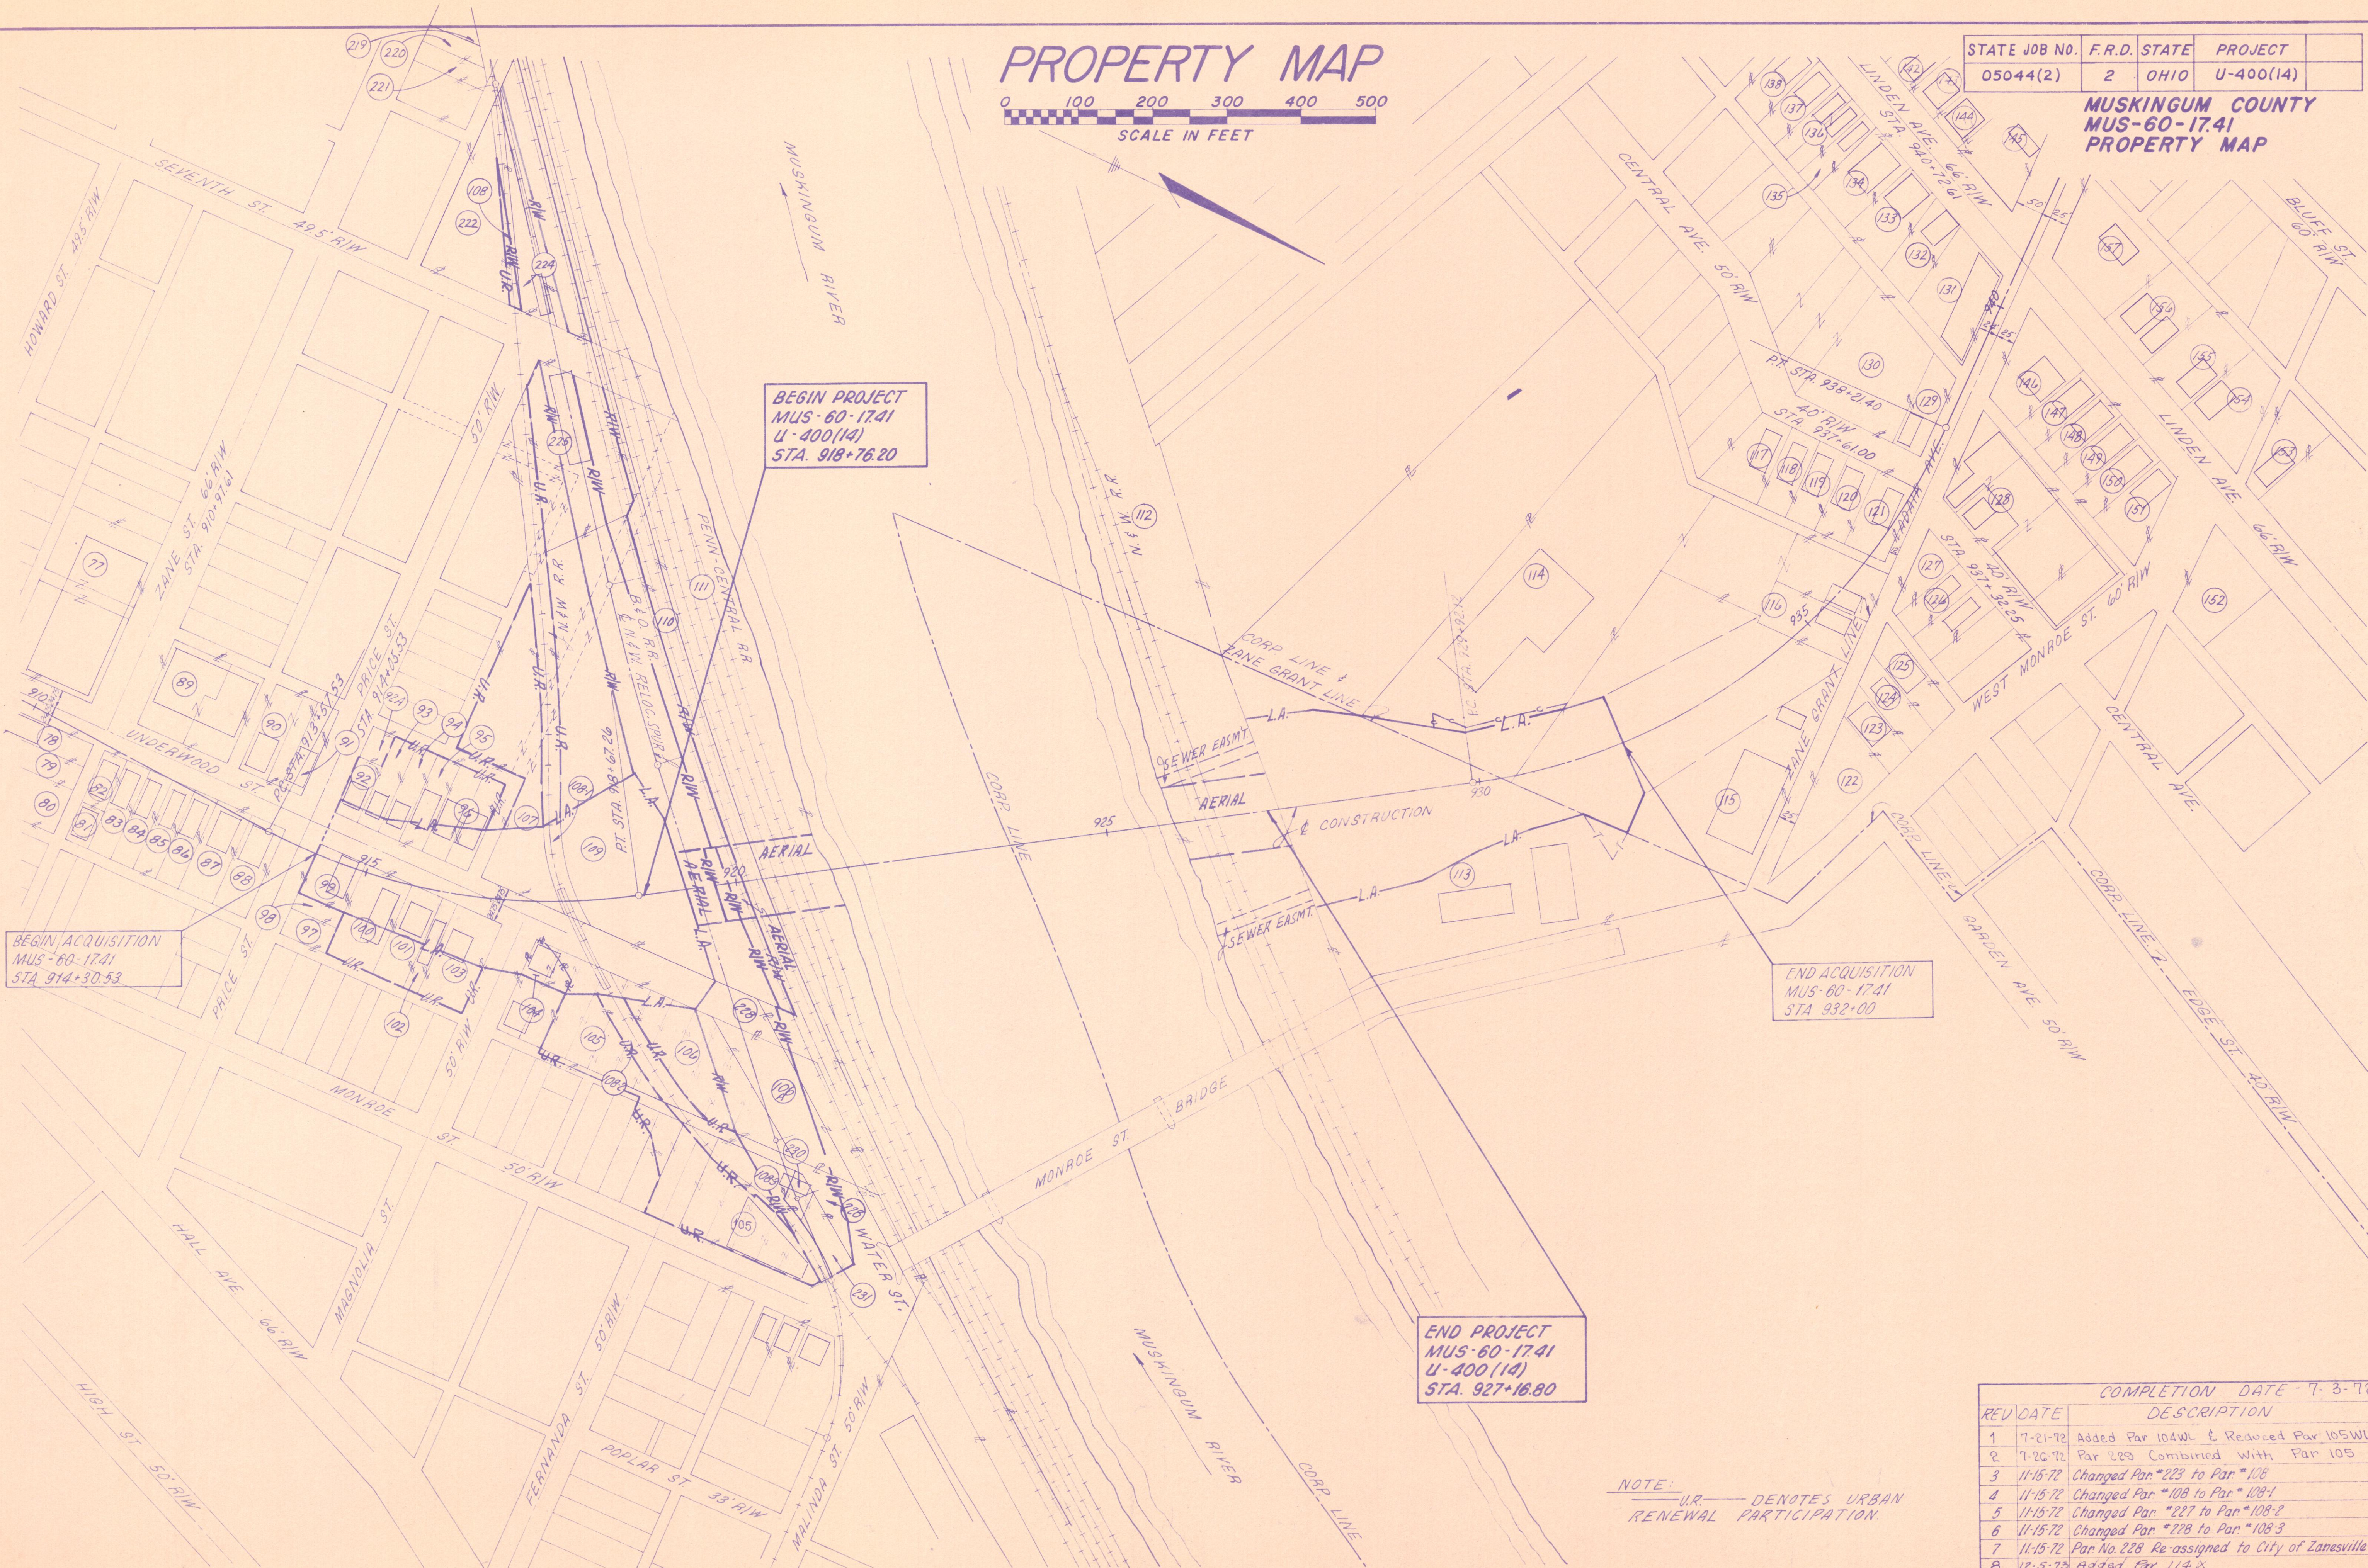

BEGIN PROJECT
MUS-60-1741
U-400(14)
STA. 918+76.20

BEGIN ACQUISITION
MUS-60-1741
STA. 914+30.53

END ACQUISITION
MUS-60-1741
STA. 932+00

END PROJECT
MUS-60-1741
U-400(14)
STA. 927+16.80

NOTE: —UR— DENOTES URBAN
RENEWAL PARTICIPATION.

COMPLETION DATE - 7-3-72		
REV	DATE	DESCRIPTION
1	7-21-72	Added Par 104WL & Reduced Par 105WL
2	7-26-72	Par 229 Combined With Par 105
3	11-15-72	Changed Par *223 to Par *108
4	11-15-72	Changed Par *108 to Par *108-1
5	11-15-72	Changed Par *227 to Par *108-2
6	11-15-72	Changed Par *228 to Par *108-3
7	11-15-72	Par No. 228 Re-assigned to City of Zanesville
8	12-5-73	Added Par 114X