


Exist R/W Maple Avenue
Curve Data
 $\Delta = 37^\circ 18' 55''$
 $Dc = 10'$ (Chord Definition)
 $R = 573.69'$
 $T = 193.71'$
 $L = 373.63'$ (Actual Arc Length)
 $E = 31.82'$
 $PC = Sta. 60+40.16$
 $PI = Sta. 62+33.87$
 $PT = Sta. 64+13.79$

Proposed R/W And Construction
Maple Avenue Curve Data
 $\Delta = 37^\circ 18' 55''$
 $Dc = 7^\circ 30'$
 $R = 763.94'$
 $T = 257.95'$
 $L = 497.54'$
 $E = 42.37'$
 $PC = Sta. 59+75.92$
 $PI = Sta. 62+33.87$
 $PT = Sta. 64+73.46$

General Growth Development Corporation

(10 WD) CONT. = .166 Ac.
 (10 T) CONT. = .130 Ac.
 (10 T-1) CONT. = .122 Ac.
 (10 T-2) CONT. = .013 Ac.

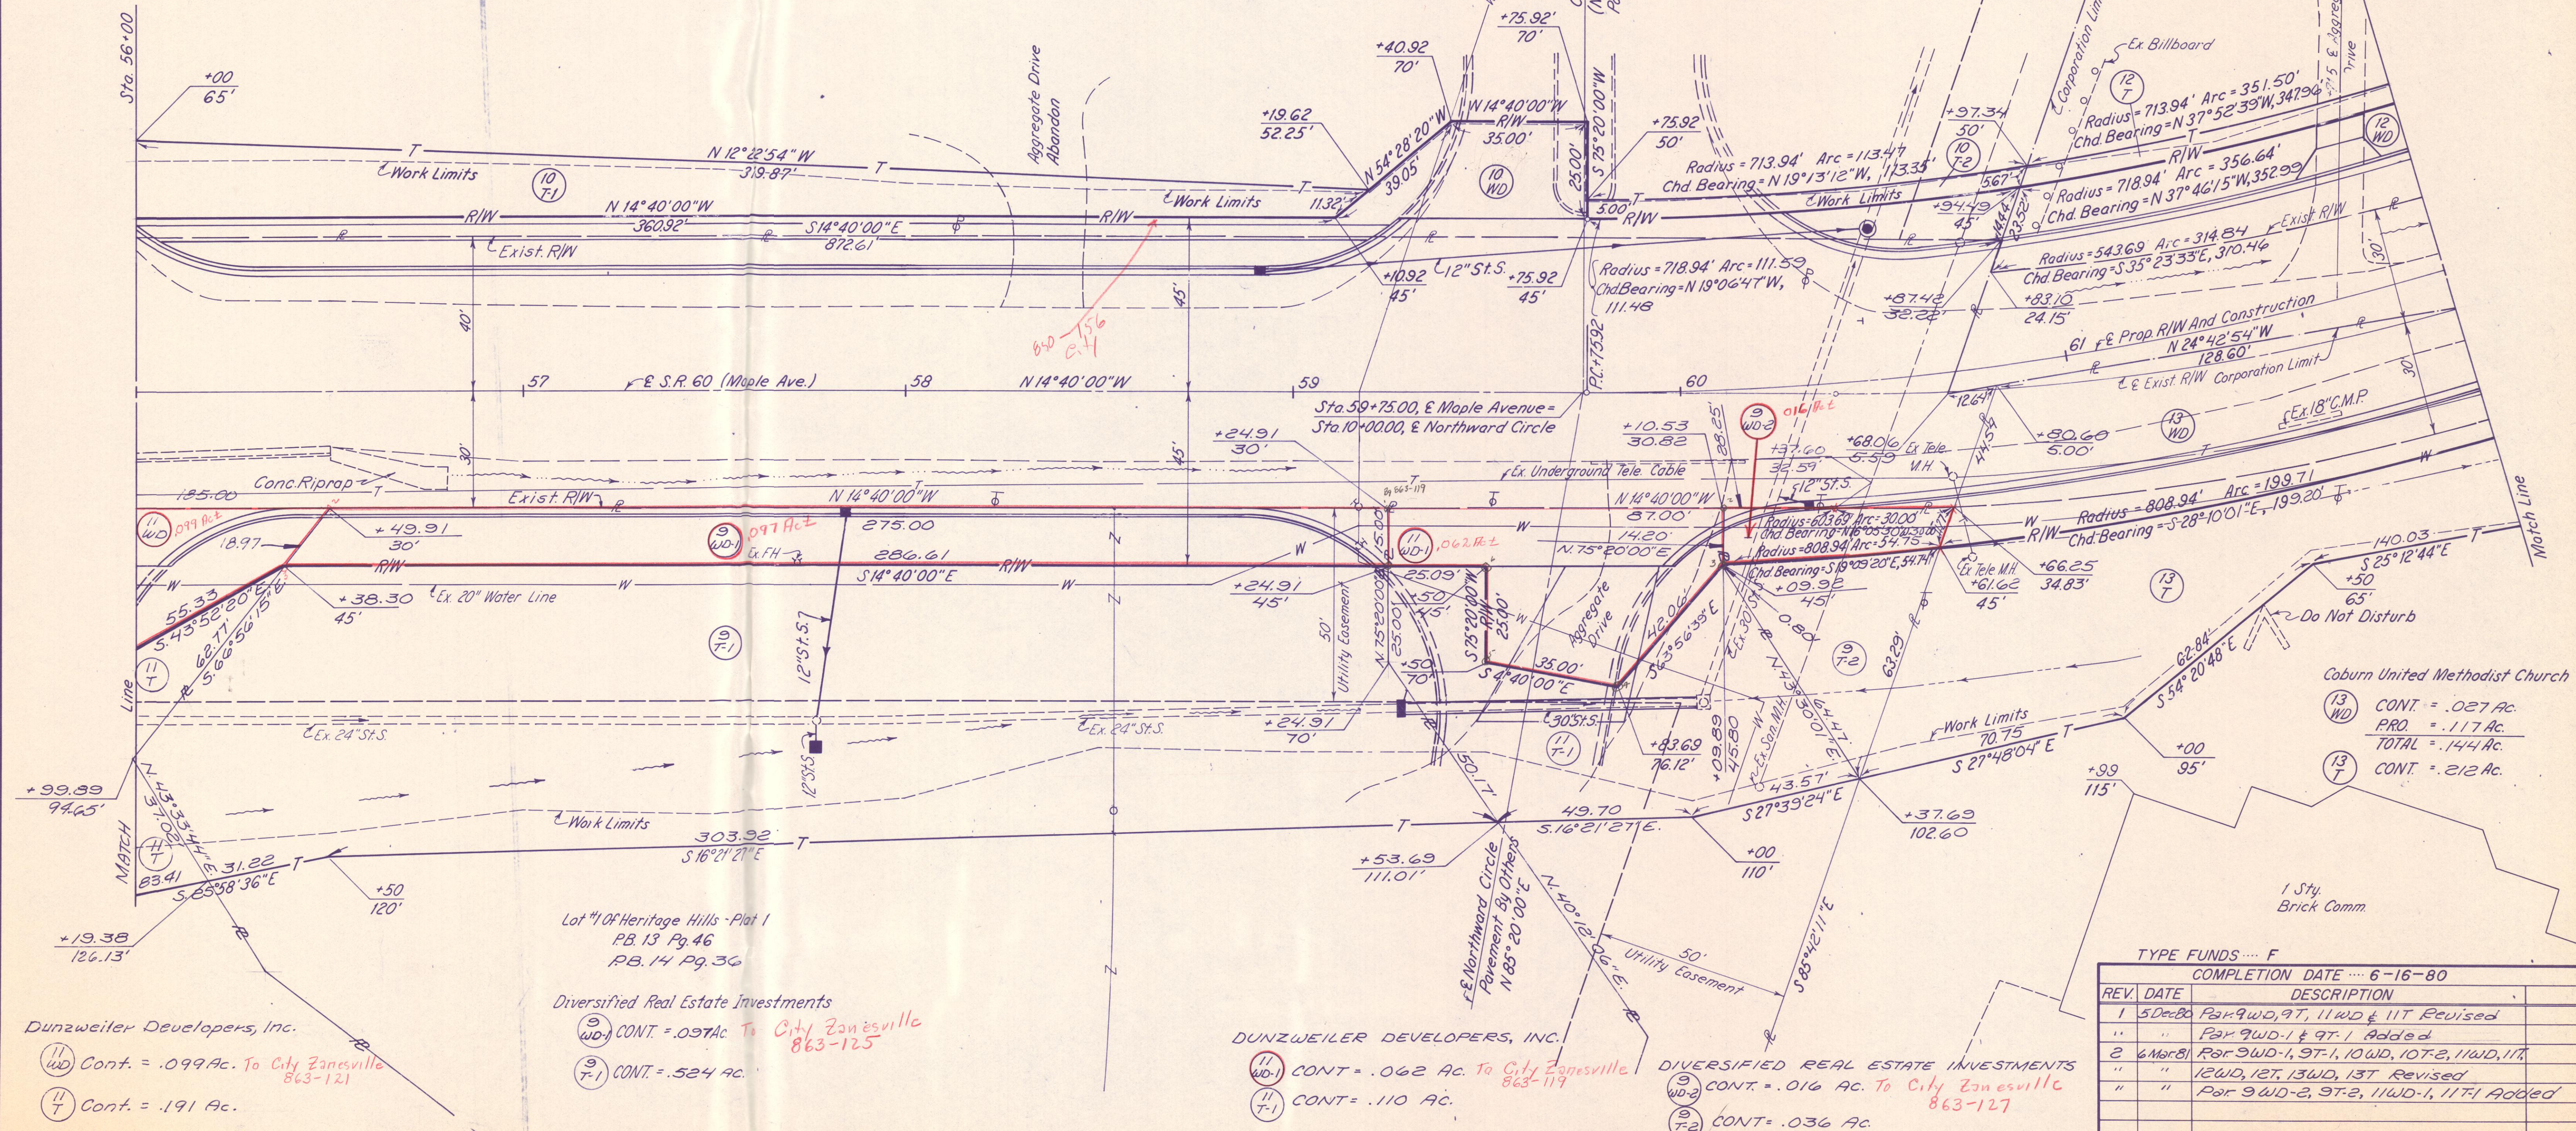

Dunzweiler Developers, Inc.

(11 WD) Cont. = .099 Ac. To City Zanesville 863-121
 (11 T) Cont. = .191 Ac.

Lot #10 of Heritage Hills - Plat 1
P.B. 13 Pg. 46
P.B. 14 Pg. 36

Diversified Real Estate Investments

(9 WD-1) CONT. = .037 Ac. To City Zanesville 863-125
 (9 T-1) CONT. = .524 Ac.

DUNZWEILER DEVELOPERS, INC.

(11 WD-1) CONT. = .062 Ac. To City Zanesville 863-119
 (11 T-1) CONT. = .110 Ac.

DIVERSIFIED REAL ESTATE INVESTMENTS

(9 WD-2) CONT. = .016 Ac. To City Zanesville 863-127
 (9 T-2) CONT. = .036 Ac.

TYPE FUNDS F

COMPLETION DATE 6-16-80

REV.	DATE	DESCRIPTION
1	5 Dec 80	Par 9 WD, 9T, 11 WD & 11T Revised
"	"	Par 9 WD-1 & 9T-1 Added
2	6 Mar 81	Par 9 WD-1, 9T-1, 10 WD, 10T-2, 11 WD, 11T
"	"	12 WD, 12T, 13 WD, 13T Revised
"	"	Par 9 WD-2, 9T-2, 11 WD-1, 11T-1 Added