

Received Dec 18, 1980 Time 2:17 P.M.
Recorded Dec 18, 1980
Plat Book 15 Page 100
Signed *David S. Guthrie* Recorder, Muskingum Co., Ohio
Fees \$ 8.75

This shaded area of this plat approved
and accepted by us this 11th day of Sept.
1980 for maintenance and public use

David S. Guthrie Board of
Highway Commissioners of
Muskingum County, Ohio

I certify that the shaded area of this
plat has been constructed according
to the approved plan, specification,
date: 12-17-80

David S. Guthrie
District Deputy Director

I find that the section of road as shown
by the shaded area has been constructed
in a satisfactory manner and is in good repair
Date: 12-17-80
David S. Guthrie
Muskingum County Engineer

TRANSFER
NOT NECESSARY
DEC 18 1980
David S. Guthrie
Auditor, Muskingum County, Ohio

CENTERLINE SURVEY PLAT

INTERSTATE ROUTE 70
MUS-70-21.31 MUSKINGUM COUNTY
PERRY TOWNSHIP, T-1, R-6, SEC. 11
UNION TOWNSHIP, T-1, R-5, SEC. 7, 8, 13, 14, & 15





FED. RD. DIVISION	STATE	PROJECT
2	OHIO	

LIMITED ACCESS.
MUS. 70-21.31

Plat 15
Book 15 100

I hereby certify that this is a true
delineation of a survey made for the
Ohio Department of Highways in 1962
by RACKOFF ASSOCIATES.

David S. Guthrie
David S. Guthrie
Date Feb. 17, 1964
Registered Surveyor No. 4378

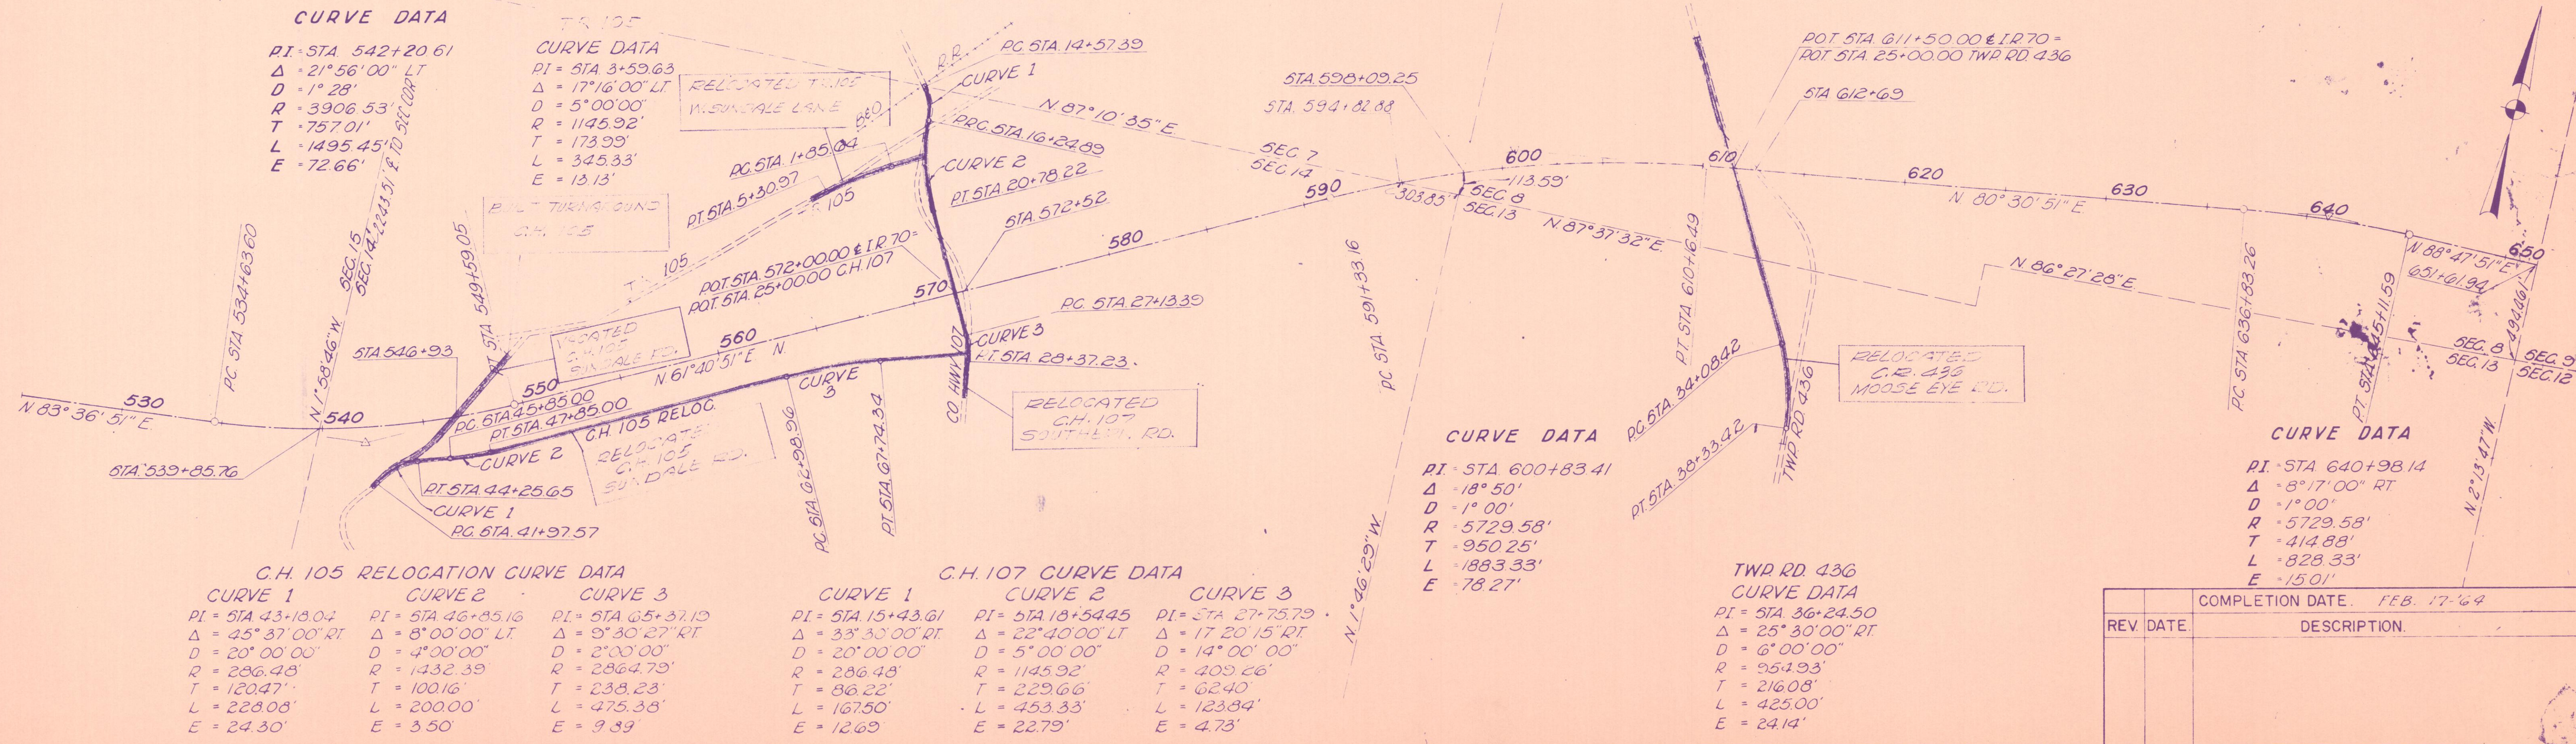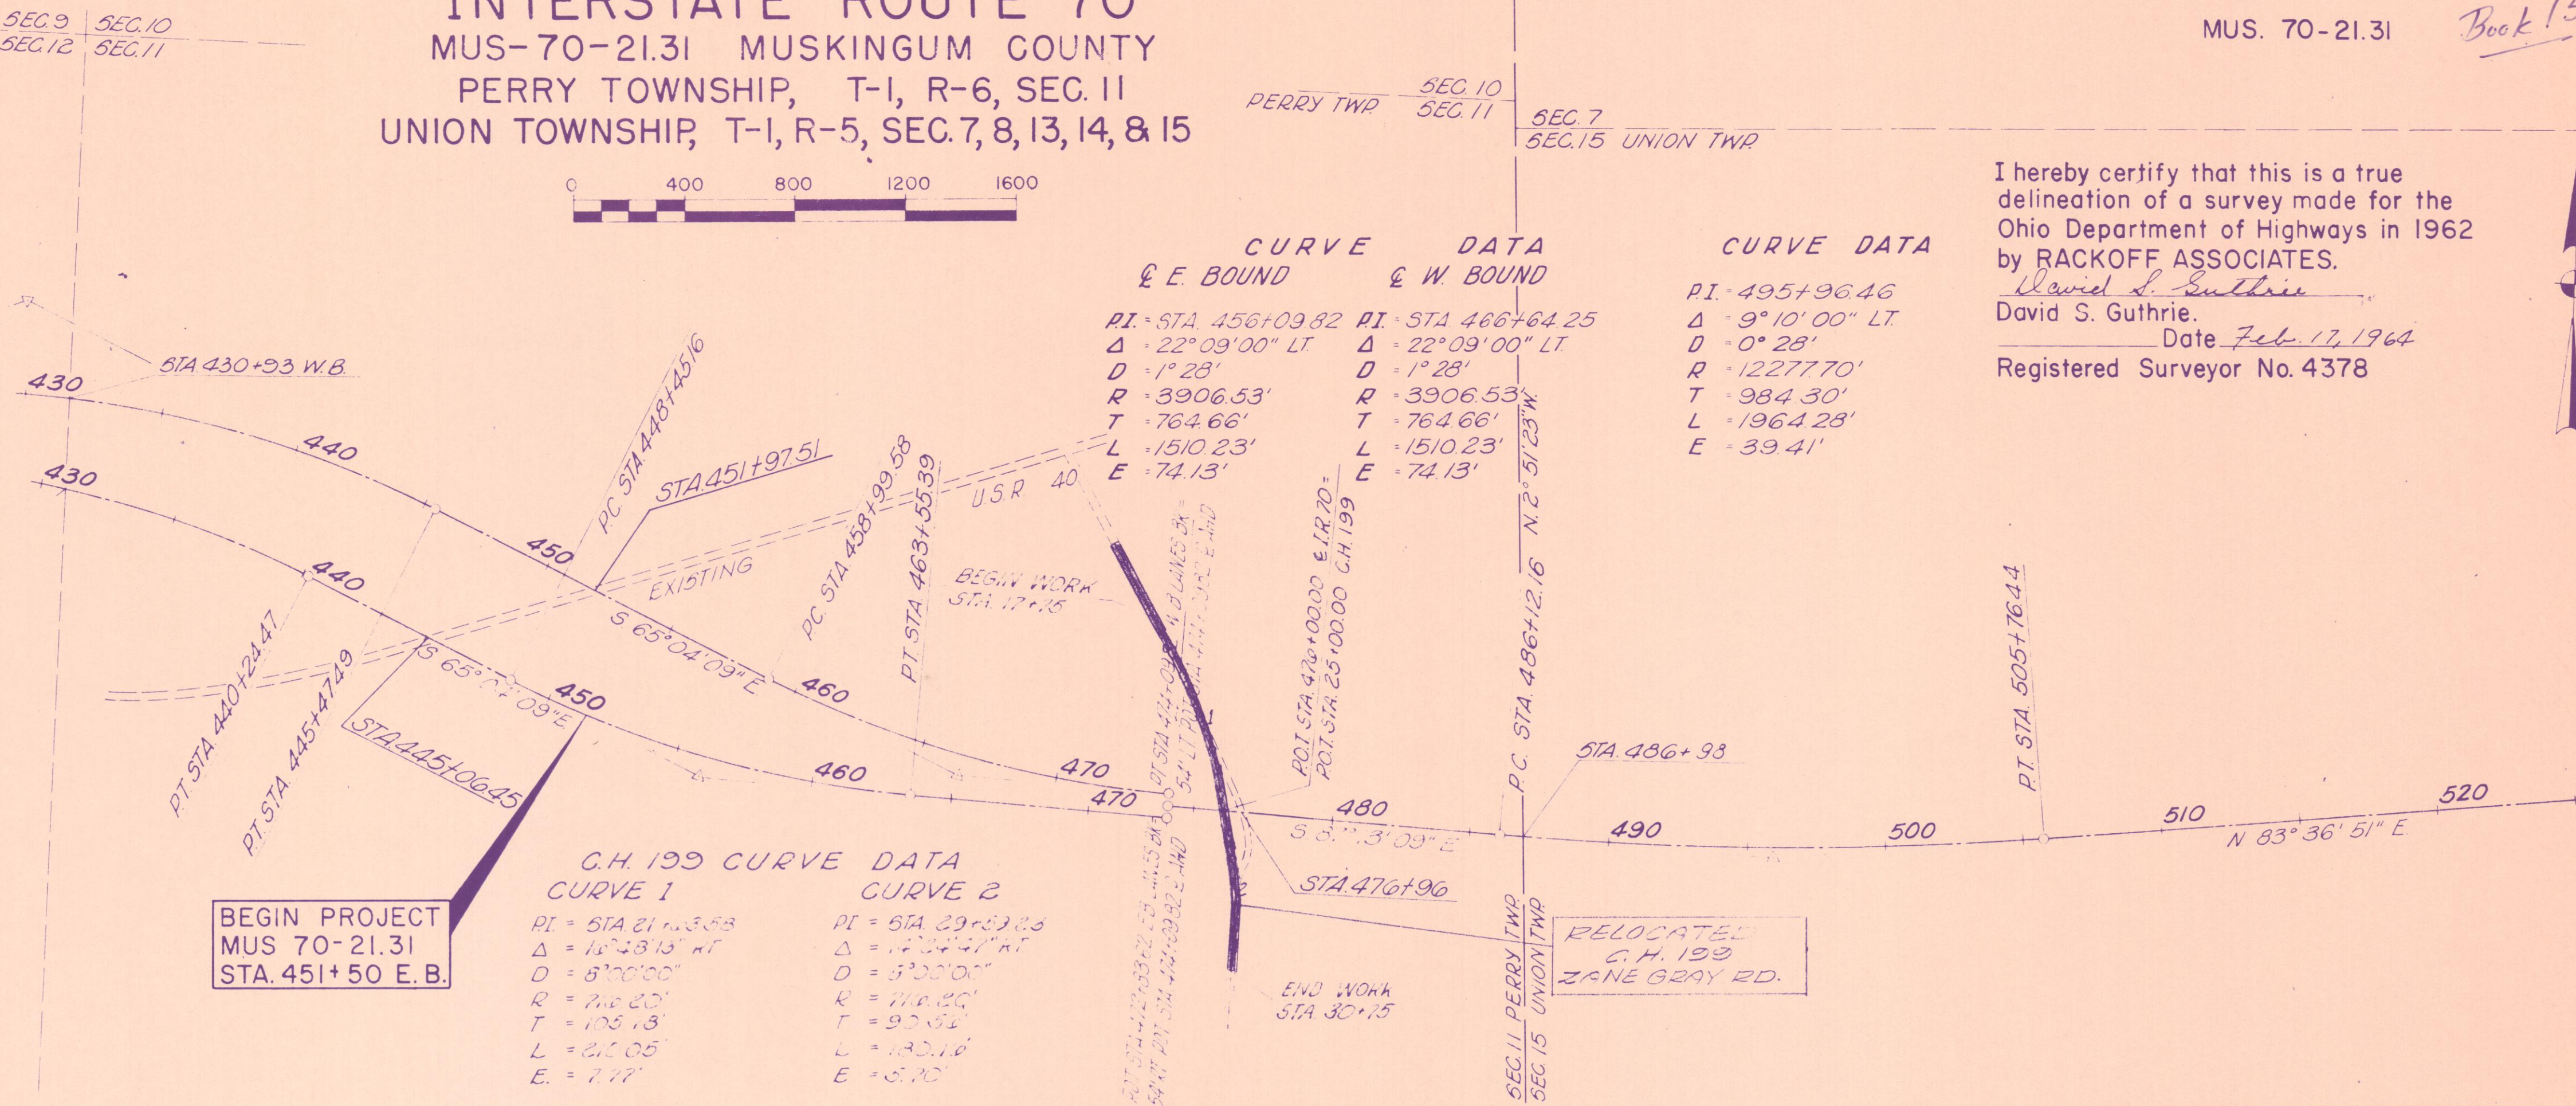

REV.	DATE	DESCRIPTION

COMPLETION DATE.	FEB. 17-64
------------------	------------