

6120

Received Dec 18, 1980 Time 2:19 P.M.
 Recorded Dec 18, 1980
 Plat Book 15 Page 102
 Signed David M. Muncie Recorder, Muskingum Co., Ohio
 Fee \$8.75

The shaded area of this plan approved and accepted by us this 13th day of October 1980 for maintenance and public use.

President, City Council of Zanesville, Ohio

I certify that the shaded area of this plan has been constructed according to the approved plan specification.

Date: 12/1/80
David M. Muncie
 District Deputy Director

I find that the section of road as shown by the shaded area has been constructed in a satisfactory manner and is in good repair.

Date: October 20, 1980
David M. Muncie
 Director of Public Services

LOCATION PLAN MUS~70~10.65, 11.52, 11.78 INTERSTATE~70 CITY OF ZANESVILLE

0' 200' 400' 600'
 SCALE IN FEET


LIMITED ACCESS

FHWA REGION	STATE	PROJECT	
5	OHIO		

MUSKINGUM COUNTY
 MUS~70~10.65, 11.52, 11.78

Plat Book 15

Pg. 102

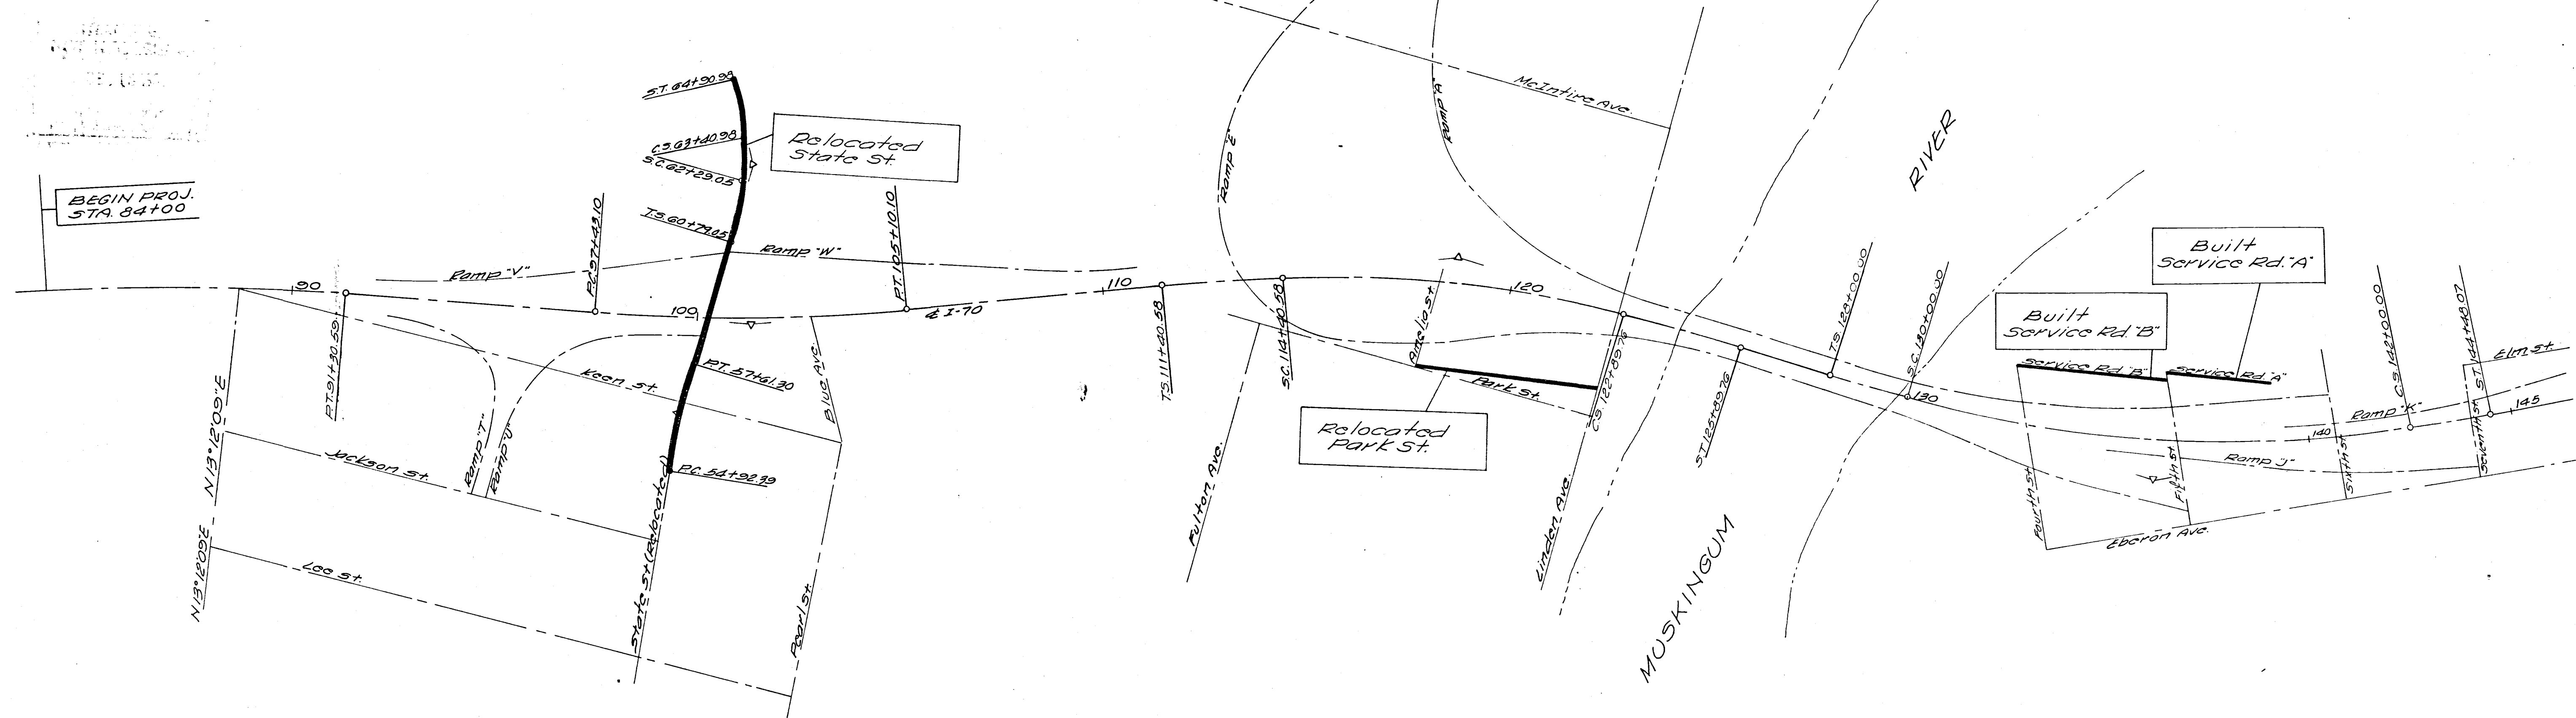

CURVE DATA

	I-70	I-70	I-70	I-70	STATE ST	STATE ST
PI	79+22.76	101+27.70	118+18.76	136+40.00	56+27.00	62+33.89
Δ	24°20'00"	9°35'15"	22°59'01"	25°57'41"	6°43'22"	31°25'52"
D	1°00'	1°15'	2°00'	2°00'	2°30'	12°00'
R	5729.58'	4583.66'	2864.79'	2864.79'	2291.83'	477.46'
Ls			300.00'	200.00'		150.00'
Tot Ts	1235.30'	324.40'	732.67'	840.00'	194.61'	209.84'
Lc	2433.33'	787.00'	849.13'	1243.07'	269.91'	111.93'
Os			3°00'	2°00'		9°00'
Xc			299.92'	199.98'		149.63'
Yc			5.24'	2.33'		7.84'
Eor Es	131.65'	16.09'	59.94'	94.60'	3.95'	20.58'