


MUS. 70-14.09
R/W PLAN
LIMITED ACCESS

Washington Co. Perry Twp.
 Sec 15, 3rd Qtr. T. 16 N. 5. M. E.

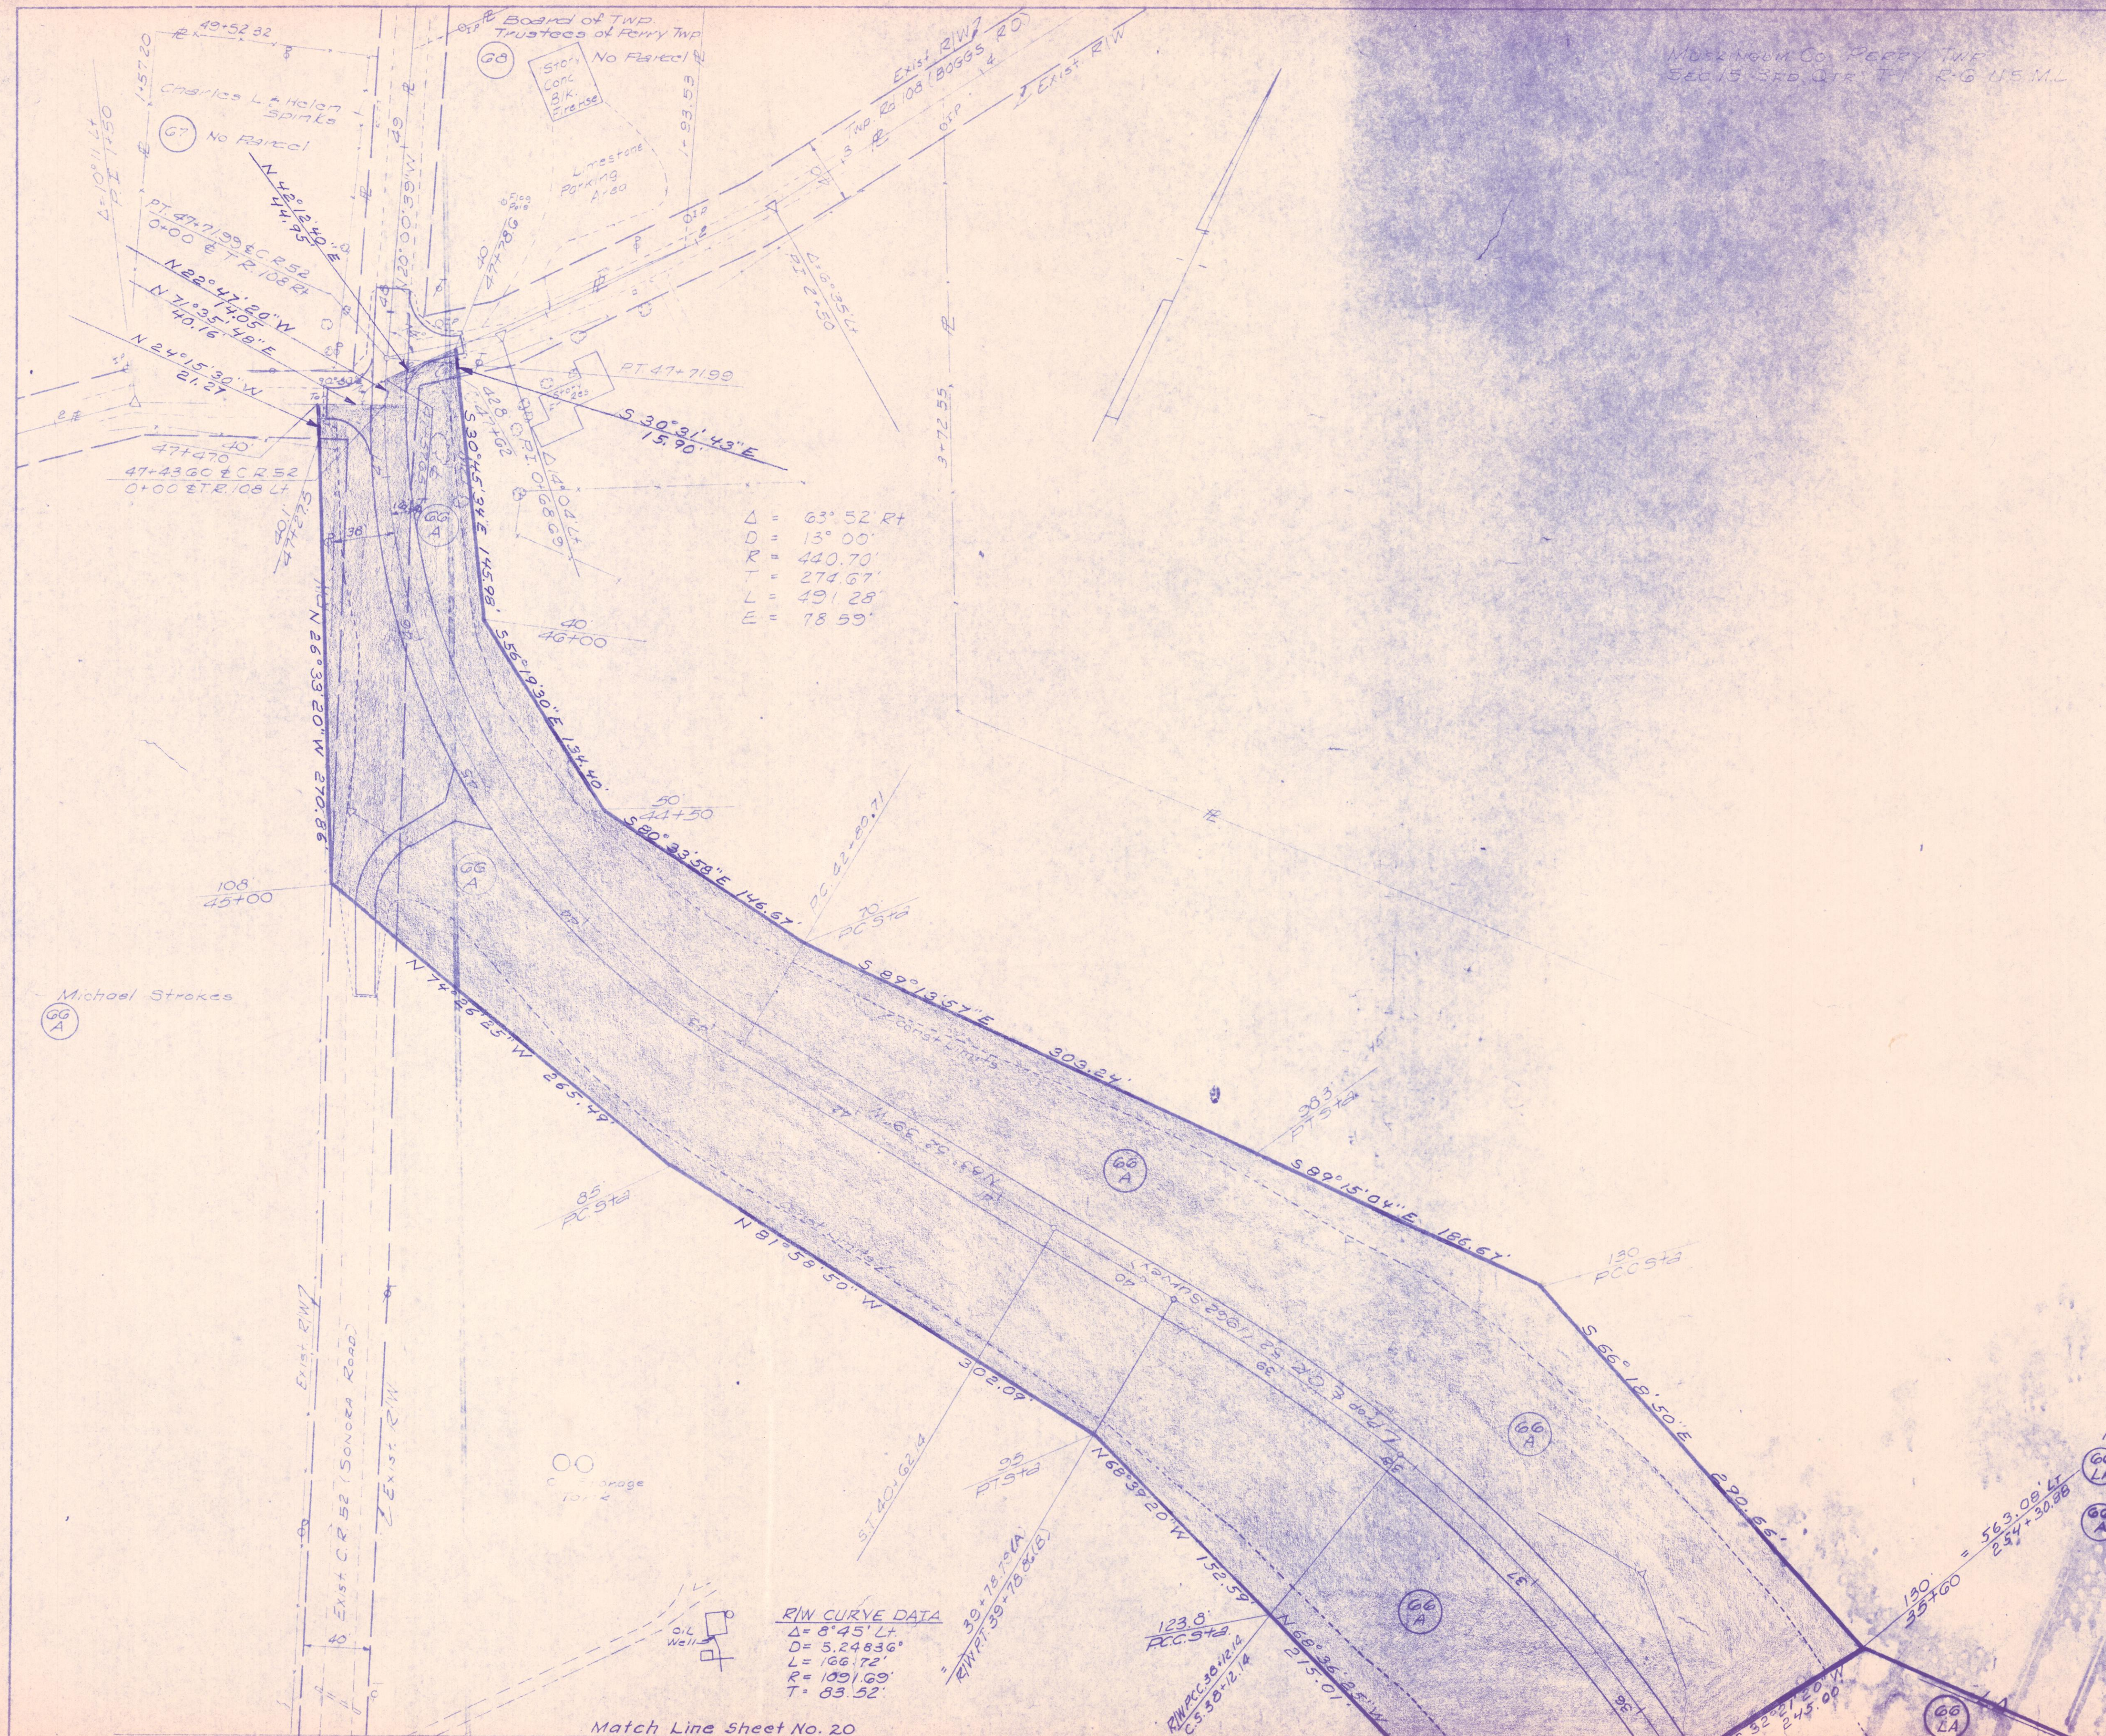

Δ = 63° 52' Rt
 D = 13° 00'
 R = 440.70'
 T = 274.67'
 L = 491.28'
 E = 78.59'

R/W CURVE DATA
 Δ = 8° 45' Lt
 D = 5.24836°
 L = 166.72'
 R = 1091.69'
 T = 83.52'

Note: Location Plan Recorded in Bk. 10,
 Pg. 58, Mus. Co. Plat. Rec.

Michael Strokes
 Cont. 52.77 Ac.±
 P.R.O. 0.31 Ac.±
 Cont. 4.57 Ac.±
 P.R.O. 0.30 Ac.±

Estimated Quantity
 SS-18 Fence 877 Lin. Ft.

Completion Date: 4-10-02		
Rev.	Date	Description
1	1-17-03	Par. 66-LA & 66-A

Match Line Sheet No. 20